



LEGACYPROPERTY

ORCHARD HILLS NORTH
STAGE 1
SUBDIVISION WORKS CERTIFICATE
PROPOSED LOT, ROAD AND DRAINAGE WORKS
DA 23/0969



LOCALITY SKETCH

WORKS AS EXECUTED AS SHOWN IN RED
NAME: - CRAIG S LONARD
SIGNATURE: *Craig S Lonard*
CAPACITY: - REGISTERED SURVEYOR #8800
DATE: 17.04.2025
CONTACT: ADMIN@HOGANCO.COM.AU

RHCO RICHARD HOGAN & CO.
SURVEYING & DEVELOPMENT CONSULTANTS

PENRITH CITY COUNCIL

This plan / document relates to

Development Consent: DA23/0969
Subdivision Works Certificate: EA24/0036.01

Subject to the conditions outlined in the consent

COUNCIL DOES NOT ATTEST TO THE ACCURACY OF DETAILS IN PLANS

Plotted: 13 November, 2024 3:47:46 PM File Name: C:\Synergy\WS\data\AS\JWP\07110265_09 - Precinct 1 Development_13533\Design\DD\Stage 1 SWC\110265-09-DD-001.dwg

C	FOR CONSTRUCTION	MMC	GA	MS	MS	27/09/24	
B	EXTENT OF WORKS UPDATED	MMC	GA	DG	CR	12/09/24	
A	ISSUE FOR TENDER	MMC	GA	MS		10/04/24	
	AMENDMENT	DES	DRN	CKD	APR	DATE	

J. WYNDHAM PRINCE
CONSULTING CIVIL INFRASTRUCTURE ENGINEERS & PROJECT MANAGERS

PO Box 4366 PENRITH WESTFIELD NSW 2750
P 02 4720 3300 W www.jwprince.com.au E jwp@jwprince.com.au

CLIENT:

STATUS:

ISSUE FOR CONSTRUCTION

THIS DRAWING MUST NOT BE USED FOR CONSTRUCTION UNLESS SIGNED AS PART OF AN APPROVED CONSTRUCTION CERTIFICATE.

ORCHARD HILLS NORTH
STAGE 1 CADDENS ROAD
COVER SHEET

PROJECT No:
110265-09

SHEET No:
DD1001

AZIMUTH: M.G.A. 2020

DATUM: A.H.D.

ORIGIN: SSM 1112

PLAN No: 110265-09-DD1001

C

Plotted: 13 November , 2024 3:47:48 PM File Name: C:\Synergy\W\data\AS\JWP07110265_09 - Precinct 1 Development_135323\Design\DD\Stage 1 SWC\110265-09-DD-001.dwg

LEGEND			
DESCRIPTION	PROPOSED	EXISTING	FUTURE
EXTENT OF WORKS			
KERB & GUTTER			
KERB RAMP			
DRAINAGE LINE, PIT & EASEMENT			
DRAINAGE LINE & PIT			
DRAINAGE LINE & PIT			
CONTOURS			
CATCH DRAIN			
EASEMENT			
ELECTRICITY, POWER POLE			
OVERHEAD ELECTRICITY, POWER POLE			
TELECOM (OPTUS), BOX			
TELECOM (TELSTRA), BOX			
TELECOM (OPTIC FIBRE), BOX			
WATER, STOP VALVE, HYDRANT			
SEWER, MANHOLE & MAINTENANCE CHAMBER			
GAS			
RECYCLED WATER			
RETAINING WALL			
STREET NAME SIGNS			
ROAD PAVEMENT			
1% AEP FLOOD EXTENT (DEVELOPED CONDITION)			
PROPERTY BOUNDARY			
SUBSTATION			
SPLIT LEVEL PRODUCT			
KERB RETURN NO.			
PROPOSED TREES			
TREES TO BE RETAINED			
TREES TO BE REMOVED			
STABILISED SITE ACCESS			
SEDIMENT FENCE			
STRAW BALE BARRIER			
STOCKPILE			
PROTECTIVE FENCING			
MESH AND GRAVEL INLET FILTER			
GEOTEXTILE INLET FILTER			
SUBSOIL DRAINAGE			
STREET SUBSOIL DRAINAGE			
BIORETENTION RAINGARDEN			
SEDIMENT FOREBAY			

GENERAL NOTES:

- ALL WORKS ARE TO BE IN ACCORDANCE WITH PENRITH CITY COUNCILS "DESIGN GUIDELINES FOR ENGINEERING WORKS FOR SUBDIVISIONS AND DEVELOPMENTS" & "ENGINEERING CONSTRUCTION SPECIFICATION FOR CIVIL WORKS".
- SURVEY MARKS:-
 - STATE SURVEY MARKS LOCATIONS TO BE FIXED BY PROJECT SURVEYOR DURING WORK AS EXECUTED SURVEY OF SUBDIVISION.
 - SURVEY MARKS SHOWN SHALL BE RETAINED AT ALL TIMES. WHERE RETENTION IS NOT POSSIBLE THE SUPERINTENDENT MUST BE NOTIFIED AND CONSENT RECEIVED PRIOR TO THEIR REMOVAL.
- THE CONTRACTOR SHALL LOCATE AND LEVEL ALL EXISTING SERVICES PRIOR TO COMMENCING CONSTRUCTION AND MAKE ARRANGEMENTS WITH THE RELEVANT AUTHORITY TO RELOCATE OR ADJUST IF NECESSARY.
- THE CONTRACTOR SHALL NOT ENTER UPON NOR DO ANY WORK WITHIN ADJACENT LANDS WITHOUT THE WRITTEN PERMISSION OF THE OWNERS. TO BE PROVIDED PRIOR TO THE APPROVAL OF THE PLANS.
- THE CONTRACTOR SHALL MAINTAIN SERVICES AND ALL WEATHER ACCESS AT ALL TIMES TO ADJOINING PROPERTIES.
- NO TREE SHALL BE FELLED, LOPPED OR REMOVED WITHOUT THE PRIOR APPROVAL OF COUNCIL'S ENGINEER.
- TREES TO BE RETAINED ON SITE SHALL BE PROTECTED BY SUITABLE STURDY APPROVED PROTECTIVE FENCING PRIOR TO COMMENCEMENT OF SITE WORKS.
- THE CONTRACTOR SHALL CLEAR THE SITE BY REMOVING ALL RUBBISH, FENCES OUT-HOUSES, CAR BODIES AND DEBRIS ETC.
- EXISTING SEDIMENT BASINS SHALL BE DEWATERED AND DESILTED. LEVELS SHALL BE OBTAINED ON SOUND MATERIAL PRIOR TO FILLING.
- FILLING IS TO BE FROM A NOMINATED SOURCE, OF SOUND CLEAN MATERIAL, FREE FROM LARGE ROCK, STUMPS, CONTAMINATED MATTER, INDUSTRIAL AND BUILDING WASTE, ORGANIC MATTER AND OTHER DEBRIS. PLACING OF FILLING ON THE PREPARED AREAS SHALL NOT COMMENCE UNTIL THE AUTHORITY TO DO SO HAS BEEN OBTAINED FROM THE COUNCIL.
- SITE FILL AREAS- THE CONTRACTOR SHALL TAKE LEVELS OF EXISTING SURFACE AFTER STRIPPING TOPSOIL AND PRIOR TO COMMENCING FILL OPERATIONS
- ALL SITE FILLING TO BE COMPACTED TO 95% STANDARD COMPACTION AND SHALL BE CONTROLLED BY A REGISTERED SOIL LABORATORY IN ACCORDANCE WITH COUNCIL'S "ENGINEERING CONSTRUCTION SPECIFICATION FOR CIVIL WORKS".
- ALL SITE REGRADING AREAS SHALL BE GRADED AT A MINIMUM 1% TO THE ENGINEERS' REQUIREMENTS.
- SURPLUS EXCAVATED MATERIAL SHALL BE PLACED WHERE DIRECTED BY THE SUPERINTENDENT.
- EASEMENT WIDTHS SHALL BE IN ACCORDANCE WITH 3.11 DRAINAGE EASEMENTS OF PENRITH CITY COUNCIL'S DESIGN GUIDELINES FOR ENGINEERING WORKS FOR SUBDIVISION AND DEVELOPMENTS.

PIPE DIA.	EASEMENT WIDTH
150Ø	1.5m
225Ø	2.0m
300Ø	2.0m
375Ø	2.5m
450Ø	2.5m
545Ø	2.5m
600Ø	2.5m
675Ø	3.0m
- DRAINAGE LINES UNDER ROADS SHALL BE BACKFILLED WITH NON-COHESIVE SAND AND HAVE 3m OF SUBSOIL DRAIN WRAPPED IN APPROVED FILTER SOCK, DISCHARGING INTO DOWN STREAM PITS.
PIPE CLASS INDICATED ARE FOR REINFORCED CONCRETE PIPES (RCP)
IF FIBRE REINFORCED CONCRETE PIPES (FRC) REFER TO PENRITH CITY COUNCIL "ENGINEERING CONSTRUCTION SPECIFICATION FOR CIVIL WORKS"
- ALL CONDUITS AND MAINS SHALL BE LAID PRIOR TO LAYING FINAL ASPHALTIC CONCRETE SEAL.
- VEHICULAR CROSSINGS SHALL BE CONSTRUCTED IN KERB AND GUTTER WHERE SHOWN IN ACCORDANCE WITH PCC STANDARD DRAWING SD1004.
- PRAM CROSSINGS SHALL BE CONSTRUCTED IN KERB AND GUTTER IN ACCORDANCE WITH COUNCIL'S STANDARD DRAWING SD1002.
- STREET NAME SIGNS SHALL BE ERCTED, WHERE SHOWN, IN ACCORDANCE WITH COUNCIL'S STANDARD SD1008/1 AND SD1008/2.
- ALL NEW WORKS SHALL MAKE A SMOOTH JUNCTION WITH EXISTING CONDITIONS.
- ALL INTERALLOTMENT DRAINAGE LINES SHALL BE LAID AT A MINIMUM GRADE OF 1% UNLESS OTHERWISE INDICATED.
- DRAINAGE LINES ON PLANS ARE DIAGRAMMATIC ONLY AND PIPE CENTRELINES SHALL ENTER AND EXIT PITS AT THE CENTRE OF THE RESPECTIVE PIT WALLS.
- DIMENSIONS OF ANY DETAIL SHALL NOT BE SCALED - DIMENSIONS, IF IN DOUBT, SHALL BE VERIFIED BY THE SUPERINTENDENT.
- ALL CONSTRUCTION AND RESTORATION WORK ON COUNCIL'S ROAD AND FOOTPATH AREA ARE TO BE CARRIED OUT IN ACCORDANCE WITH THE APPROVED DRAWINGS AND COUNCIL'S STANDARD SPECIFICATIONS AND APPROVED BY PENRITH CITY COUNCIL THROUGH A S138 ROADS ACT APPROVAL.
- ALL LAND THAT HAS BEEN DISTURBED BY EARTHWORKS IS TO BE SPRAY GRASSED OR SIMILARLY TREATED TO ESTABLISH A GRASS COVER.
- NO FILL MATERIAL IS TO BE IMPORTED TO THE SITE WITHOUT THE PRIOR APPROVAL OF PCC IN ACCORDANCE WIT H SYDNEY REGIONAL ENVIRONMENTAL PLAN No.20 (HAWKESBURY-NEPEAN RIVER) (No.2-1997). NO RECYCLING OF MATERIAL FOR USE OF FILL MATERIAL SHALL BE CARRIED OUT ON THE SITE WITHOUT THE PRIOR APPROVAL OF COUNCIL.
- ALL EARTHWORKS SHALL BE UNDERTAKEN IN ACCORDANCE WITH AS3798 AND PCC DESIGN GUIDELINES FOR ENGINEERING WORKS FOR SUBDIVISIONS AND DEVELOPMENTS AND ENGINEERING CONSTRUCTION SPECIFICATIONS FRO CIVIL WORKS.
- VEHICLE CROSSINGS TO BE LOCATED 1.0m CLEAR OF ANY LINTELS.
- ALL VERGE AREAS EXTEND FROM BACK OF KERB TO PROPERTY BOUNDARY TO BE TURFED.
- ALL STORMWATER PITS WITH DEPTHS GREATER THAN 1.0m TO HAVE GALVANISED OR OTHERWISE APPROVED STEP IRONS AT 300mm SPACING INSTALLED.
- KERB TYPES USED IN SITE ARE KERB AND GUTTER UNLESS OTHERWISE NOTED. FOR DETAILS REFER TO PENRITH CITY COUNCIL "ENGINEERING CONSTRUCTION SPECIFICATION FOR CIVIL WORKS" STANDARD SD1003/1 & SD1003/2.
- KERB ADAPTORS SHALL BE PROVIDED FOR ALL LOTS DRAINING TO THE STREET. FOR DETAIL REFER TO PENRITH CITY COUNCIL "ENGINEERING CONSTRUCTION SPECIFICATION FOR CIVIL WORKS"
- ALL WASTE MATERIAL STORED ON-SITE ARE TO BE CONTAINED WITHIN A DESIGNATED AREA SUCH AS A WASTE BAY OR BIN. CONTRACTOR TO ENSURE THAT NO WASTE MATERIALS ARE ALLOWED TO ENTER THE STORMWATER SYSTEM OR NEIGHBOURING PROPERTIES. THE DESIGNATED WASTE STORAGE AREAS SHALL PROVIDE AT LEAST TWO WASTE BAY/BINS SO AS TO ALLOW FOR THE SEPARATION OF WASTES, AND ARE TO BE FULLY ENCLOSED WHEN SITE IS UNATTENDED.
- AN APPROPRIATE QUALIFIED PERSON/S SHALL SUPERVISE ALL FILLING WORKS.

SURVEY SET OUT INFORMATION NOTES:

- ALL SITE SET OUT AND CONTROL POINTS ARE TO BE CERTIFIED BY A REGISTERED SURVEYOR.
 - THE INFORMATION DETAILED ON THE CERTIFIED CONSTRUCTION CERTIFICATE PLANS TAKES PRECEDENCE OVER ALL ELECTRONIC INFORMATION PROVIDED. THE ORDER OF PRIORITY FOR USE OF ALL INFORMATION PROVIDED IS AS FOLLOWS:
 - CERTIFIED CONSTRUCTION CERTIFICATE DRAWINGS
 - 2D DRAFTING BASE (ELECTRONIC FILE)
 - 3D DTM (ELECTRONIC FILE)
 - ANY DISCREPANCY BETWEEN ANY OF THE INFORMATION CONTAINED WITHIN THESE FILES IS TO BE BROUGHT TO THE ATTENTION OF THE SUPERINTENDENT PRIOR TO CONSTRUCTION WHO WILL SEEK CLARIFICATION AND ISSUE INSTRUCTIONS ON THE APPROPRIATE COURSE OF ACTION.
- ### CUSTOM MADE PRECAST PIT NOTES:
- DESIGN DOCUMENTATION REFLECTS PRECAST DRAINAGE PITS BEING USED FOR THE SITE. UNLESS NOTED OTHERWISE.
 - AUSPITS CUSTOM MADE PRECAST PITS TO BE USED.
 - PITS TO COMPLY WITH THE FOLLOWING PARAMETERS:
 - ARE SPECIFICALLY MANUFACTURED FOR THE PROJECT.
 - EACH PIT IS ACCOMPANIED BY A CERTIFICATE OF STRUCTURAL ADEQUACY SIGNED BY A NPER ENGINEER (STRUCTURAL)
 - THE STRUCTURAL CERTIFICATION OF THE PITS SHOULD INCLUDE ANY ADDITIONAL PRECAST ELEMENTS REQUIRED TO BRING THE PIT UP TO FINAL LEVELS ON SITE.
 - PITS MUST BE FIRMLY BEDDED ON SOUND MATERIAL.
 - CONCRETE IS TO BE POURED AROUND THE BASE TO AID IN STABILISATION OF THE PIT.
 - PIT FLOORS ARE TO HAVE A 1% FALL TOWARDS THE OUTLET PIPE.
 - ANY PIT REQUIRING MODIFICATION AFTER IT HAS BEEN POURED IN THE FACTORY OR DAMAGED IN TRANSPORT CANNOT BE USED.
 - ALL WORK TO BE TO THE SATISFACTION OF COUNCIL'S DEVELOPMENT INSPECTORS.

IT IS THE CONTRACTORS RESPONSIBILITY TO PROVIDE DETAILED PIT DRAWINGS AND STRUCTURAL CERTIFICATION IF INSITU PITS ARE TO BE CONSTRUCTED.

Combined Survey By:

VINCE MORGAN (SURVEYORS) PTY. LTD.
CONSULTING SURVEYORS
P.O. Box 227, Penrith. 2751
Ph. (02) 4721 5293

Date: 12/01/23 EXISTING ELVIS DATA
Date: 27/07/23 File Name: EXISTING DETAIL SURVEY 24615T

RICHARD HOGAN & CO. PTY. LTD.
SURVEYING & DEVELOPMENT CONSULTANTS
Unit 41, 37 – 47 Borec Road
Penrith NSW 2750
Ph. (02) 4732 6599

Date: 23/08/17 File Name: EXISTING DETAIL SURVEY STAGE
1-3 INTERNAL 230817

WORKS AS EXECUTED AS SHOWN IN RED
NAME: - CRAIG S LONARD
SIGNATURE:
CAPACITY: - REGISTERED SURVEYOR #8800
DATE: 17.04.2025
CONTACT: ADMIN@HOGANCO.COM.AU

RHCO RICHARD HOGAN & CO.
SURVEYING & DEVELOPMENT CONSULTANTS



CIVIL PLAN INDEX		
PLAN NO.	PLAN NAME	REV
110265-09-DD1001	COVER SHEET	C
110265-09-DD1002	INDEX, NOTES & LEGEND	D
110265-09-DD1003	OVERALL SITE LAYOUT	C
110265-09-DD1004	SETOUT PLAN	C
110265-09-DD1005	PAVEMENT PLAN	C
110265-09-DD1006	TYPICAL SECTIONS	C
110265-09-DD1016	CUT & FILL PLAN DESIGN TO BULK EARTHWORKS	C
110265-09-DD1018	SITE SECTIONS SHEET 1	C
110265-09-DD1019	SITE SECTIONS SHEET 2	C
110265-09-DD1020	SITE SECTIONS SHEET 3	C
110265-09-DD1050	ENGINEERING PLAN SHEET 1	C
110265-09-DD1051	ENGINEERING PLAN SHEET 2	D
110265-09-DD1100	ROAD LONGITUDINAL SECTIONS SHEET 1	C
110265-09-DD1101	ROAD LONGITUDINAL SECTIONS SHEET 2	C
110265-09-DD1102	ROAD LONGITUDINAL SECTIONS SHEET 3	C
110265-09-DD1200	ROAD CROSS SECTIONS SHEET 1	C
110265-09-DD1201	ROAD CROSS SECTIONS SHEET 2	C
110265-09-DD1202	ROAD CROSS SECTIONS SHEET 1	C
110265-09-DD1203	ROAD CROSS SECTIONS SHEET 2	C
110265-09-DD1300	KERB RETURNS SHEET 1	D
110265-09-DD1301	KERB RETURNS SHEET 2	C
110265-09-DD1400	CATCHMENT PLAN SHEET 1	D
110265-09-DD1402	PIT SCHEDULE	D
110265-09-DD1450	DRAINAGE LONGITUDINAL SECTIONS SHEET 1	C
110265-09-DD1451	DRAINAGE LONGITUDINAL SECTIONS SHEET 2	C
110265-09-DD1452	DRAINAGE LONGITUDINAL SECTIONS SHEET 3	D
110265-09-DD1453	DRAINAGE LONGITUDINAL SECTIONS SHEET 4	C
110265-09-DD1454	DRAINAGE LONGITUDINAL SECTIONS SHEET 5	D
110265-09-DD1500	DRAINAGE CALCULATIONS SHEET 1	C
110265-09-DD1501	DRAINAGE CALCULATIONS SHEET 2	C
110265-09-DD1502	DRAINAGE CALCULATIONS SHEET 3	C
110265-09-DD1503	DRAINAGE CALCULATIONS SHEET 4	C
110265-09-DD1530	RAINGARDEN PLAN	C
110265-09-DD1531	RAINGARDEN CROSS SECTIONS	C
110265-09-DD1532	RAINGARDEN ACCESS LONG SECTION	B
110265-09-DD1550	SOIL & WATER MANAGEMENT PLAN	D
110265-09-DD1551	SOIL & WATER MANAGEMENT NOTES	C
110265-09-DD1600	RETAINING WALL PLAN & LONGITUDINAL SECTIONS SHEET 1	D
110265-09-DD1601	RETAINING WALL PLAN & LONGITUDINAL SECTIONS SHEET 2	D
110265-09-DD1602	RETAINING WALL PLAN & LONGITUDINAL SECTIONS SHEET 3	D
110265-09-DD1603	RETAINING WALL PLAN & LONGITUDINAL SECTIONS SHEET 4	D
110265-09-DD1604	RETAINING WALL PLAN & LONGITUDINAL SECTIONS SHEET 5	D
110265-09-DD1605	RETAINING WALL PLAN & LONGITUDINAL SECTIONS SHEET 6	D
110265-09-DD1606	RETAINING WALL PLAN & LONGITUDINAL SECTIONS SHEET 7	D
110265-09-DD1607	RETAINING WALL PLAN & LONGITUDINAL SECTIONS SHEET 8	D
110265-09-DD1608	RETAINING WALL PLAN & LONGITUDINAL SECTIONS SHEET 9	D
110265-09-DD1609	RETAINING WALL PLAN & LONGITUDINAL SECTIONS SHEET 10	C
110265-09-DD1610	RETAINING WALL PLAN & LONGITUDINAL SECTIONS SHEET 11	C
110265-09-DD1611	RETAINING WALL PLAN & LONGITUDINAL SECTIONS SHEET 12	C
110265-09-DD1612	RETAINING WALL PLAN & LONGITUDINAL SECTIONS SHEET 13	C
110265-09-DD1650	SIGNAGE & LINEMARKING PLAN SHEET 1	C
110265-09-DD1651	SIGNAGE & LINEMARKING PLAN SHEET 2	C
110265-09-DD1800	TURNING PATHS	B
110265-09-DD1700	DEMOLITION PLAN	C
110265-09-DD1800	TREE PLAN	C
110265-09-DD1820	CONTROLLED ACTIVITY APPROVAL WORKS PLAN	C
110265-09-DD1830	ULTIMATE RAINGARDEN PLAN	A
110265-09-DD1831	GPT DETAILS	A

UTILITIES SHOWN ARE DIAGRAMMATIC ONLY, CONTRACTORS ARE RESPONSIBLE TO LOCATE AND AVOID DAMAGE TO THEM AS SPECIFIED BY EACH UTILITIES EXCAVATION GUIDE LINES & STANDARDS.

NOTE: UTILITIES SHOWN MAY NOT INCLUDE ALL SERVICES WITHIN THE LIMIT OF WORKS

D	PLAN INDEX UPDATED	MMC	GA	MS	MS	11/11/24
C	PLAN INDEX UPDATED	MMC	GA	MS	MS	27/09/24
B	LEGEND, PLAN INDEX UPDATED	MMC	GA	DG	CR	12/09/24
A	ISSUE FOR TENDER	MMC	GA	MS		10/04/24
	AMENDMENT	DES	DRN	CKD	APR	DATE

J. WYNDHAM PRINCE
CONSULTING CIVIL INFRASTRUCTURE ENGINEERS & PROJECT MANAGERS

PO Box 4366 PENRITH WESTFIELD NSW 2750
P 02 4720 3300 W www.jwprince.com.au E jwp@jwprince.com.au



CLIENT:

STATUS:

ISSUE FOR CONSTRUCTION

THIS DRAWING MUST NOT BE USED FOR CONSTRUCTION UNLESS SIGNED AS PART OF AN APPROVED CONSTRUCTION CERTIFICATE.

ORCHARD HILLS NORTH
STAGE 1 CADDENS ROAD
INDEX, NOTES & LEGEND

PROJECT No:

110265-09

SHEET No:

DD1002

AZIMUTH:

M.G.A.
2020


DATUM: A.H.D.

ORIGIN: SSM 1112

PLAN No:

110265-09-DD1002

D

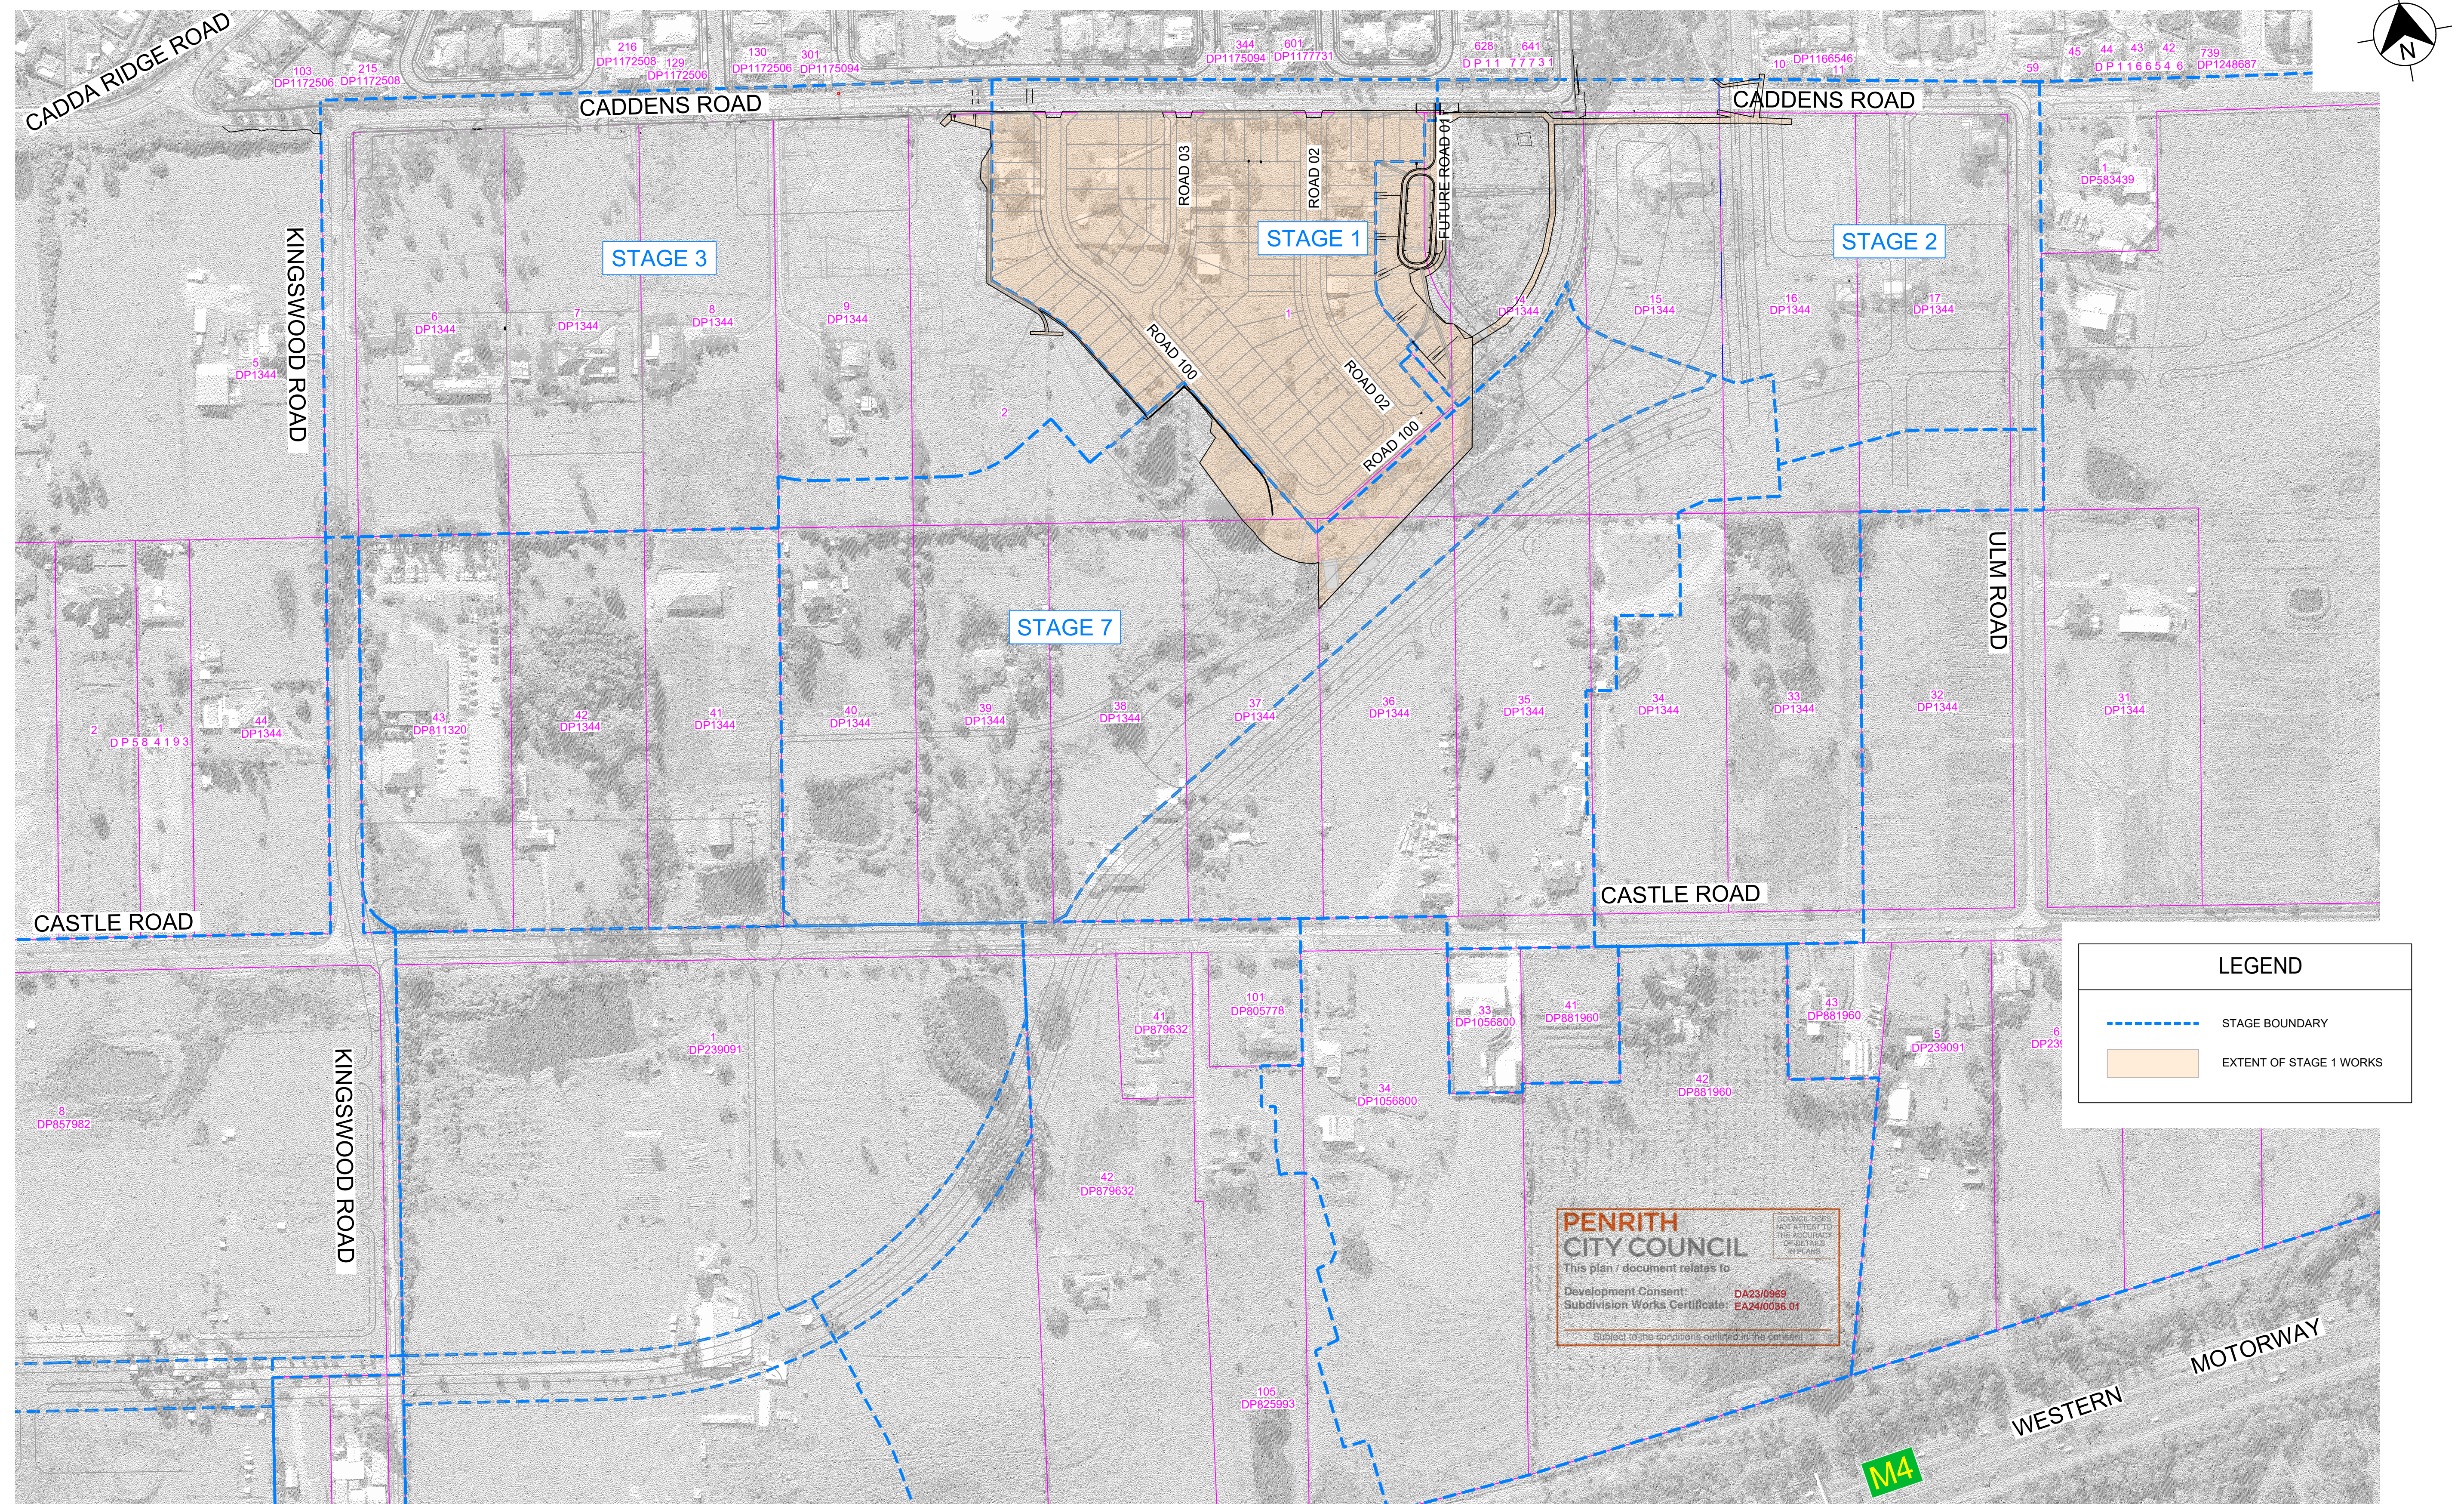

WORKS AS EXECUTED AS SHOWN IN RED
NAME: - CRAIG S LONARD
SIGNATURE: 
CAPACITY: - REGISTERED SURVEYOR #8800
DATE: 17.04.2025
CONTACT: ADMIN@HOGANCO.COM.AU

RHCO RICHARD HOGAN & CO.
SURVEYING & DEVELOPMENT CONSULTANTS

C	FOR CONSTRUCTION	MMC	GA	MS	MS	27/09/24
B	L.O.W. UPDATED	MMC	GA	DG	CR	12/09/24
A	ISSUE FOR TENDER	MMC	GA	MS		10/04/24
	AMENDMENT	DES	DRN	CKD	APR	DATE

J. WYNDHAM PRINCE
CONSULTING CIVIL INFRASTRUCTURE ENGINEERS & PROJECT MANAGERS

PO Box 4366 PENRITH WESTFIELD NSW 2750
P 02 4720 3300 W www.jwprince.com.au E jwp@jwprince.com.au

CLIENT:



LEGACYPROPERTY

STATUS:

ISSUE FOR CONSTRUCTION

THIS DRAWING MUST NOT BE USED FOR CONSTRUCTION UNLESS
SIGNED AS PART OF AN APPROVED CONSTRUCTION CERTIFICATE.


ORCHARD HILLS NORTH
STAGE 1 CADDENS ROAD
OVERALL SITE LAYOUT

PROJECT No:
110265-09

SHEET No:
DD1003

AZIMUTH: M.G.A. 2020	DATUM: A.H.D.	ORIGIN: SSM 1112	PLAN No: 110265-09-DD1003	C
-------------------------	---------------	------------------	---------------------------	---

1

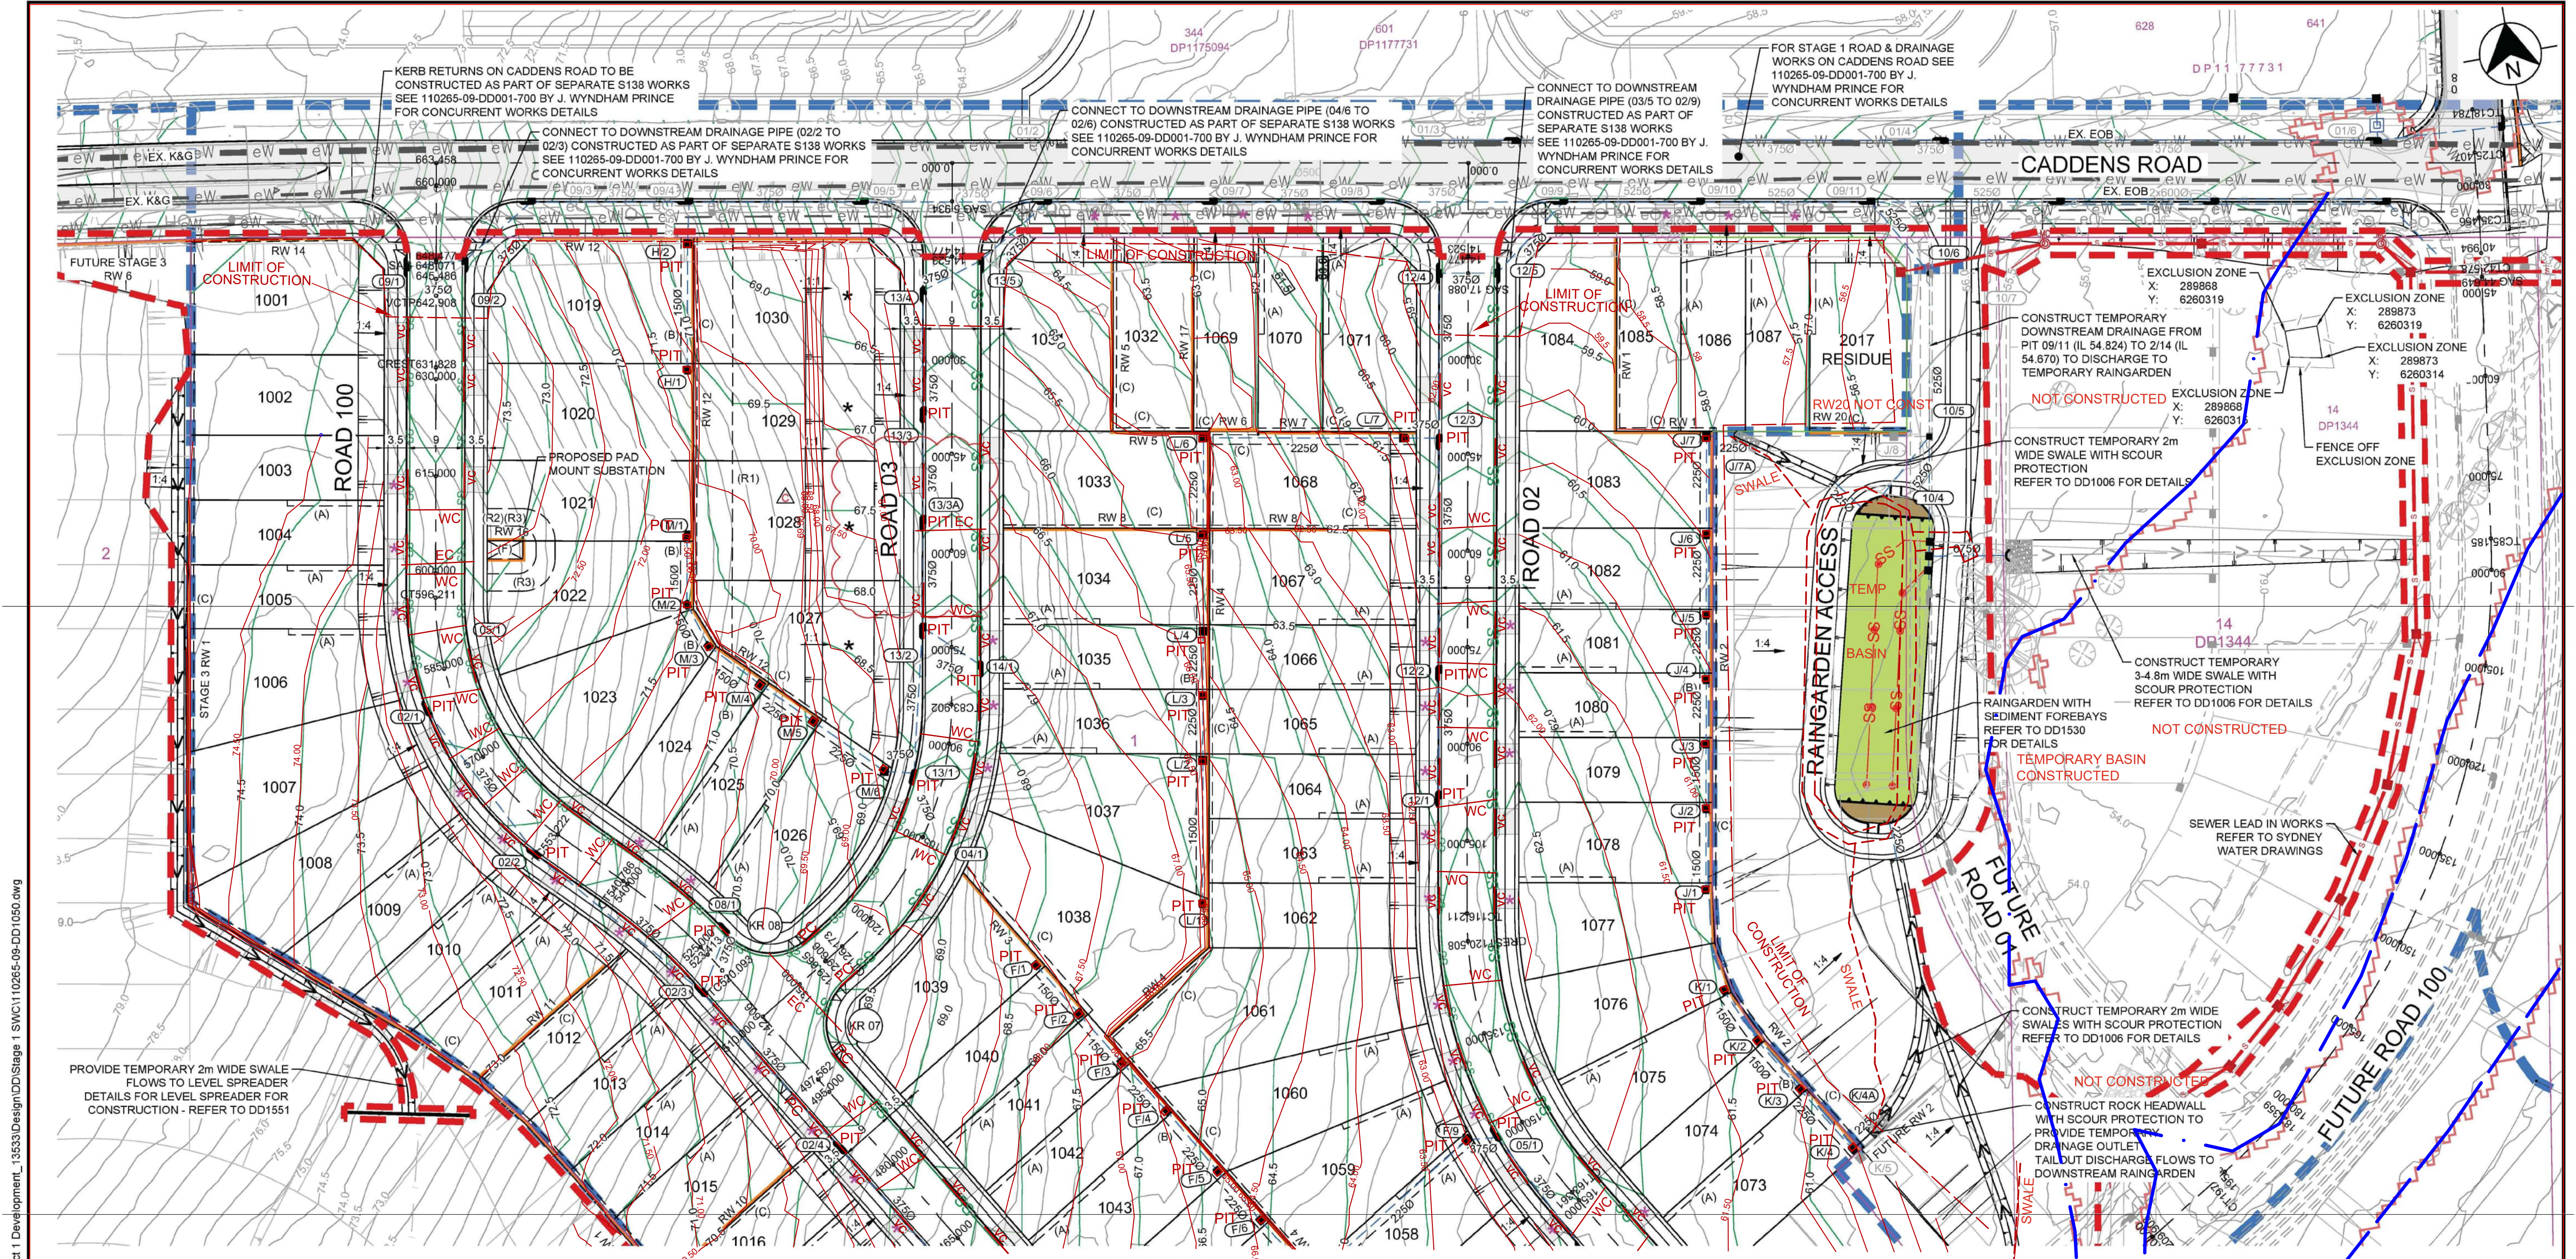

REFER TO DD1051 FOR CONTINUATION

- NOTES:
1. ALL NEW WORKS TO SAWCUT & MAKE SMOOTH CONNECTION TO EXISTING ROAD PAVEMENT.
 2. ALL KERB RETURNS ARE 8.5m RADII UNO. REFER TO DRG DD1300-1301 FOR DETAILS
 3. REFER TO DD1006 FOR TYPICAL ROAD DETAILS
 4. ALL EXISTING STORMWATER PITS AND PIPES THAT DO NOT FORM PART OF THE PROPOSED STORMWATER SYSTEM IS TO BE DEMOLISHED AND DISPOSED OF.
 5. ALL BATTERS SHOWN ARE 1:4 UNLESS NOTED OTHERWISE.

- NOTES:
6. FOR PROPOSED TREE REMOVAL AND RETENTION LOCATION REFER TO DD1700 FOR DEMOLITION PLAN
 7. ALL VEHICULAR CROSSING (VC) WIDTHS ARE 4.0m WIDE UNLESS OTHERWISE NOTED ON PLAN. VC'S TO BE IN ACCORDANCE WITH COUNCIL STANDARD DRAWING SD1004 OF P.C.C SPECIFICATION FOR CIVIL WORKS. 3.0m WIDE DRIVEWAYS ARE NOTED WITH *
 8. CONSTRUCT KERB INLET PITS TO COUNCIL STANDARD DRAWING SD2001. INSTALL SL82 MESH IN ALL KERB INLET PIT WALLS AND FLOOR WHERE PIT DEPTH >1.5m
 9. FOR RETAINING WALL PLANS & DETAILS SEE DRAWINGS DD1600-1608

- NOTES:
10. RETAINING WALLS ARE 1.5m MAX HEIGHT UNLESS OTHERWISE SHOWN. REFER TO DD1600-1612 FOR DETAILS
 11. FOR COMPACTION SPECIFICATIONS REFER TO GEOTECHNICAL REPORT
 12. PLANS ARE TO BE READ IN CONJUNCTION WITH ARCHITECT'S PLANS AND LANDSCAPE ARCHITECT'S PLANS
 13. ALL INTERALLOTMENT DRAINAGE EASEMENT WIDTHS TO BE IN ACCORDANCE WITH THE P.C.C. DESIGN GUIDELINES. 150-2250 PIPES SHALL HAVE 2m WIDE EASEMENTS WHERE THE PIPE IS ADJACENT TO A RETAINING WALL.


- NOTES:
14. ALL PRAM RAMPS TO BE CONSTRUCTED TO P.C.C. SPECIFICATION FOR CIVIL WORKS DRAWING SD1002
 15. ACCESS TO EXISTING DWELLINGS IS TO BE MAINTAINED AT ALL TIMES.

WORKS AS EXECUTED AS SHOWN IN RED
NAME: CRAIG S LONARD
SIGNATURE: *Craig S Lonard*
CAPACITY: REGISTERED SURVEYOR #8800
DATE: 17.04.2025 & 09.05.2025
CONTACT ADMIN@HOGANCO.COM.AU

- (A) PROPOSED EASEMENT FOR ACCESS & MAINTENANCE 0.9 WIDE
(B) PROPOSED EASEMENT TO DRAIN WATER 2.0 WIDE
(C) PROPOSED EASEMENT FOR RETAINING WALL SUPPORT 0.5 WIDE
(F) PROPOSED EASEMENT FOR PADMOUNT SUBSTATION 2.75 WIDE
(R1) PROPOSED RESTRICTION ON THE USE OF LAND 6 WIDE
(R2) PROPOSED RESTRICTION ON THE USE OF LAND (FIRE RATING)
(R3) PROPOSED RESTRICTION ON THE USE OF LAND (SWIMMING POOL)

PENRITH CITY COUNCIL
This plan / document relates to:
Development Consent: DA23/0969
Subdivision Works Certificate: EA24/0036.01
Subject to the conditions outlined in the consent

--- DENOTES 1 IN 100 YEAR FLOOD LEVEL LOCATION FROM JWP SWC DRAWING DATED 24.10.2022

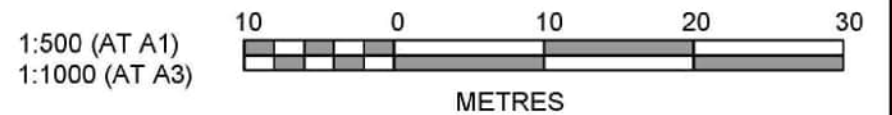

AMENDMENT	DES	DRN	CKD	APR	DATE
C	PIT 13/3 A ADDED	MMC	GA	MS	27/09/24
B	BATTERS, DRAINAGE, WALLS, EASEMENTS, CONTOURS, NOTES UPDATED	MMC	GA	DG	12/09/24
A	ISSUE FOR TENDER	MMC	GA	MS	09/04/24

J. WYNDHAM PRINCE
CONSULTING CIVIL INFRASTRUCTURE ENGINEERS & PROJECT MANAGERS
PO Box 4366 PENRITH WESTFIELD NSW 2750
P 02 4720 3300 W www.jwprince.com.au E jwp@jwprince.com.au


CLIENT: **LEGACYPROPERTY**

STATUS: **ISSUE FOR CONSTRUCTION**
THIS DRAWING MUST NOT BE USED FOR CONSTRUCTION UNLESS SIGNED AS PART OF AN APPROVED CONSTRUCTION CERTIFICATE

ORCHARD HILLS NORTH
STAGE 1 CADDENS ROAD
ENGINEERING PLAN
SHEET 1
AZIMUTH: M.G.A. 2020
DATUM: A.H.D.
ORIGIN: SSM 1112
PLAN No: 110265-09-DD1050

PROJECT No: **110265-09**
SHEET No: **DD1050**
C

Plotted: 11 November, 2024 1:52:36 PM File Name: C:\Synergy\WSD\JWP\04110265-09 - CHN Development Application_13533\Design\DD\Stage1_SWC110265-09-DD1050.dwg

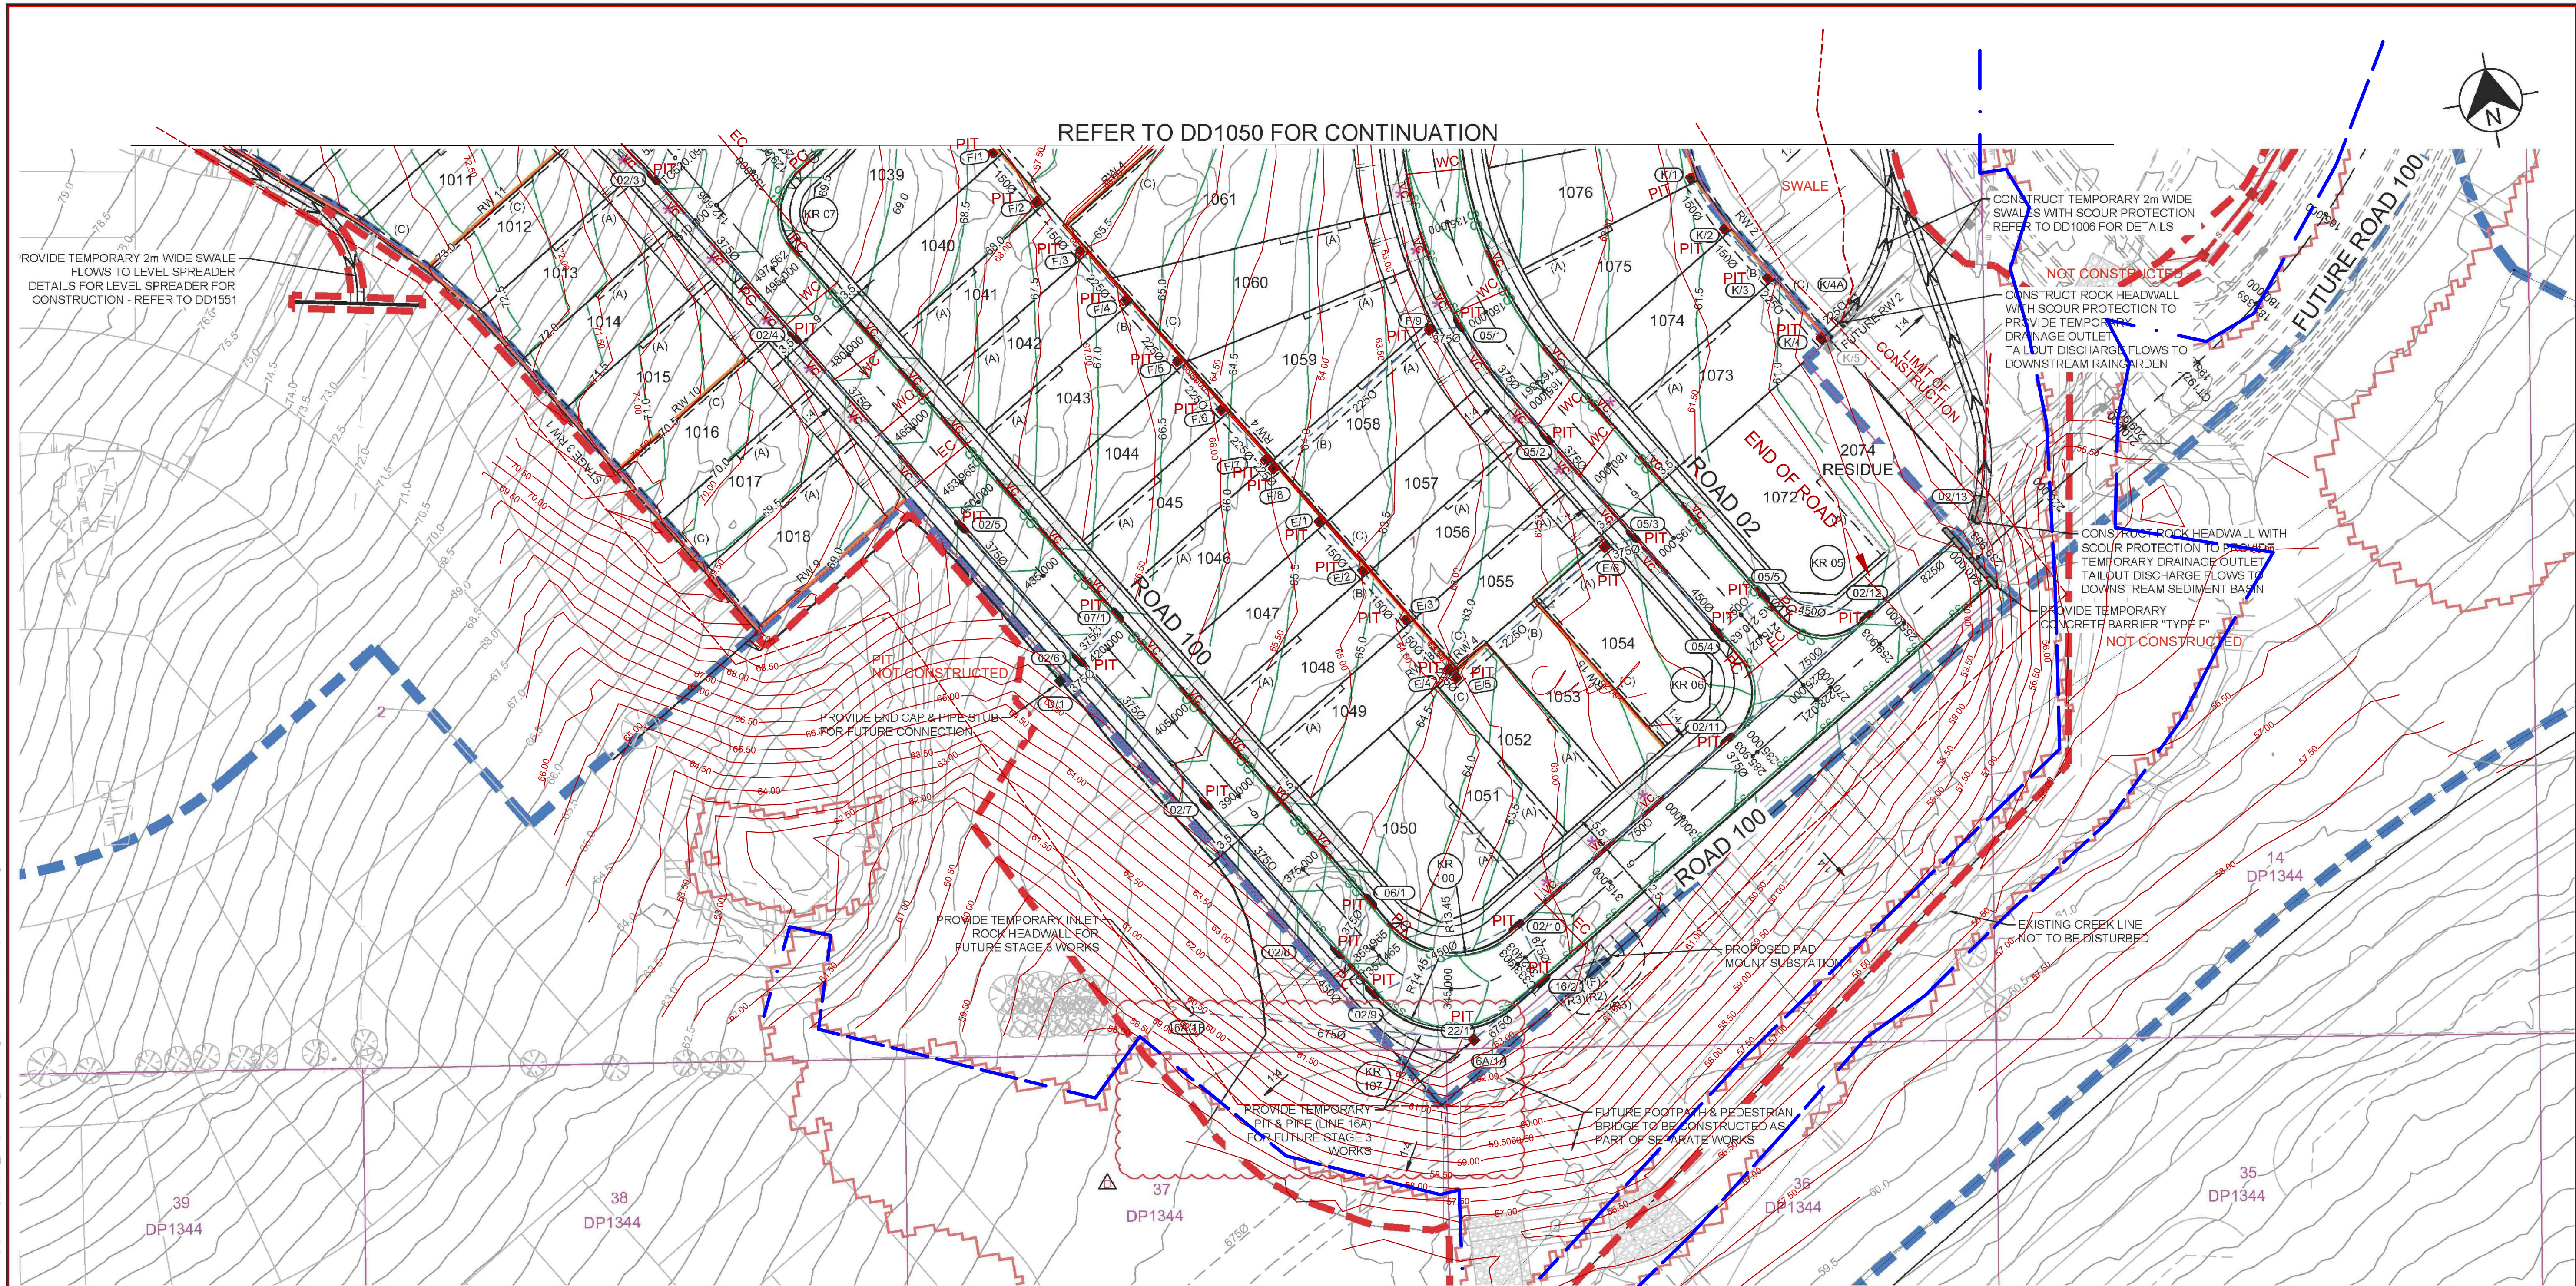

- NOTES:
1. ALL NEW WORKS TO SAWCUT & MAKE SMOOTH CONNECTION TO EXISTING ROAD PAVEMENT.
 2. ALL KERB RETURNS ARE 8.5m RADII UNO. REFER TO DRG DD1300-1301 FOR DETAILS
 3. REFER TO DD1006 FOR TYPICAL ROAD DETAILS
 4. ALL EXISTING STORMWATER PITS AND PIPES THAT DO NOT FORM PART OF THE PROPOSED STORMWATER SYSTEM IS TO BE DEMOLISHED AND DISPOSED OF.
 5. ALL BATTERS SHOWN ARE 1:4 UNLESS NOTED OTHERWISE.

- NOTES:
6. FOR PROPOSED TREE REMOVAL AND RETENTION LOCATION REFER TO DD1700 FOR DEMOLITION PLAN
 7. ALL VEHICULAR CROSSING (VC) WIDTHS ARE 4.0m WIDE UNLESS OTHER WISE NOTED ON PLAN. VCS TO BE IN ACCORDANCE WITH COUNCIL STANDARD DRAWING SD1004 OF P.C.C SPECIFICATION FOR CIVIL WORKS. 3.0m WIDE DRIVEWAYS ARE NOTED WITH *
 8. CONSTRUCT KERB INLET PITS TO COUNCIL STANDARD DRAWING SD2001. INSTALL SL82 MESH IN ALL KERB INLET PIT WALLS AND FLOOR WHERE PIT DEPTH > 1.5m
 9. FOR RETAINING WALL PLANS & DETAILS SEE DRAWINGS DD1600-1608

- NOTES:
10. RETAINING WALLS ARE 1.5m MAX HEIGHT UNLESS OTHERWISE SHOWN. REFER TO DD1600-1612 FOR DETAILS
 11. FOR COMPACTION SPECIFICATIONS REFER TO GEOTECHNICAL REPORT
 12. PLANS ARE TO BE READ IN CONJUNCTION WITH ARCHITECT'S PLANS AND LANDSCAPE ARCHITECT'S PLANS
 13. ALL INTERALLOTMENT DRAINAGE EASEMENT WIDTHS TO BE IN ACCORDANCE WITH THE P.C.C. DESIGN GUIDELINES. 150-2250 PIPES SHALL HAVE 2m WIDE EASEMENTS WHERE THE PIPE IS ADJACENT TO A RETAINING WALL.


- NOTES:
14. ALL PRAM RAMPS TO BE CONSTRUCTED TO P.C.C. SPECIFICATION FOR CIVIL WORKS DRAWING SD1002
 15. ACCESS TO EXISTING DWELLINGS IS TO BE MAINTAINED AT ALL TIMES.

- (A) PROPOSED EASEMENT FOR ACCESS & MAINTENANCE 0.9 WIDE
(B) PROPOSED EASEMENT TO DRAIN WATER 2.0 WIDE
(C) PROPOSED EASEMENT FOR RETAINING WALL SUPPORT 0.5 WIDE
(F) PROPOSED EASEMENT FOR PADMOUNT SUBSTATION 2.75 WIDE
(R1) PROPOSED RESTRICTION ON THE USE OF LAND 6 WIDE
(R2) PROPOSED RESTRICTION ON THE USE OF LAND (FIRE RATING)
(R3) PROPOSED RESTRICTION ON THE USE OF LAND (SWIMMING POOL)

WORKS AS EXECUTED AS SHOWN IN RED
NAME: CRAIG S LONARD
SIGNATURE: *Craig S Lonard*
CAPACITY: REGISTERED SURVEYOR #8800
DATE: 17.04.2025 & 09.05.2025
CONTACT ADMIN@HOGANCO.COM.AU

PENRITH CITY COUNCIL
This plan / document relates to
Development Consent: DA23/0969
Subdivision Works Certificate: EA24/0036.01
Subject to the conditions outlined in the consent

--- DENOTES 1 IN 100 YEAR FLOOD LEVEL LOCATION FROM JWP SWC DRAWING DATED 24.10.2022

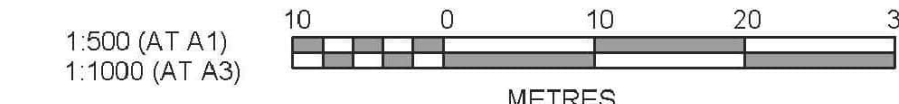

D	TEMPORARY FUTURE INLET FOR STAGE 3 WORKS	MMC	GA	MS	MS
C	PITS SHIFTED; PRAM RAMPS UPDATED	MMC	GA	MS	MS
B	BATTERS, DRAINAGE, WALLS, EASEMENTS, CONTOURS, NOTES UPDATED	MMC	GA	DG	CR
A	ISSUE FOR TENDER	MMC	GA	MS	MS
	AMENDMENT	DES	DRN	CKD	APR
					DATE

J. WYNDHAM PRINCE
CONSULTING CIVIL INFRASTRUCTURE ENGINEERS & PROJECT MANAGERS

PO Box 4366 PENRITH WESTFIELD NSW 2750
P 02 4720 3300 W www.jwprince.com.au E jwp@jwprince.com.au

CLIENT:

LEGACYPROPERTY

STATUS: **ISSUE FOR CONSTRUCTION**

THIS DRAWING MUST NOT BE USED FOR CONSTRUCTION UNLESS SIGNED AS PART OF AN APPROVED CONSTRUCTION CERTIFICATE.

ORCHARD HILLS NORTH
STAGE 1 CADDENS ROAD
ENGINEERING PLAN
SHEET 2

PLAN No: 110265-09-DD1051

PROJECT No: 110265-09SHEET No: DD1051

PLAN No: 110265-09-DD1051

AZIMUTH: M.G.A. 2020

DATUM: A.H.D.

ORIGIN: SSM 1112

PLAN No: 110265-09-DD1051

D


LEGEND
--- HGL GRADE 5YR (20% AEP)
— FINISHED DESIGN SURFACE

RHCO RICHARD HOGAN & CO.
SURVEYING & DEVELOPMENT CONSULTANTS

WORKS AS EXECUTED AS SHOWN IN RED
NAME: - CRAIG S LONARD
SIGNATURE: *Craig S Lonard*
CAPACITY: - REGISTERED SURVEYOR #8800
DATE: 17.04.2025
CONTACT: ADMIN@HOGANCO.COM.AU

PENRITH CITY COUNCIL
This plan / document relates to
Development Consent: DA23/0969
Subdivision Works Certificate: EA24/0036.01
Subject to the conditions outlined in the consent

NOTES:
1. DRAINAGE PIPE SYSTEM CATERS FOR 20% AEP UNLESS OTHERWISE NOTED
2. PITS & PIPES AROUND RAINGARDEN ARE SHOWN ON DD1530. THESE ARE NOT INCLUDED IN THE DRAINAGE LONG SECTIONS

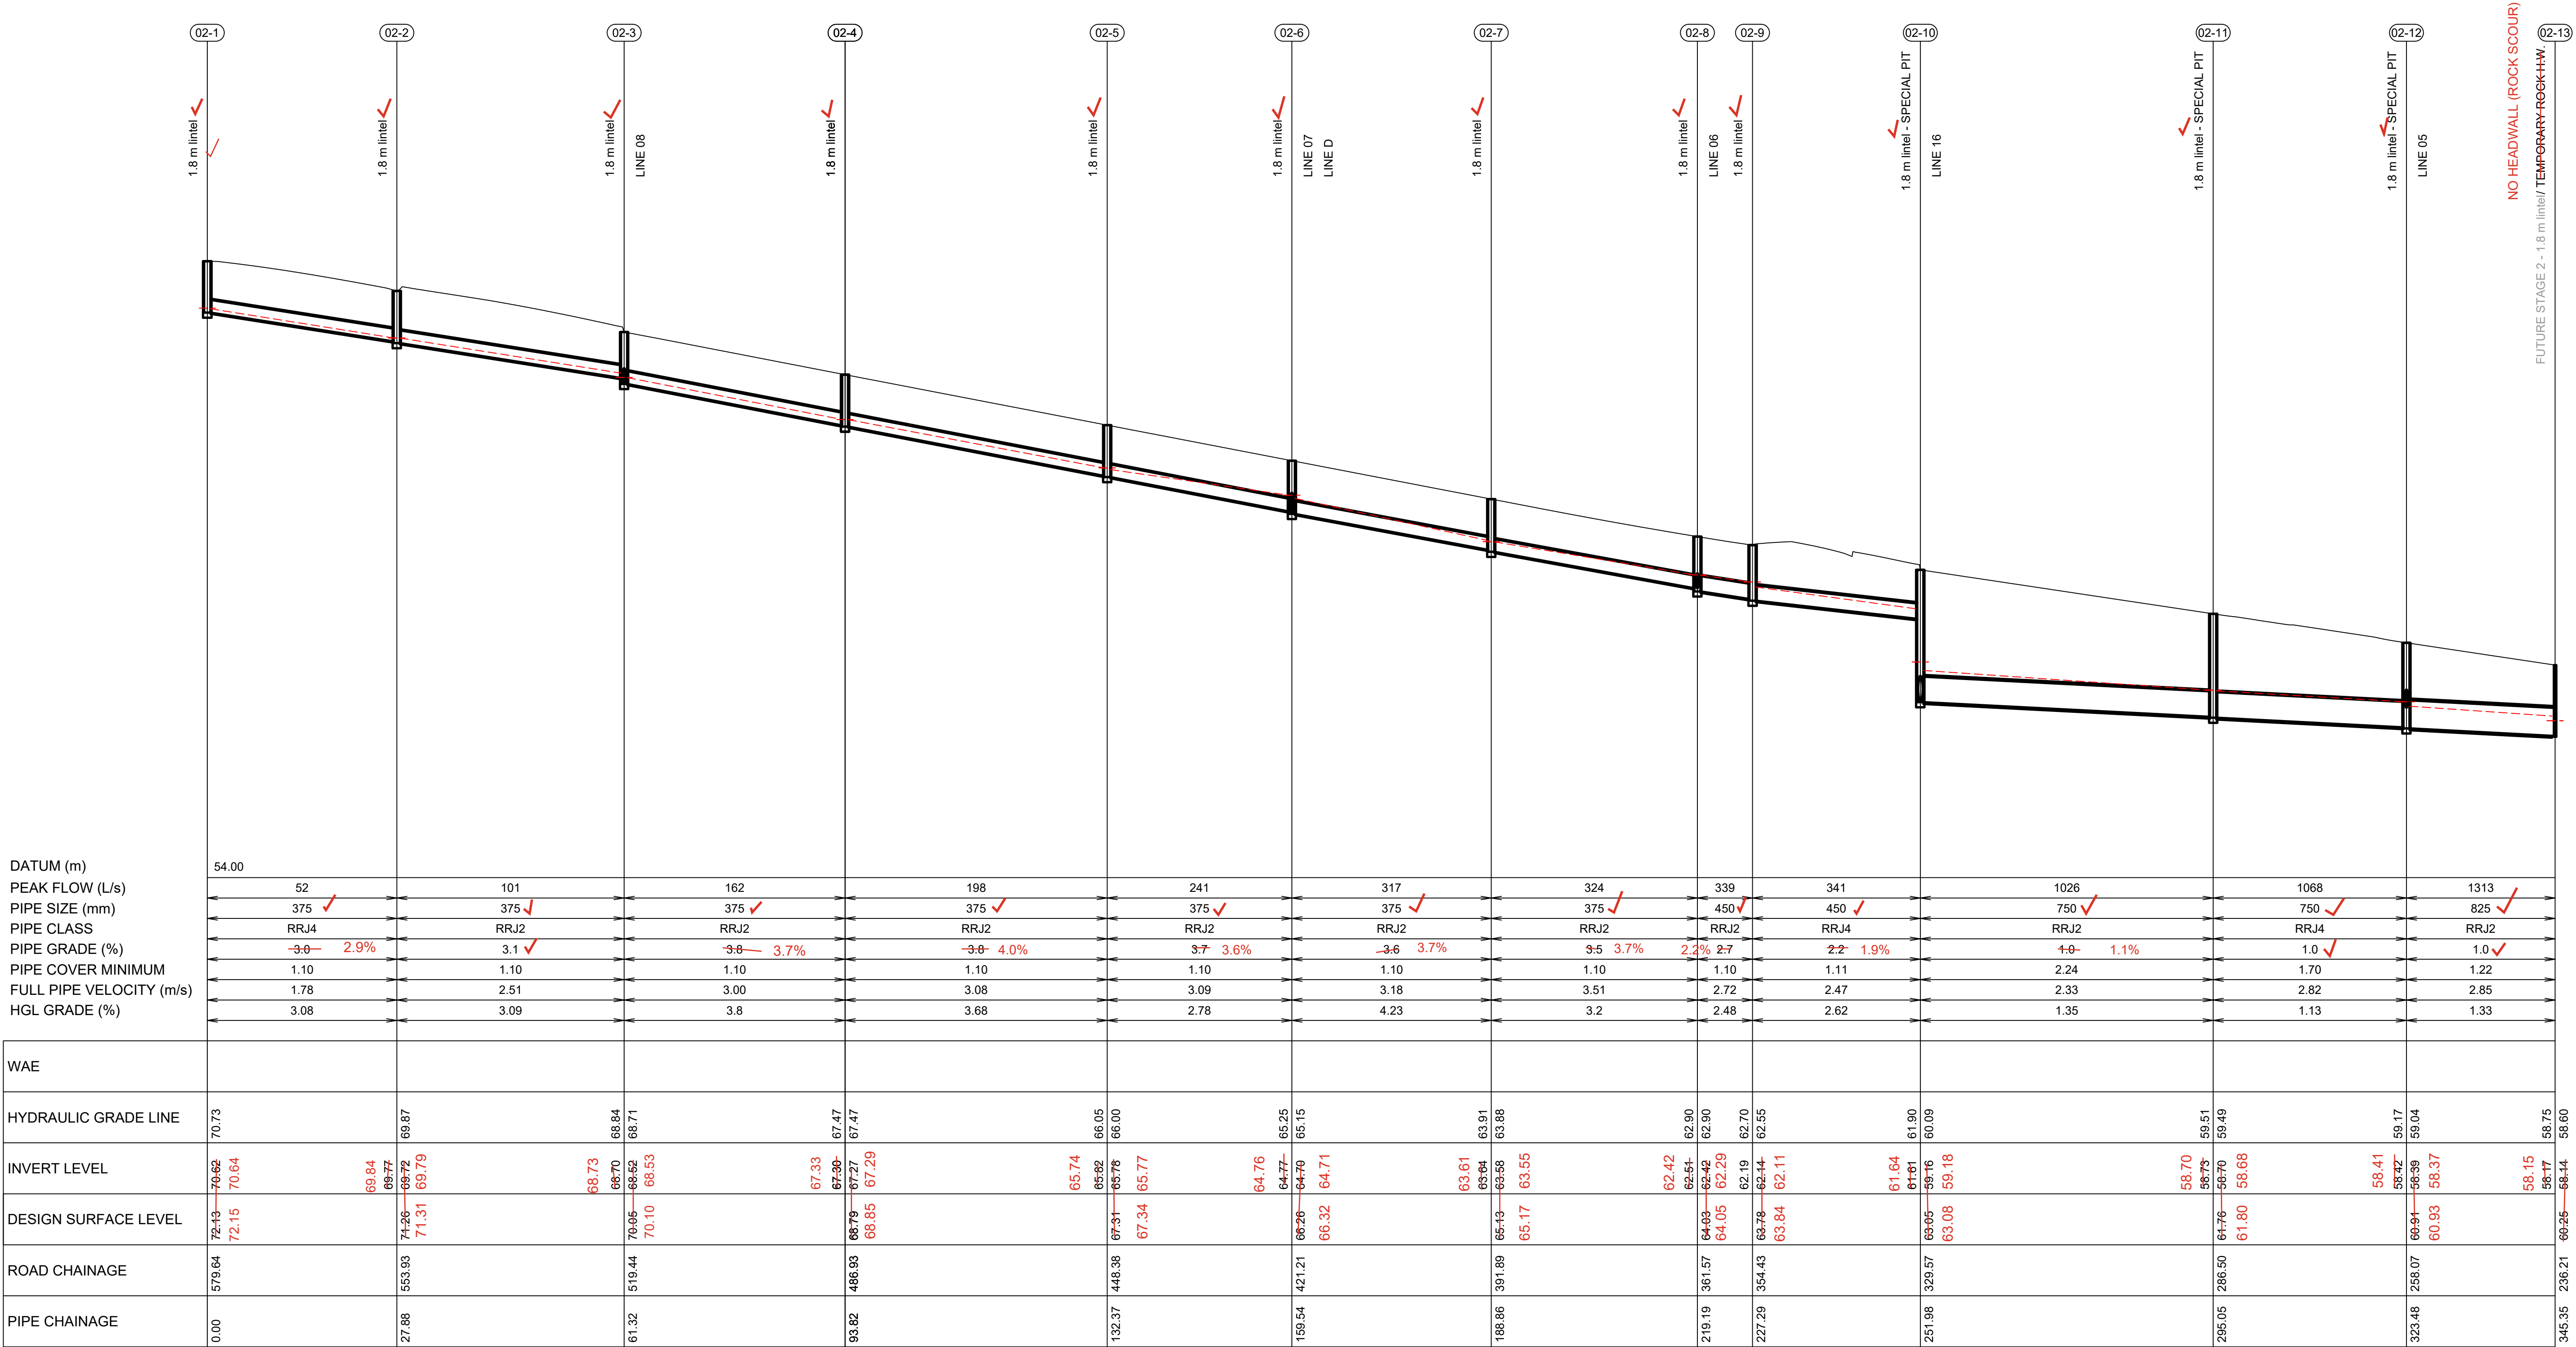

C	LINE 2 UPDATED	MMC	GA	MS	MS	27/09/24
B	LONG SECTIONS UPDATED	MMC	GA	DG	CR	12/09/24
A	ISSUE FOR TENDER	MMC	GA	MS		10/04/24
AMENDMENT		DES	DRN	CKD	APR	DATE

J. WYNDHAM PRINCE
CONSULTING CIVIL INFRASTRUCTURE ENGINEERS & PROJECT MANAGERS

PO Box 4366 PENRITH WESTFIELD NSW 2750
P 02 4720 3300 W www.jwprince.com.au E jwp@jwprince.com.au

CLIENT:
LEGACYPROPERTY

STATUS:
ISSUE FOR CONSTRUCTION
THIS DRAWING MUST NOT BE USED FOR CONSTRUCTION UNLESS SIGNED AS PART OF AN APPROVED CONSTRUCTION CERTIFICATE.

**ORCHARD HILLS NORTH
STAGE 1 CADDENS ROAD
DRAINAGE LONGITUDINAL SECTIONS
SHEET 1**

AZIMUTH: M.G.A. 2020	DATUM: A.H.D.	ORIGIN: SSM 1112	PLAN No: 110265-09-DD1450	C
----------------------	---------------	------------------	---------------------------	---


Plotted: 11 November, 2024 10:47:33 AM File Name: C:\Synergy\WS\data\AS\WP0711\10265-09 - Precinct 1 Development_13533\Design\DD\Stage 1 SWC\110265-09-DD1450.dwg

LEGEND
--- HGL GRADE 5YR (20% AEP)
— FINISHED DESIGN SURFACE


RHCO RICHARD HOGAN & CO.
SURVEYING & DEVELOPMENT CONSULTANTS

WORKS AS EXECUTED AS SHOWN IN RED
NAME: - CRAIG S LONARD
SIGNATURE: *Craig S Lonard*
CAPACITY: - REGISTERED SURVEYOR #8800
DATE: 17.04.2025
CONTACT: ADMIN@HOGANCO.COM.AU

NOTES:
1. DRAINAGE PIPE SYSTEM CATERS FOR 20% AEP UNLESS OTHERWISE NOTED
2. PITS & PIPES AROUND RAINGARDEN ARE SHOWN ON DD1530. THESE ARE NOT INCLUDED IN THE DRAINAGE LONG SECTIONS

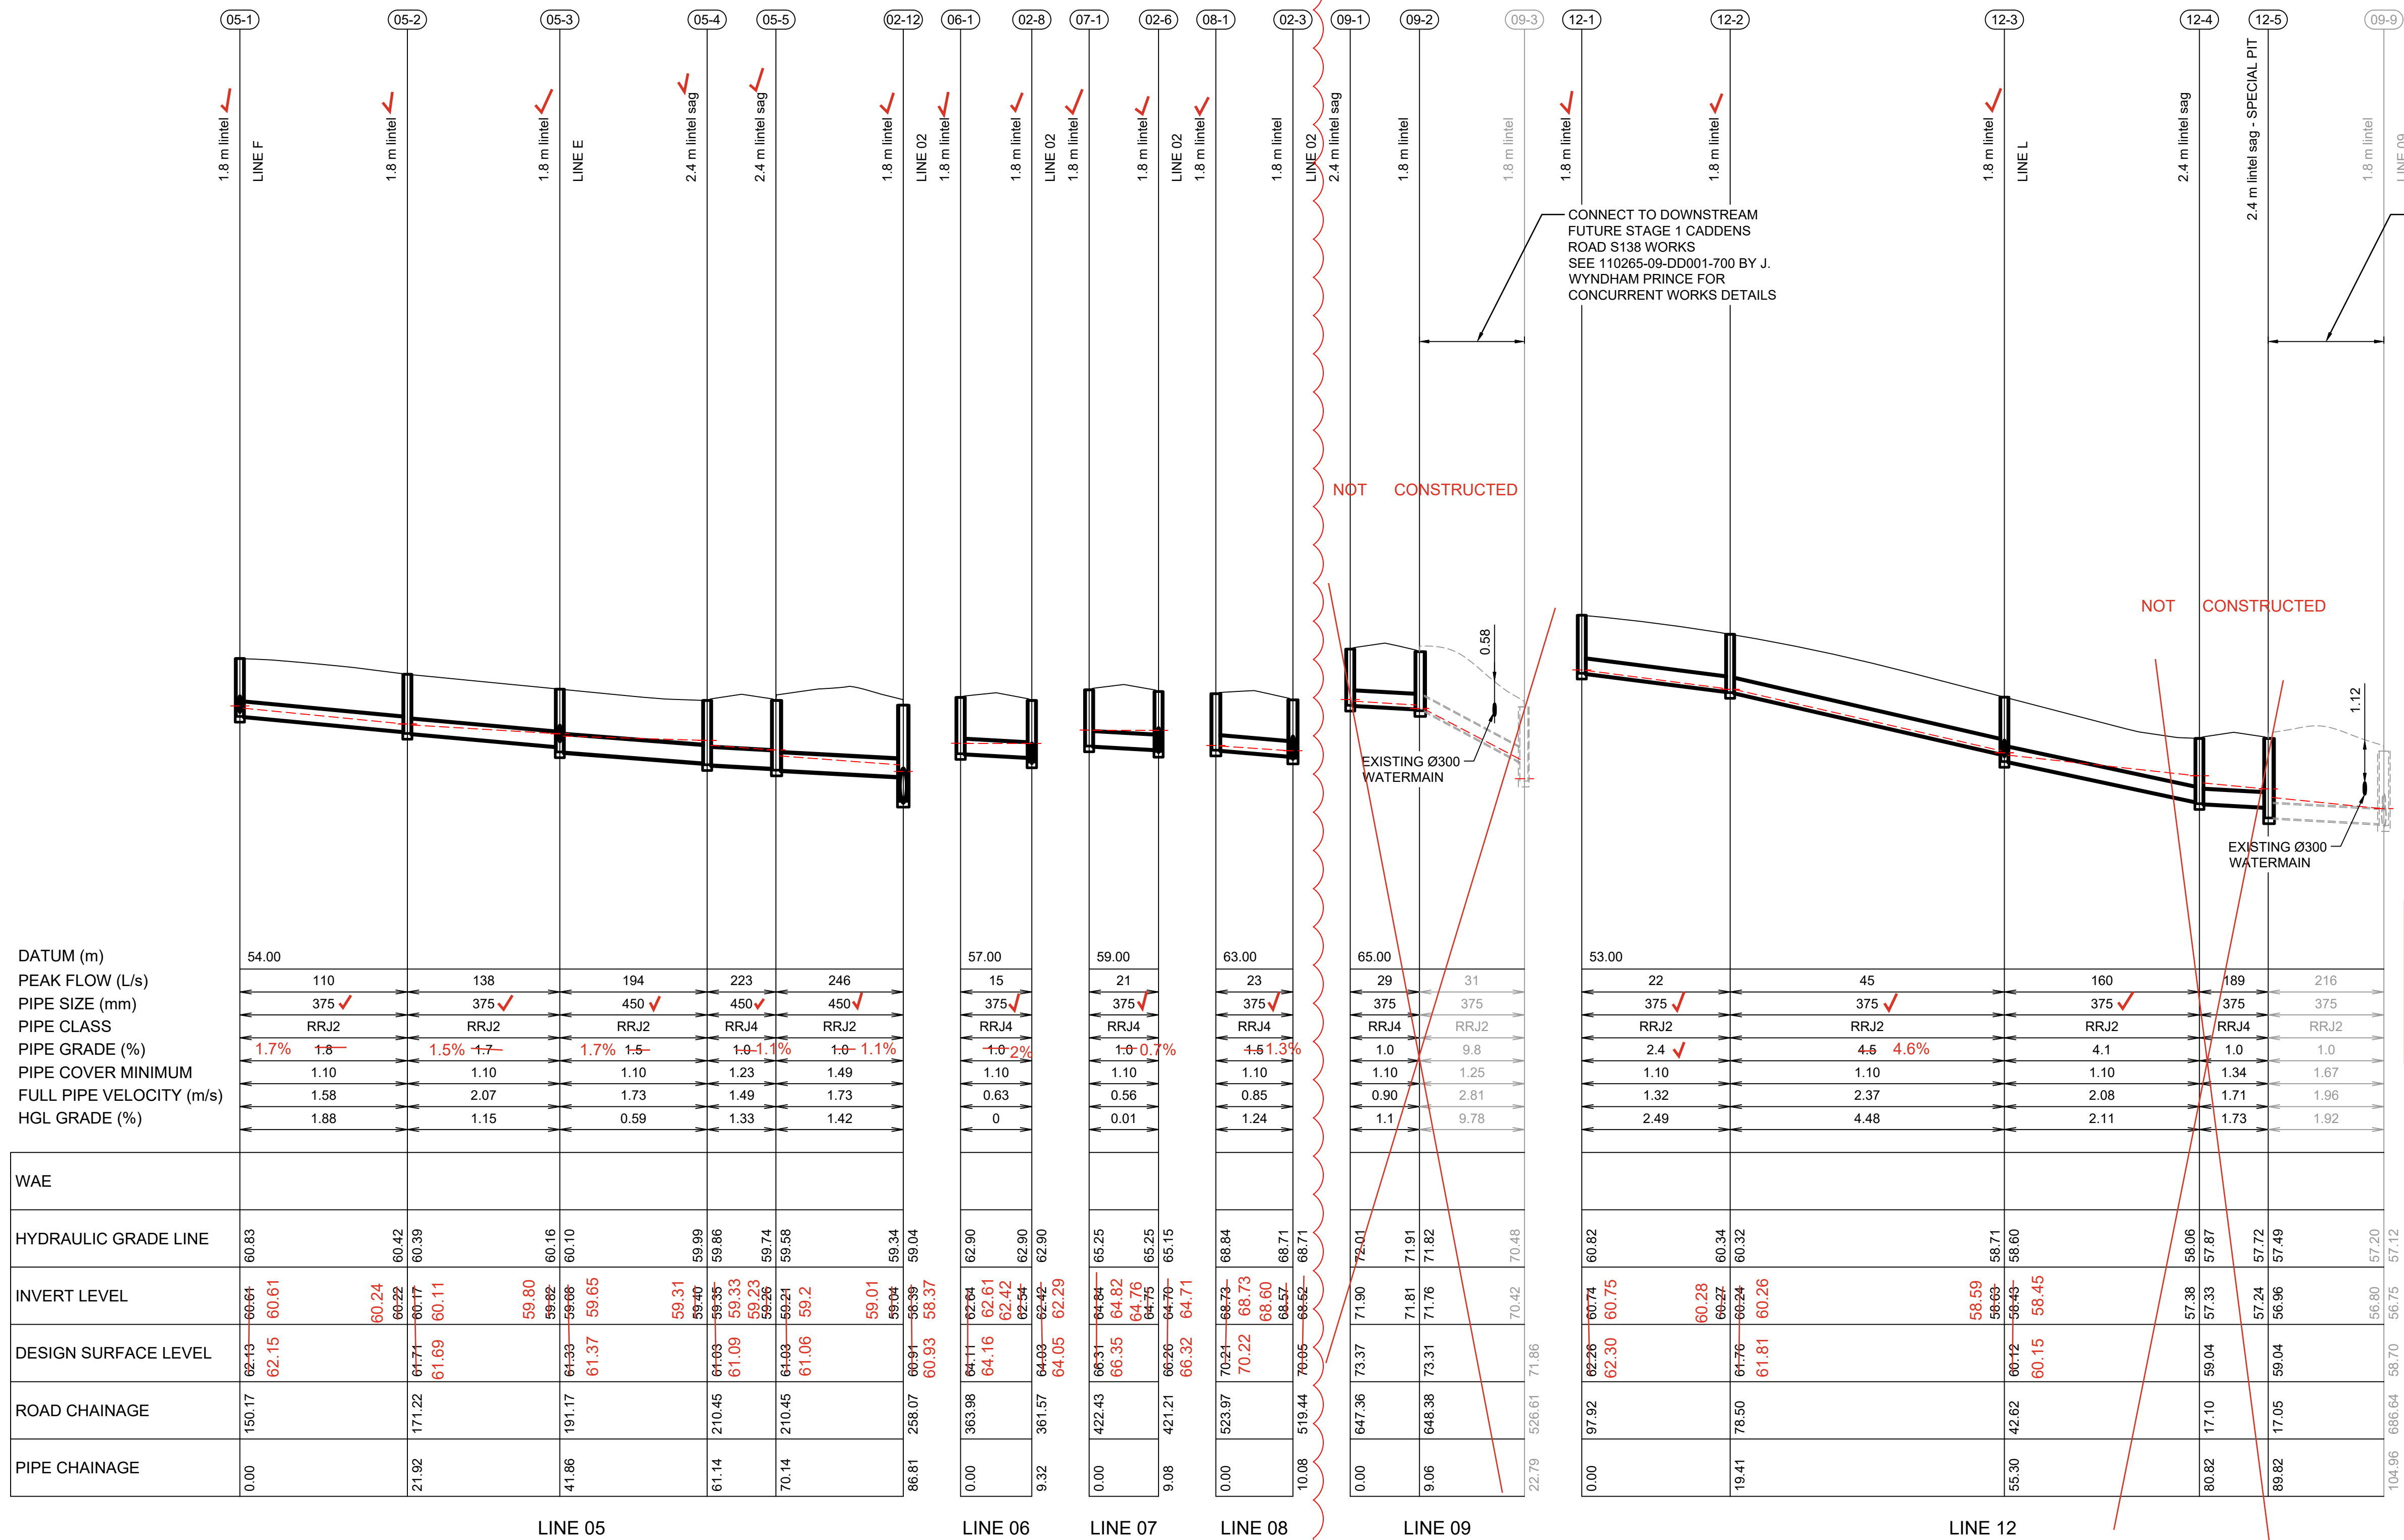

PENRITH CITY COUNCIL
This plan / document relates to
Development Consent: DA23/0969
Subdivision Works Certificate: EA24/0036.01
Subject to the conditions outlined in the consent

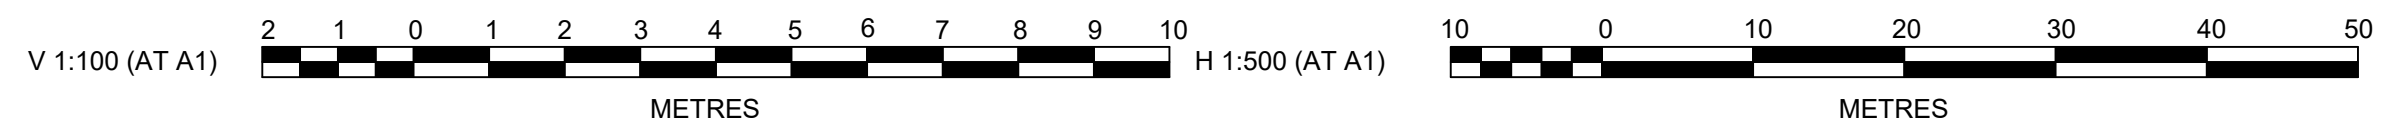

C	LINES 5, 6, 7 & 8 UPDATED	MMC	GA	MS	MS	27/09/24
B	LONG SECTIONS UPDATED	MMC	GA	DG	CR	12/09/24
A	ISSUE FOR TENDER	MMC	GA	MS	CR	10/04/24
AMENDMENT		DES	DRN	CKD	APR	DATE

J. WYNDHAM PRINCE
CONSULTING CIVIL INFRASTRUCTURE ENGINEERS & PROJECT MANAGERS

PO Box 4366 PENRITH WESTFIELD NSW 2750
P 02 4720 3300 W www.jwprince.com.au E jwp@jwprince.com.au

CLIENT:
LEGACYPROPERTY

STATUS:
ISSUE FOR CONSTRUCTION
THIS DRAWING MUST NOT BE USED FOR CONSTRUCTION UNLESS SIGNED AS PART OF AN APPROVED CONSTRUCTION CERTIFICATE.

ORCHARD HILLS NORTH
STAGE 1 CADDENS ROAD
DRAINAGE LONGITUDINAL SECTIONS
SHEET 2

AZIMUTH: M.G.A. 2020
DATUM: A.H.D.
ORIGIN: SSM 1112
PLAN No: 110265-09-DD1451
C

PROJECT No:
110265-09
SHEET No:
DD1451


LEGEND
--- HGL GRADE 5YR (20% AEP)
— FINISHED DESIGN SURFACE

RHCO RICHARD HOGAN & CO.
SURVEYING & DEVELOPMENT CONSULTANTS

WORKS AS EXECUTED AS SHOWN IN RED
NAME: - CRAIG S LONARD
SIGNATURE: *Craig S Lonard*
CAPACITY: - REGISTERED SURVEYOR #8800
DATE: 17.04.2025 & 09.05.2025
CONTACT: ADMIN@HOGANCO.COM.AU

PENRITH CITY COUNCIL
This plan / document relates to
Development Consent: DA23/0969
Subdivision Works Certificate: EA24/0036.01
Subject to the conditions outlined in the consent

NOTES:
1. DRAINAGE PIPE SYSTEM CATERES FOR 20% AEP UNLESS OTHERWISE NOTED
2. PITS & PIPES AROUND RAINGARDEN ARE SHOWN ON DD1530. THESE ARE NOT INCLUDED IN THE DRAINAGE LONG SECTIONS

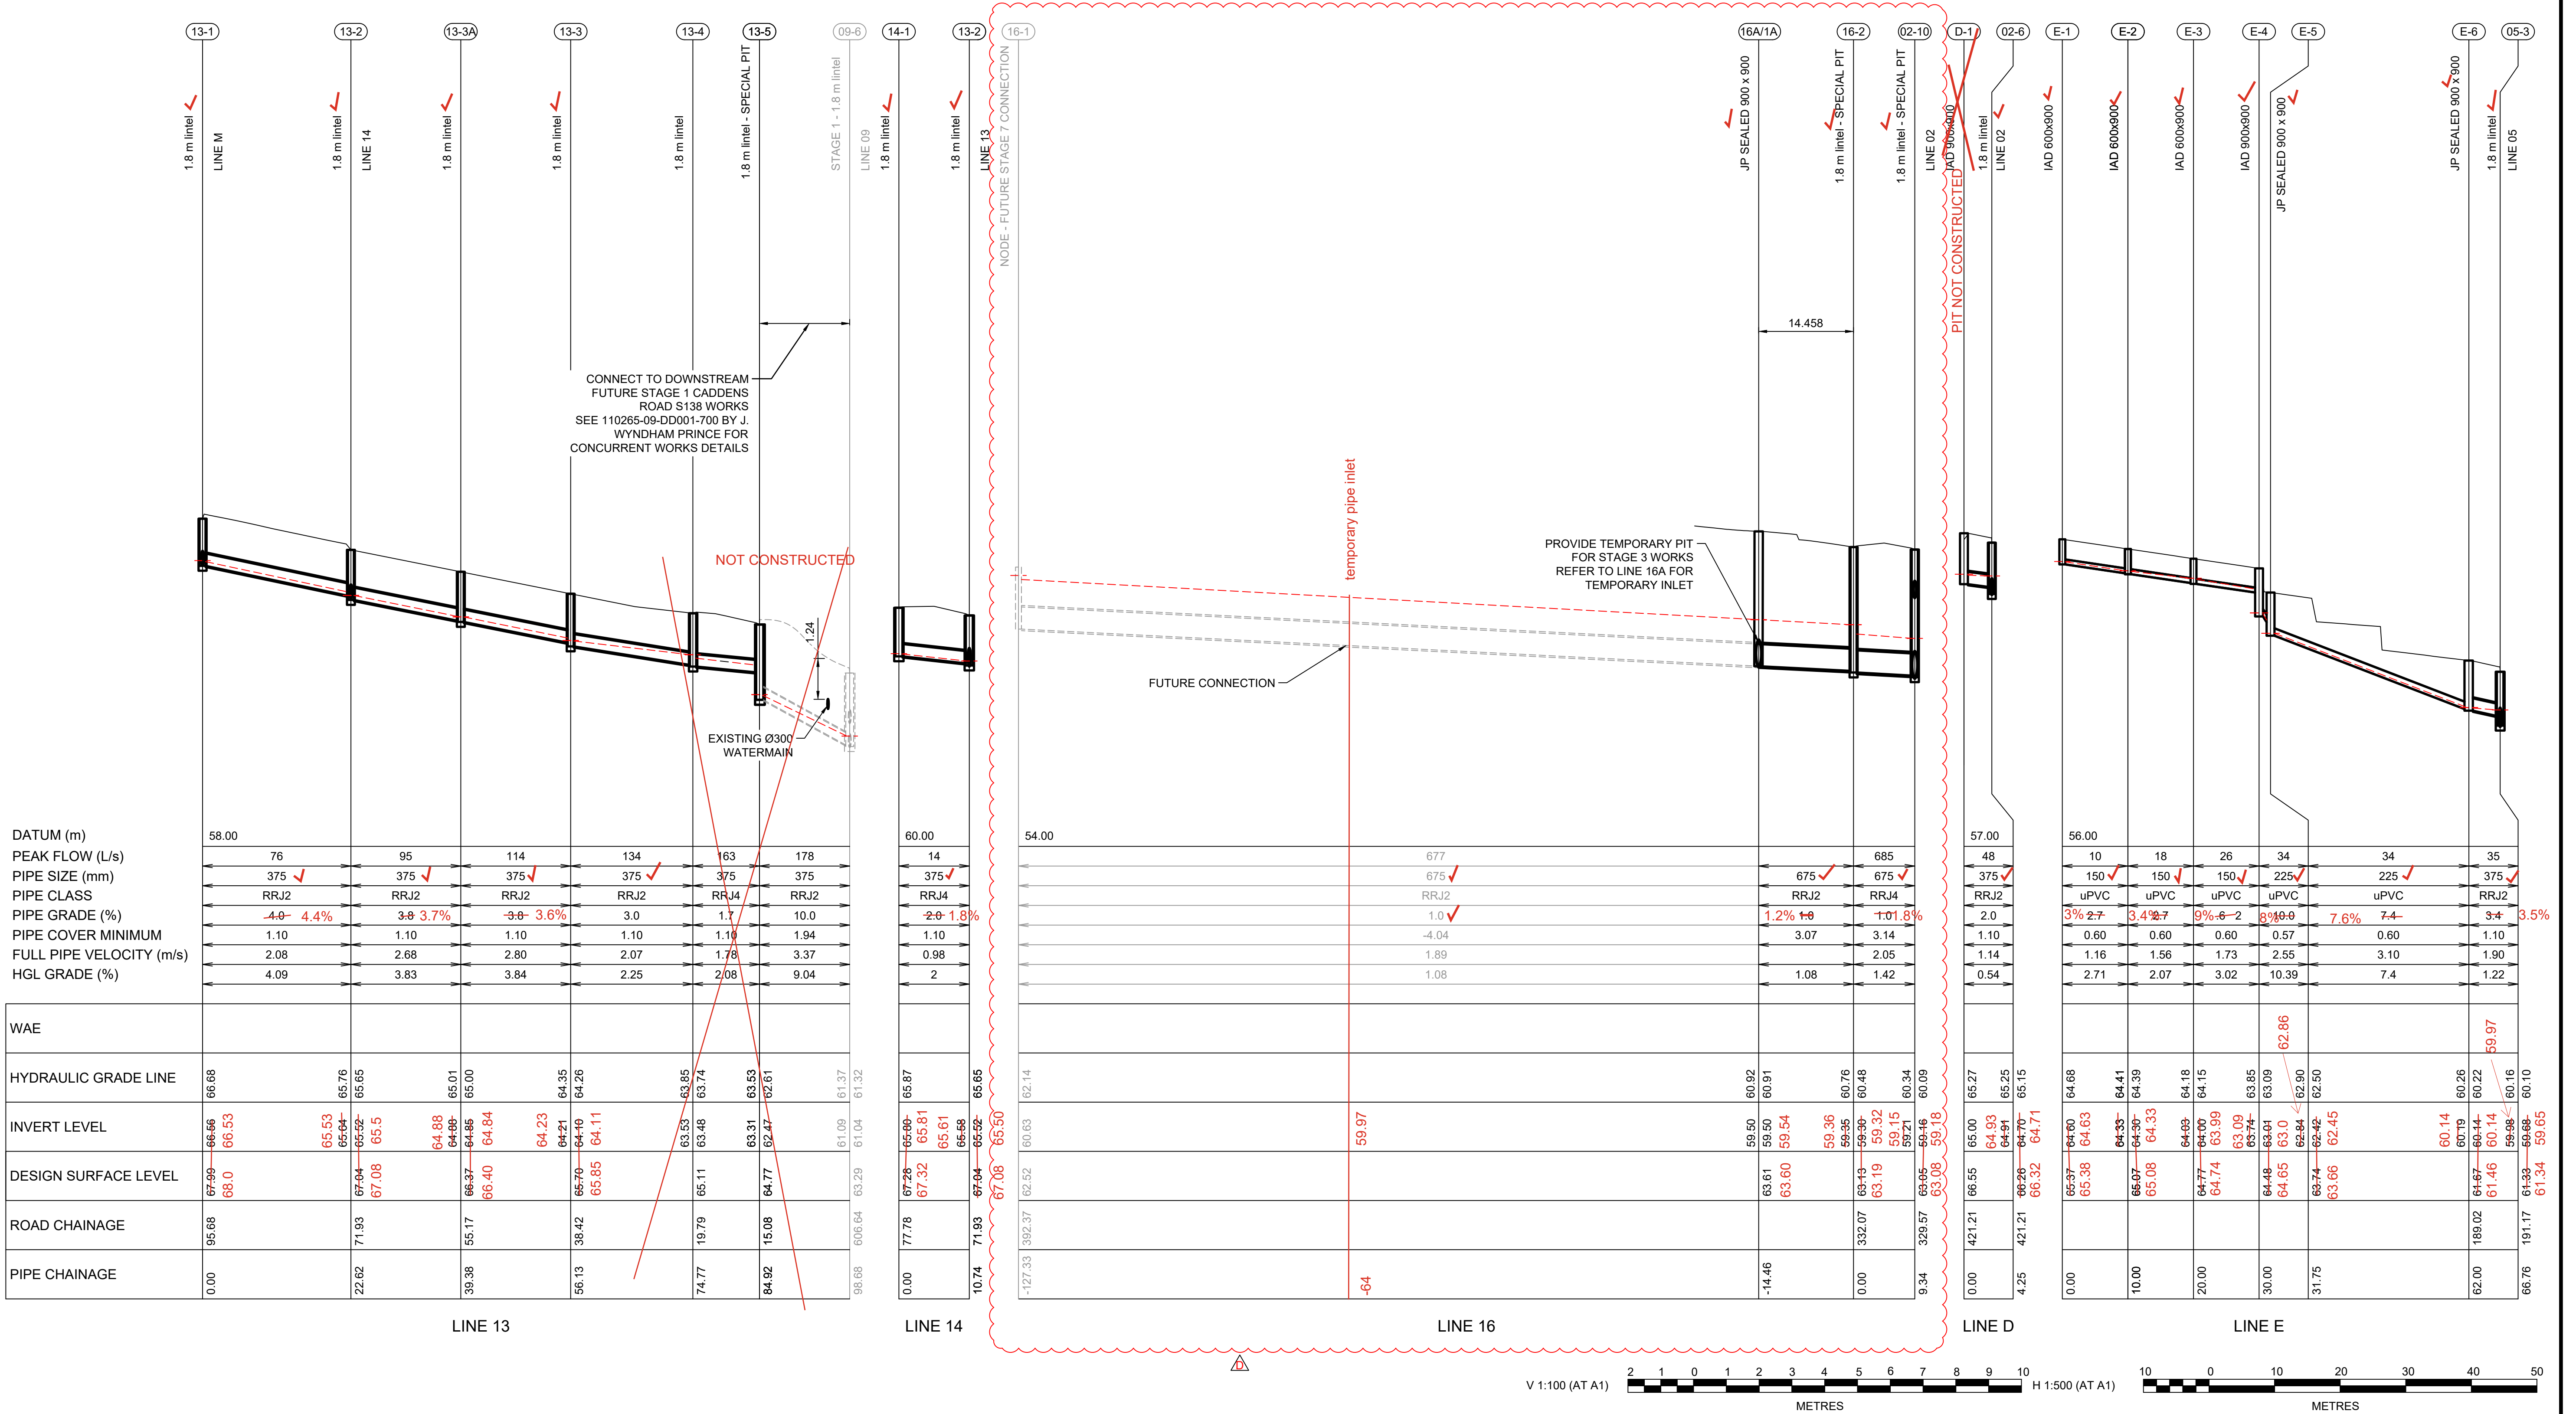


LEGEND
--- HGL GRADE 5YR (20% AEP)
— FINISHED DESIGN SURFACE


RHCO RICHARD HOGAN & CO.
SURVEYING & DEVELOPMENT CONSULTANTS

WORKS AS EXECUTED AS SHOWN IN RED
NAME: - CRAIG S LONARD
SIGNATURE: *Craig S Lonard*
CAPACITY: - REGISTERED SURVEYOR #8800
DATE: 17.04.2025
CONTACT: ADMIN@HOGANCO.COM.AU


NOTES:
1. DRAINAGE PIPE SYSTEM CATERES FOR 20% AEP UNLESS OTHERWISE NOTED
2. PITS & PIPES AROUND RAINGARDEN ARE SHOWN ON DD1530. THESE ARE NOT INCLUDED IN THE DRAINAGE LONG SECTIONS

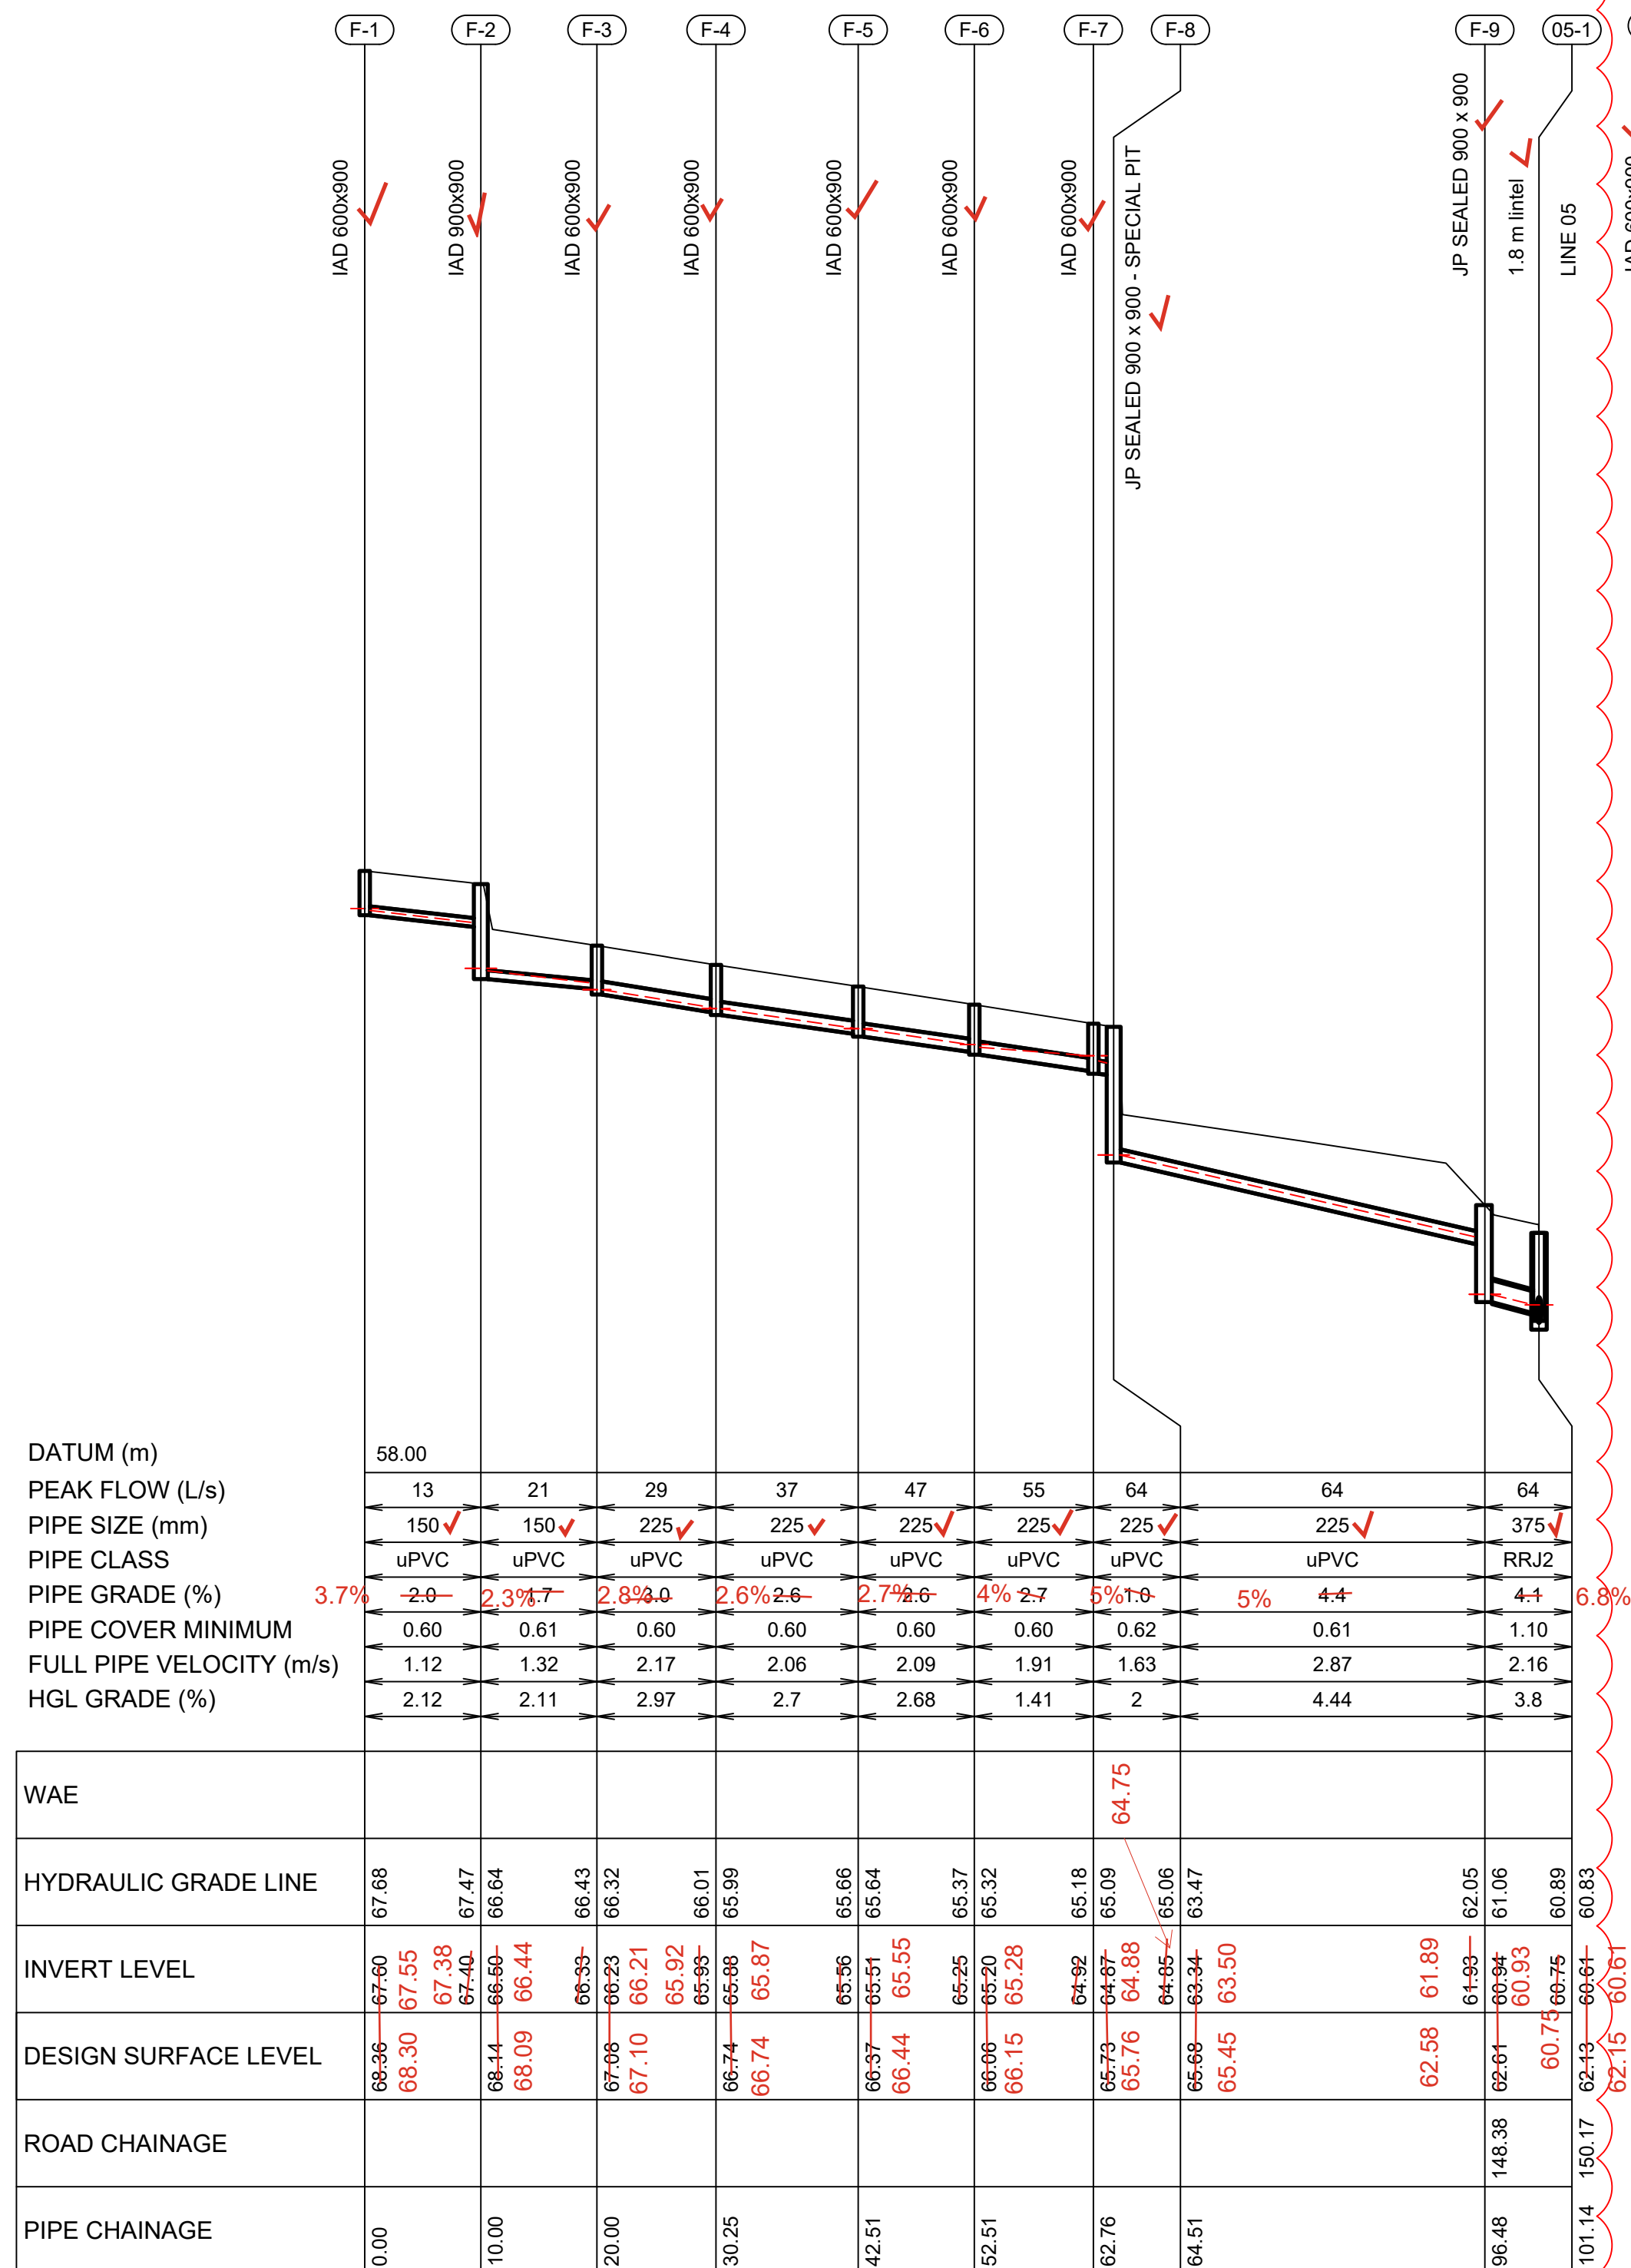


LINE F

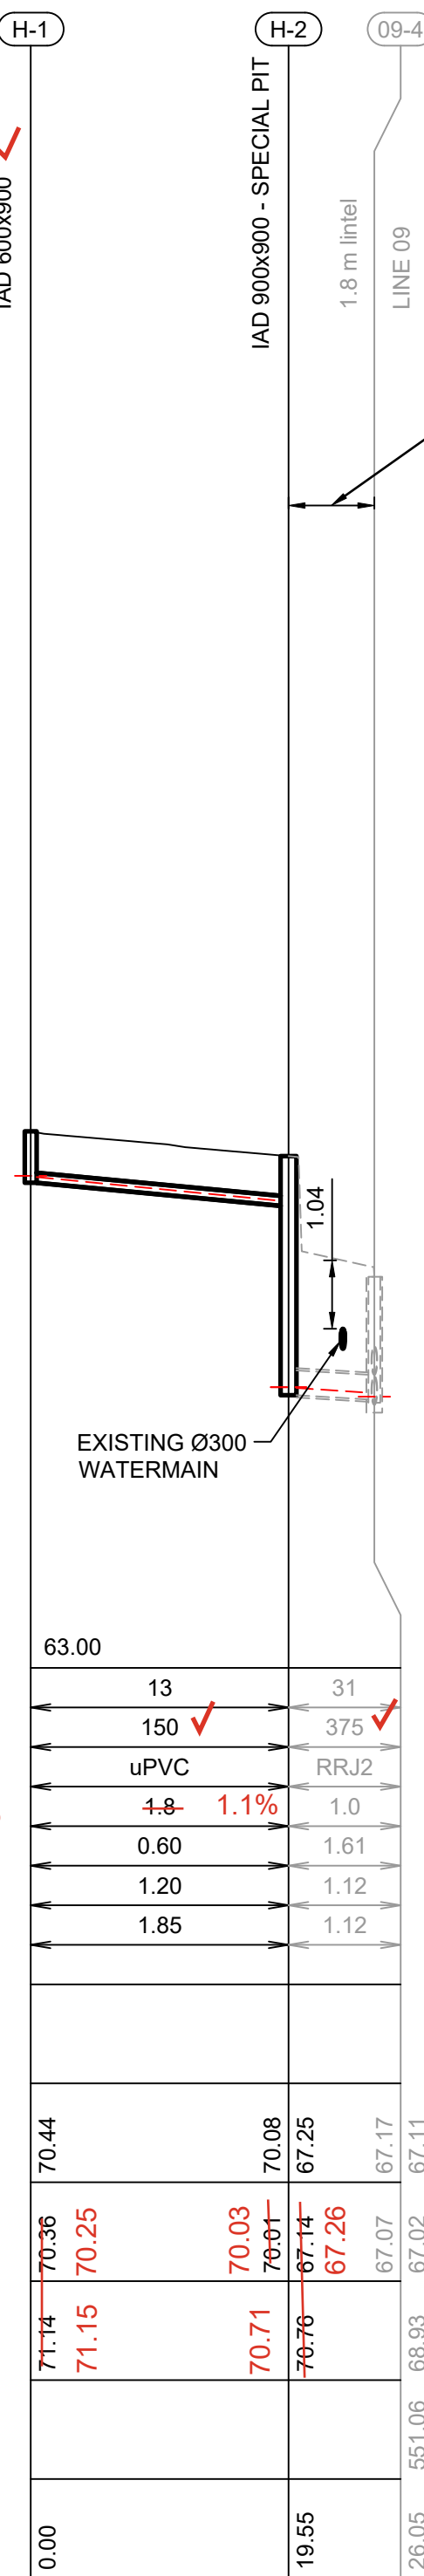


LINE H

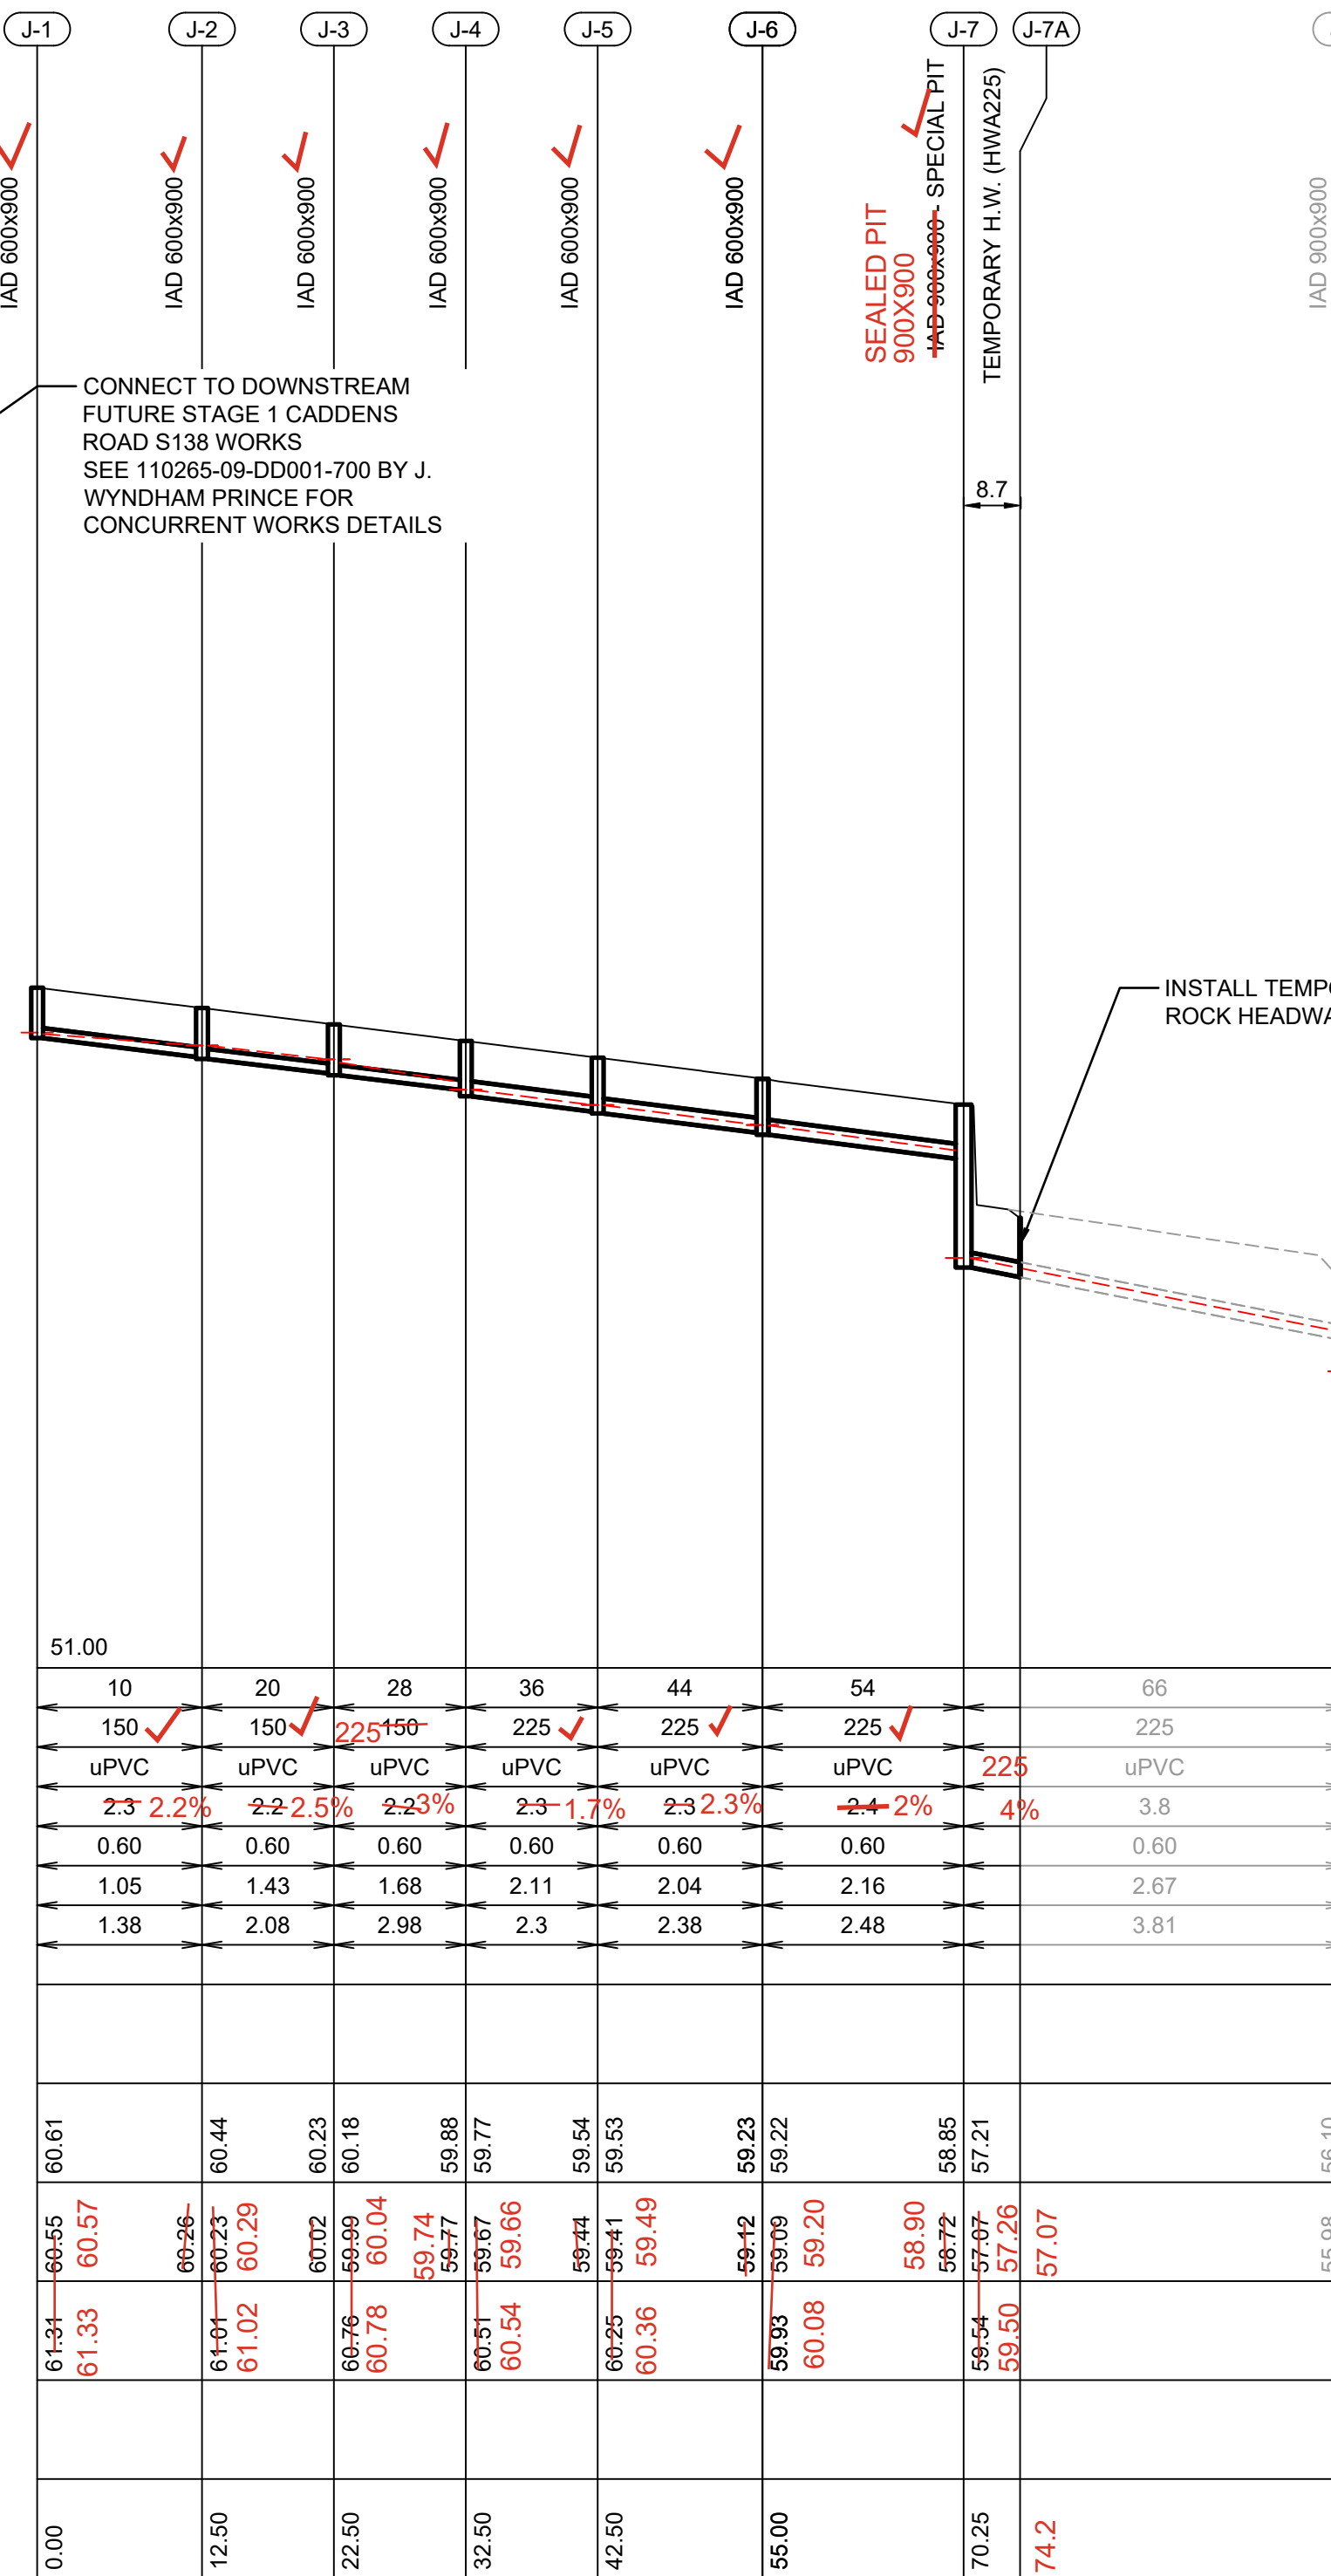

LINE J

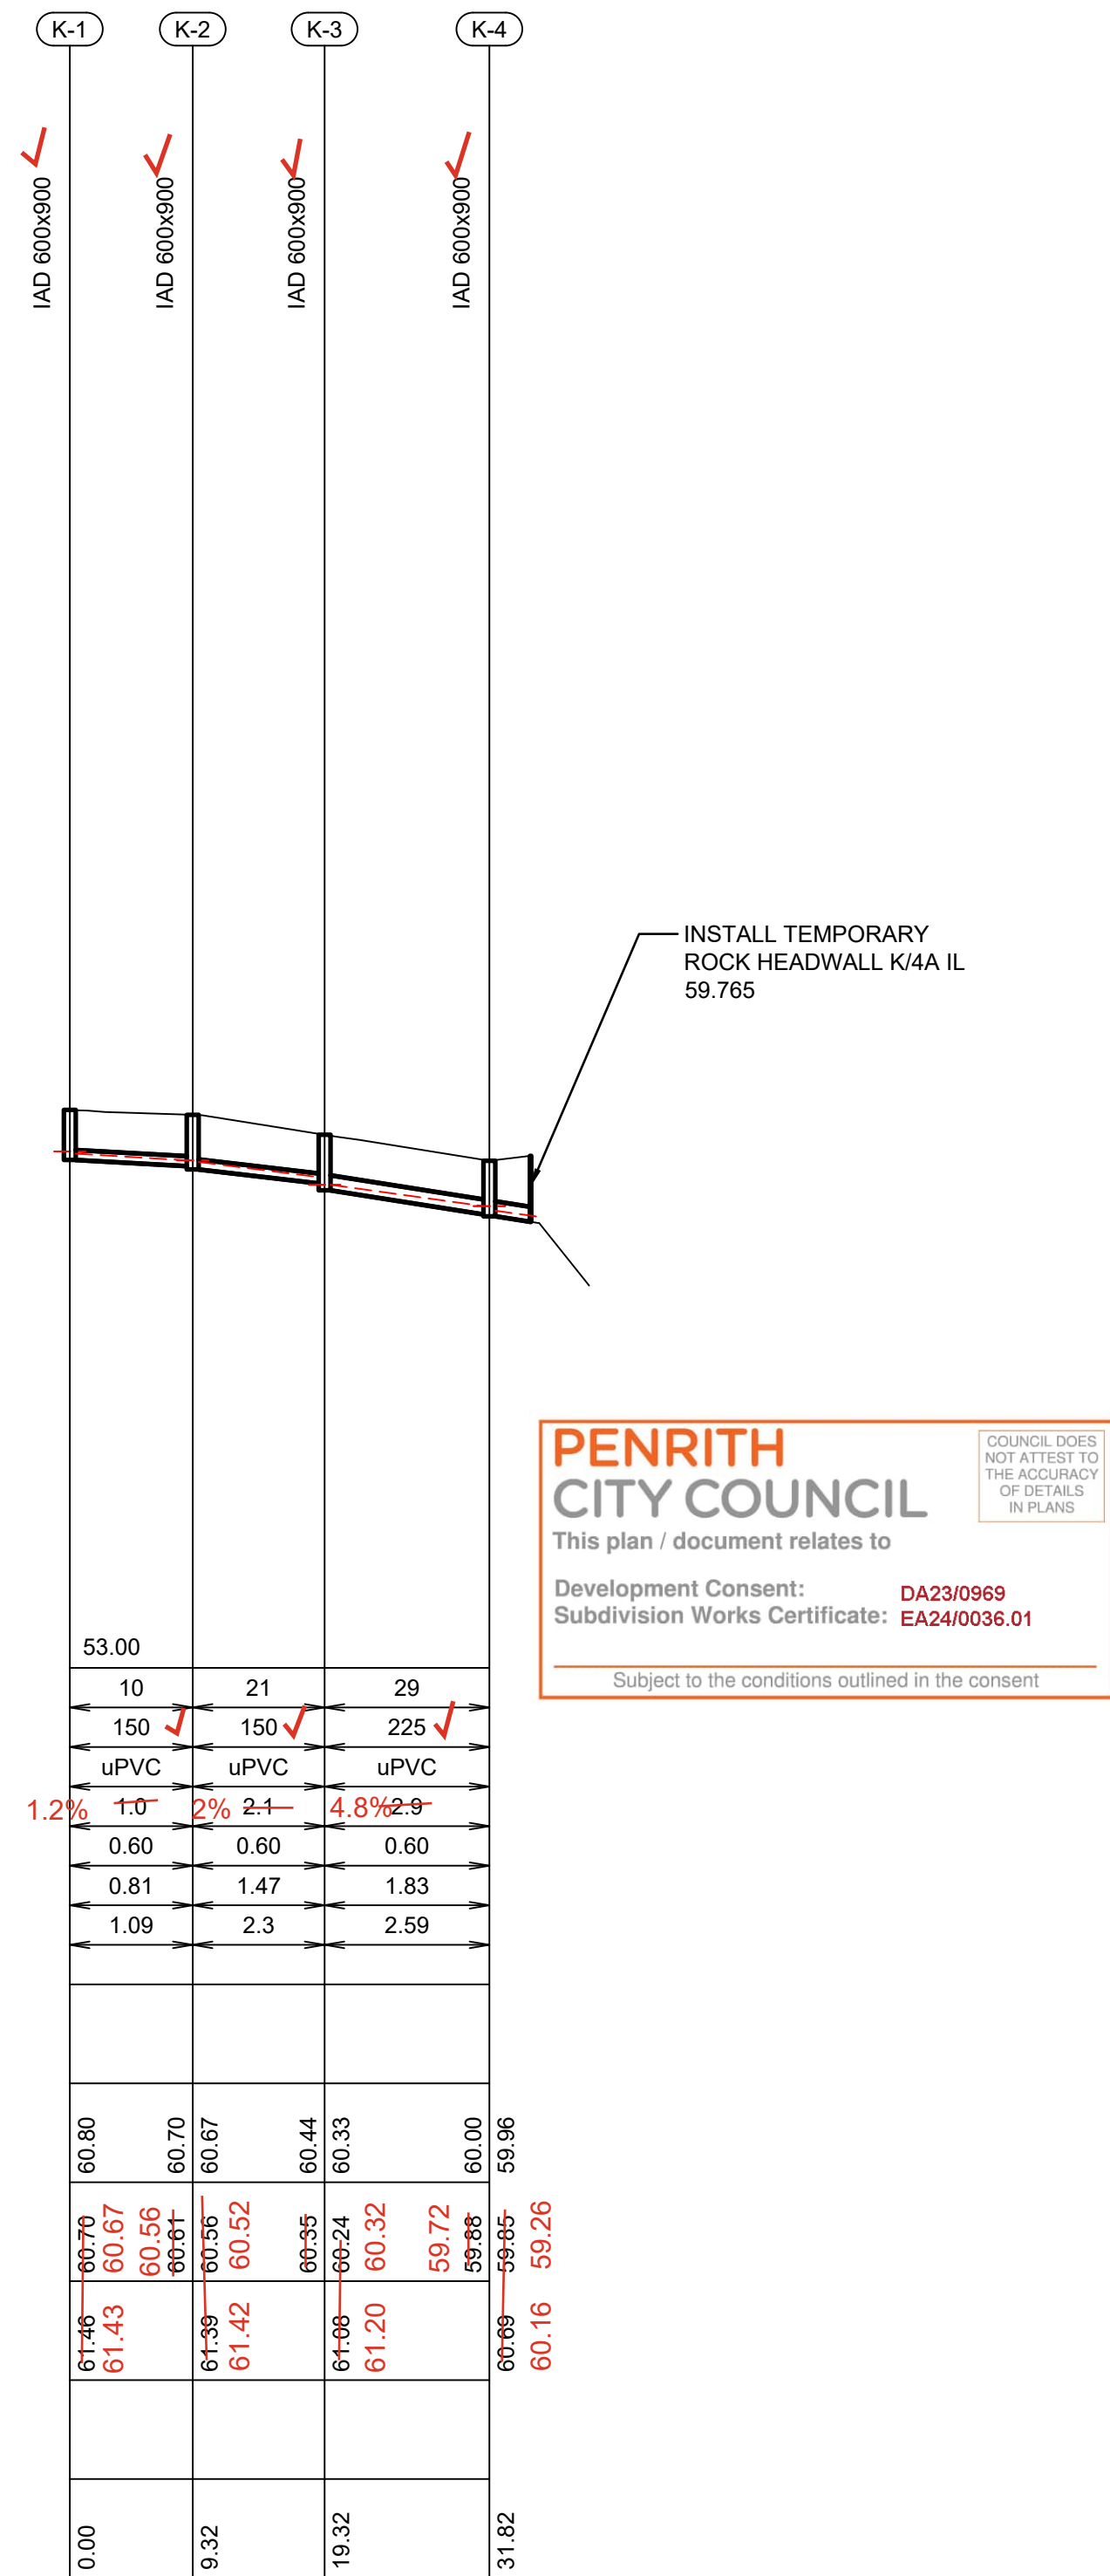

LINE K

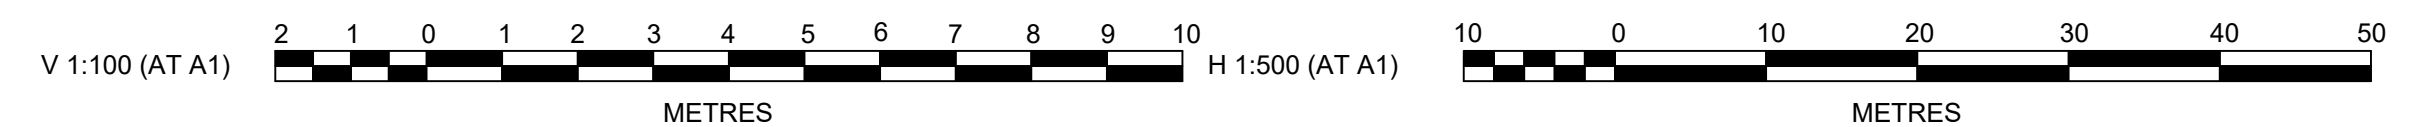

PENRITH CITY COUNCIL
This plan / document relates to
Development Consent: DA23/0969
Subdivision Works Certificate: EA24/0036.01
Subject to the conditions outlined in the consent

C	LINE F UPDATED	MMC	GA	MS	MS	27/09/24
B	LONG SECTIONS UPDATED	MMC	GA	DG	CR	12/09/24
A	ISSUE FOR TENDER	MMC	GA	MS	CR	10/04/24
AMENDMENT						
DES	DRN	CKD	APR	DATE		

J. WYNDHAM PRINCE
CONSULTING CIVIL INFRASTRUCTURE ENGINEERS & PROJECT MANAGERS

PO Box 4366 PENRITH WESTFIELD NSW 2750
P 02 4720 3300 W www.jwprince.com.au E jwp@jwprince.com.au

CLIENT:
LEGACYPROPERTY

STATUS:
ISSUE FOR CONSTRUCTION
THIS DRAWING MUST NOT BE USED FOR CONSTRUCTION UNLESS SIGNED AS PART OF AN APPROVED CONSTRUCTION CERTIFICATE.

ORCHARD HILLS NORTH
STAGE 1 CADDENS ROAD
DRAINAGE LONGITUDINAL SECTIONS
SHEET 4

PROJECT No: 110265-09
SHEET No: DD1453

PLAN No: 110265-09-DD1453

AZIMUTH: M.G.A. 2020
DATUM: A.H.D.
ORIGIN: SSM 1112


C

LEGEND
HGL GRADE 5YR (20% AEP)
FINISHED DESIGN SURFACE

NOTES:
1. DRAINAGE PIPE SYSTEM CATERES FOR 20% AEP UNLESS OTHERWISE NOTED
2. PITS & PIPES AROUND RAINGARDEN ARE SHOWN ON DD1530. THESE ARE NOT INCLUDED IN THE DRAINAGE LONG SECTIONS

WORKS AS EXECUTED AS SHOWN IN RED
NAME: - CRAIG S LONARD
SIGNATURE: *Craig S Lonard*
CAPACITY: - REGISTERED SURVEYOR #8800
DATE: 17.04.2025
CONTACT: ADMIN@HOGANCO.COM.AU

RHCO RICHARD HOGAN & CO.
SURVEYING & DEVELOPMENT CONSULTANTS

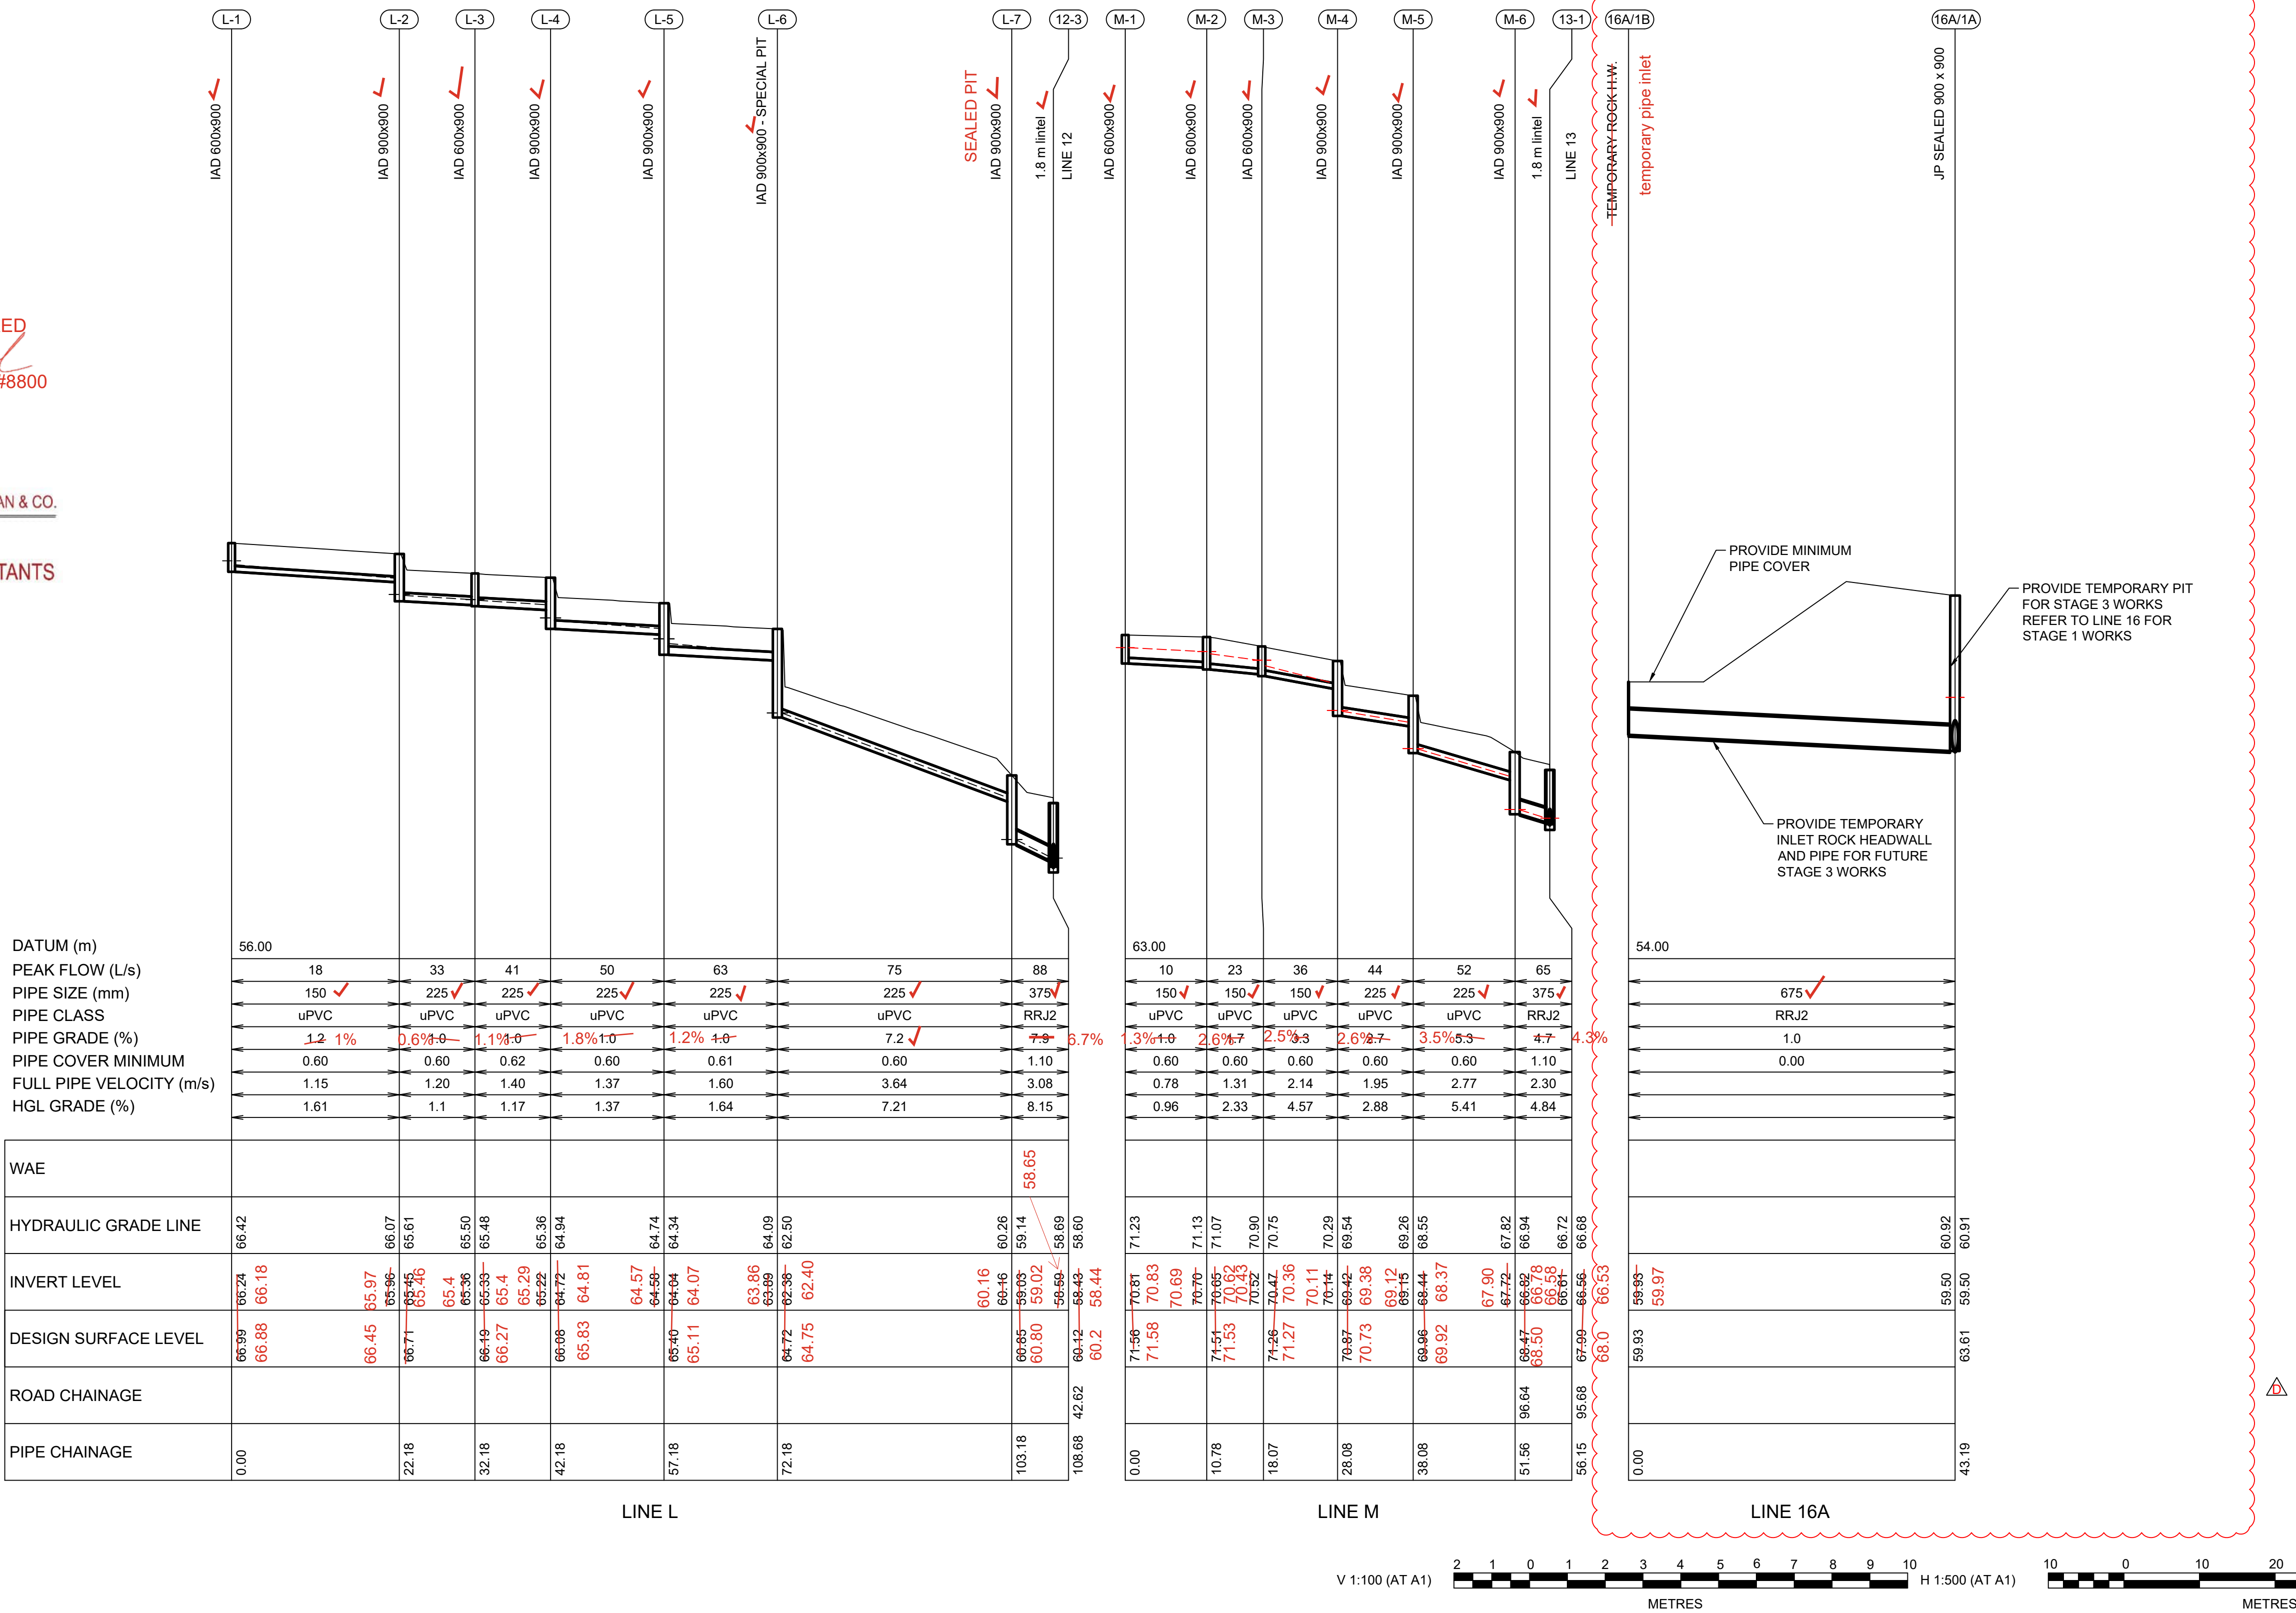

PENRITH CITY COUNCIL
This plan / document relates to
Development Consent: DA23/0968
Subdivision Works Certificate: EA24/0036.01
Subject to the conditions outlined in the consent

COUNCIL DOES NOT ATTEST TO THE ACCURACY OF DETAILS IN PLANS

J. WYNDHAM PRINCE
CONSULTING CIVIL INFRASTRUCTURE ENGINEERS & PROJECT MANAGERS

PO Box 4366 PENRITH WESTFIELD NSW 2750
P 02 4720 3300 W www.jwprince.com.au E jwp@jwprince.com.au

CLIENT:



STATUS:

ISSUE FOR CONSTRUCTION

THIS DRAWING MUST NOT BE USED FOR CONSTRUCTION UNLESS SIGNED AS PART OF AN APPROVED CONSTRUCTION CERTIFICATE.

ORCHARD HILLS NORTH
STAGE 1 CADDENS ROAD
DRAINAGE LONGITUDINAL SECTIONS
SHEET 5

PROJECT No:

110265-09

SHEET No:

DD1454

AZIMUTH:

M.G.A. 2020

DATUM: A.H.D.




ORIGIN: SSM 1112

PLAN No:

110265-09-DD1454




D

Plotted: 14 November, 2024 9:54:53 AM File Name: C:\Synergy\WS\data\AS\JWP07110265_09 - Precinct 1 Development_1353\3\Design\DD\Stage 1 SWC\110265-09-DD1600.dwg

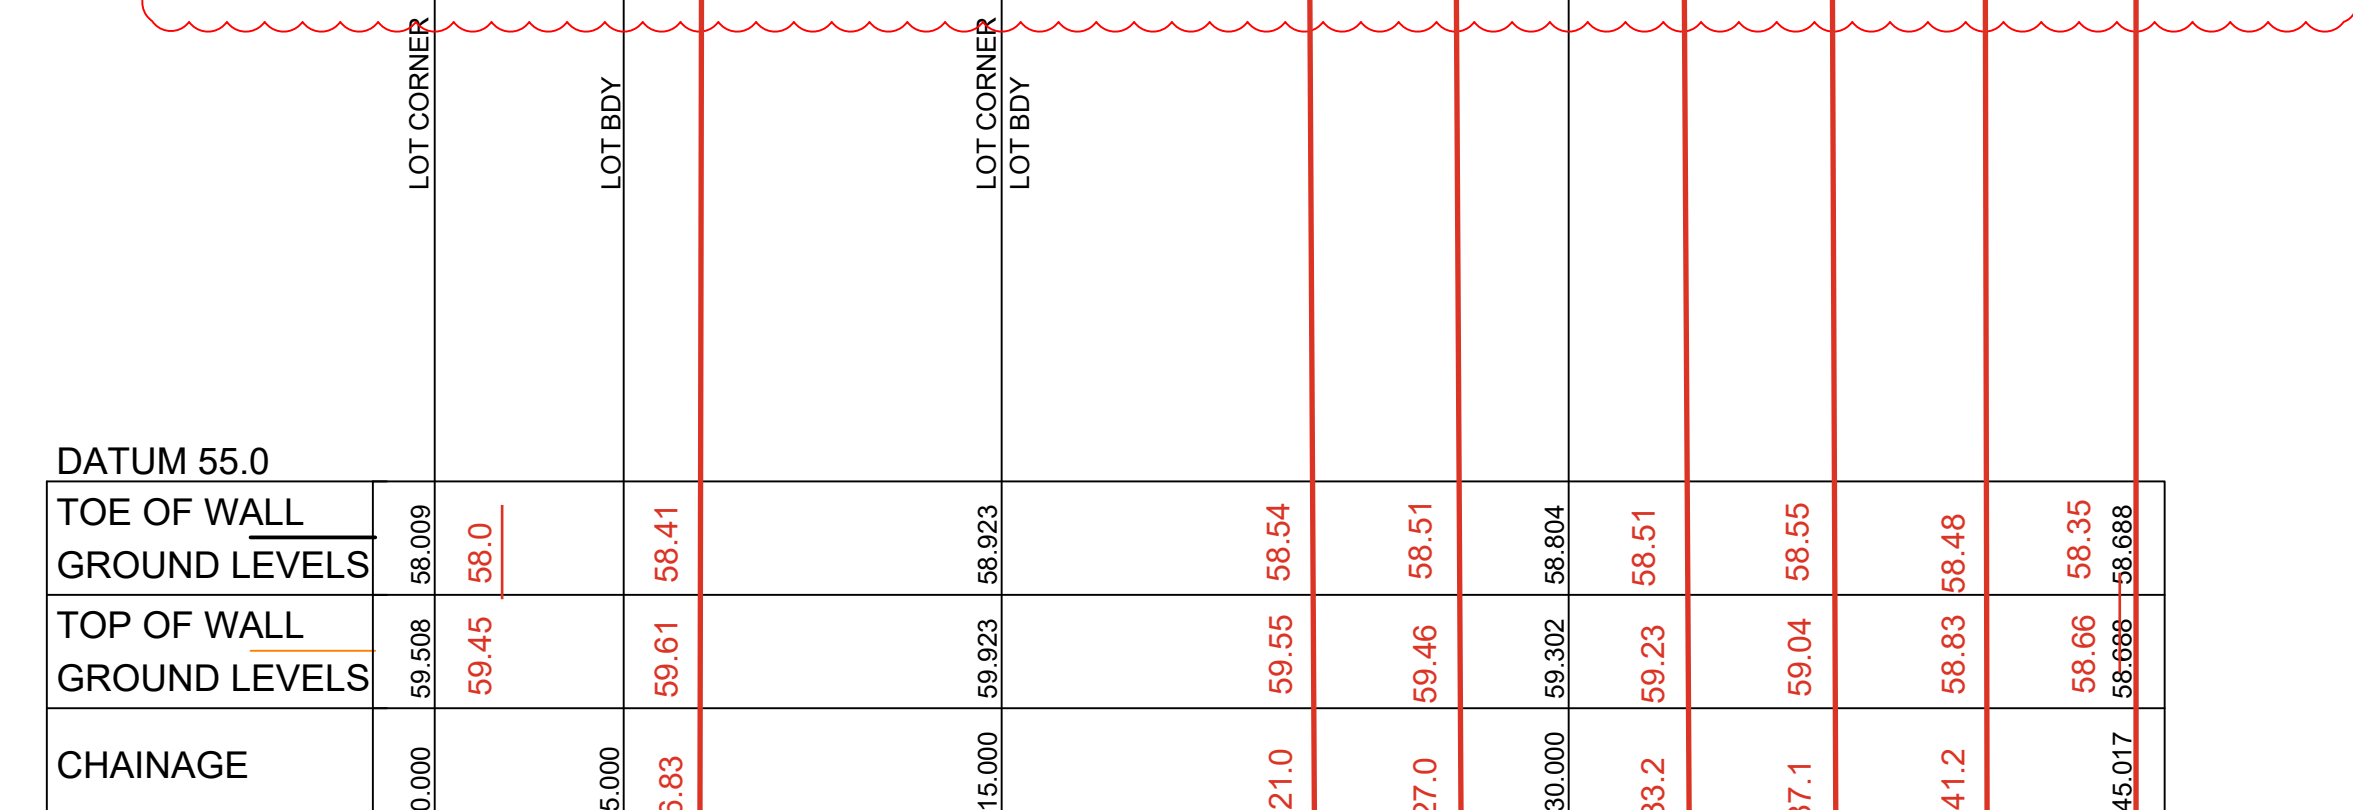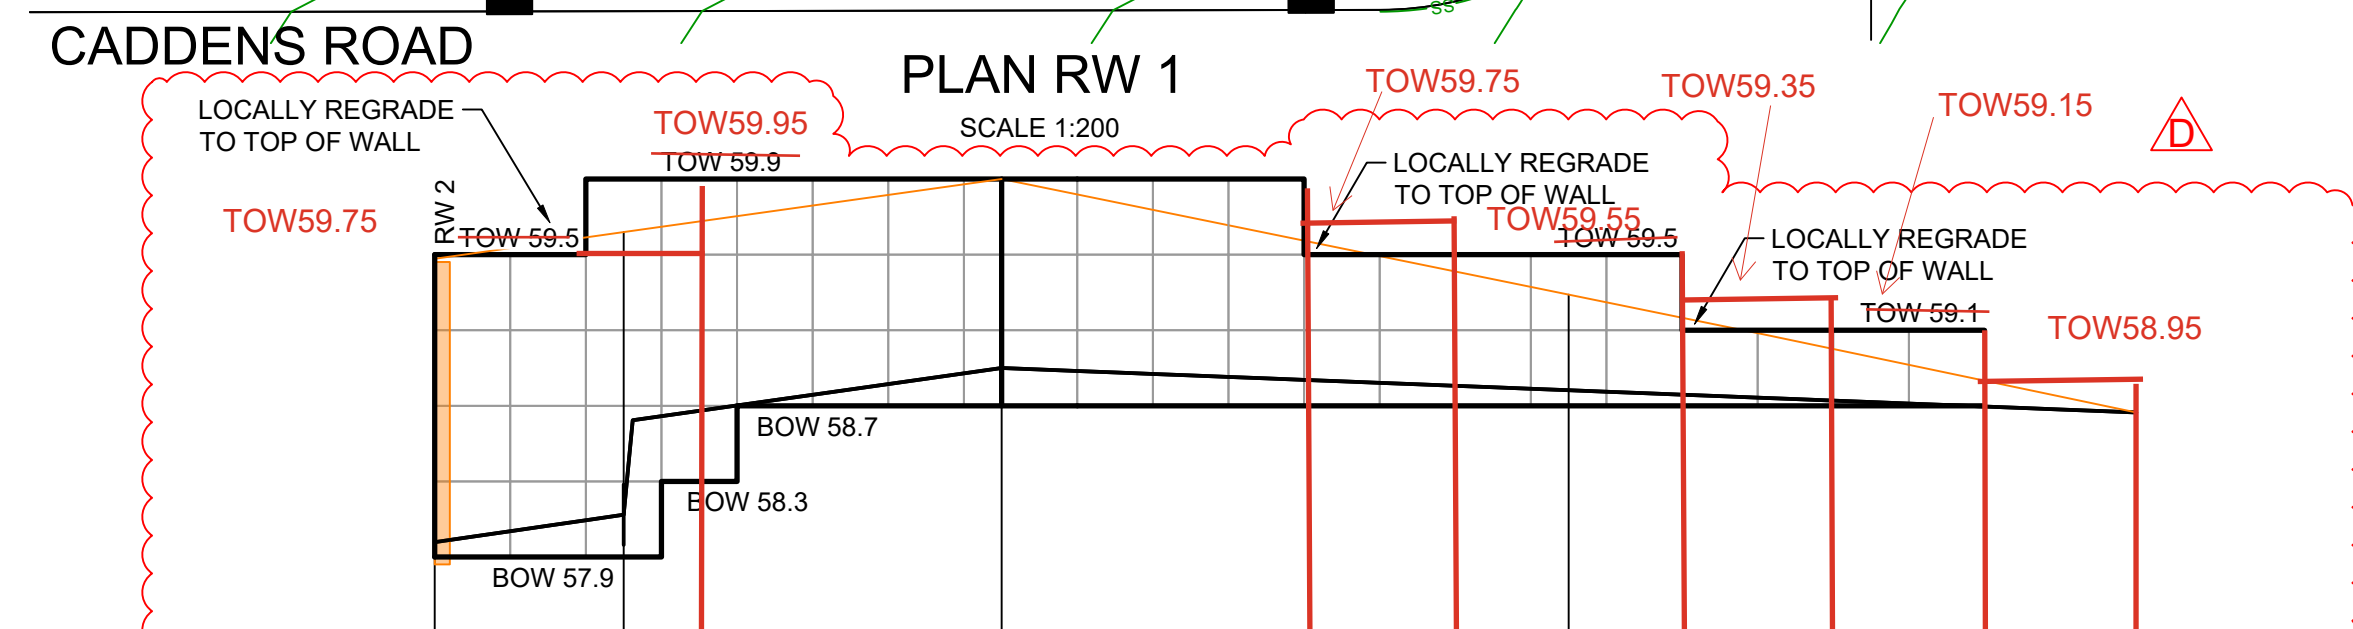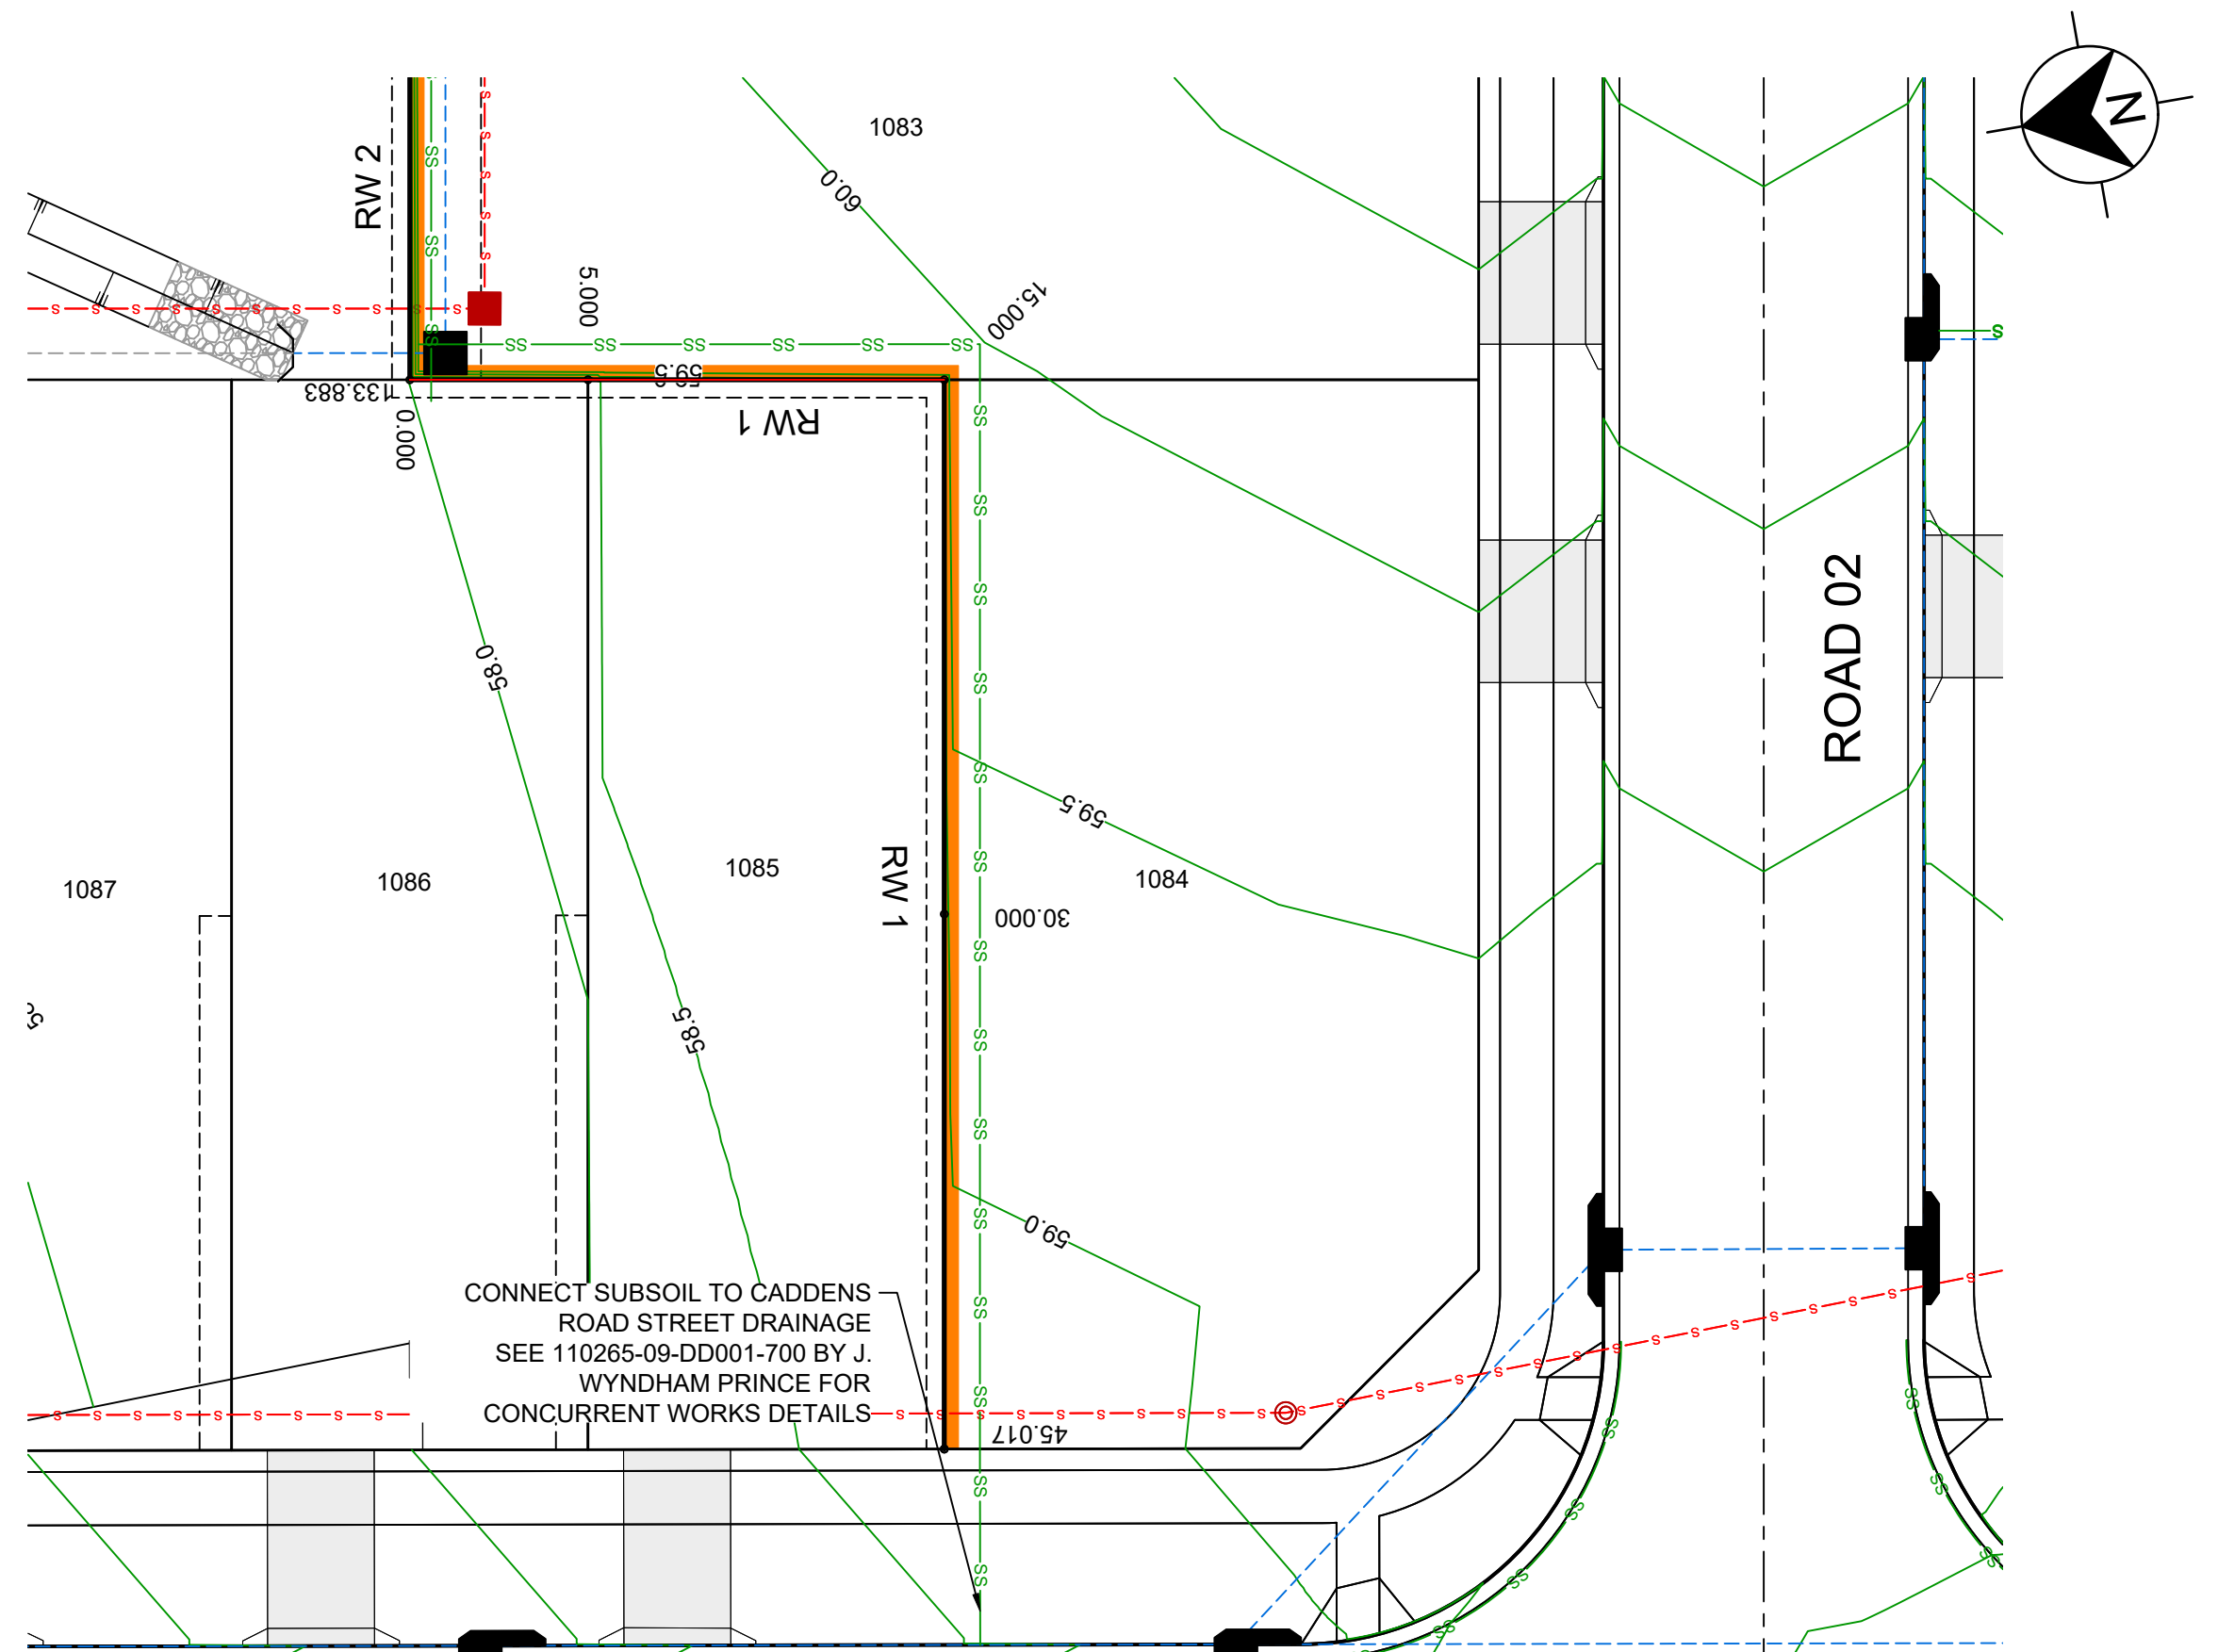




RW 1			
CHAINAGE	EASTING	NORTHING	BEARING
0	289777.98	6260318.74	279°49'01.42"
15	289763.2	6260321.3	
30	289765.76	6260336.07	9°49'01.32"
45.017	289768.32	6260350.88	9°49'01.32"

RW 1			
CHAINAGE	EASTING	NORTHING	BEARING
0	289777.98	6260318.74	279°49'01.42"
15	289763.2	6260321.3	
30	289765.76	6260336.07	9°49'01.32"
45.017	289768.32	6260350.88	9°49'01.32"

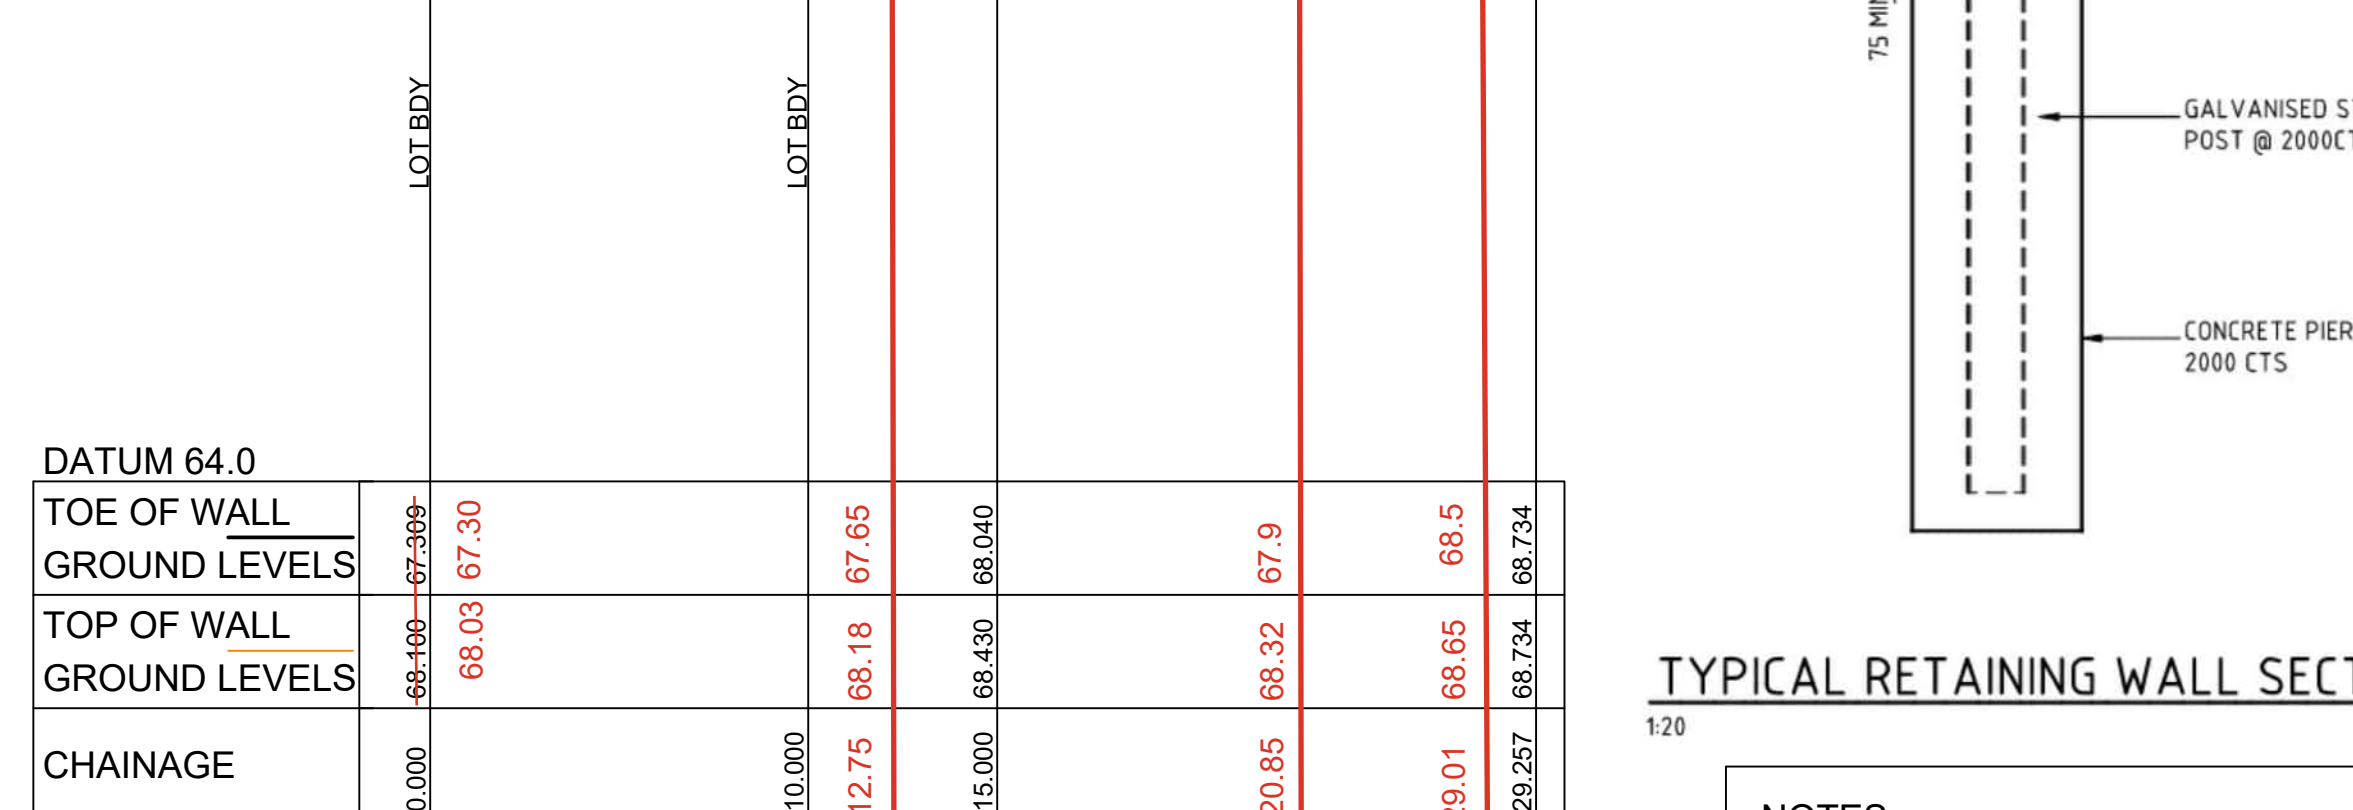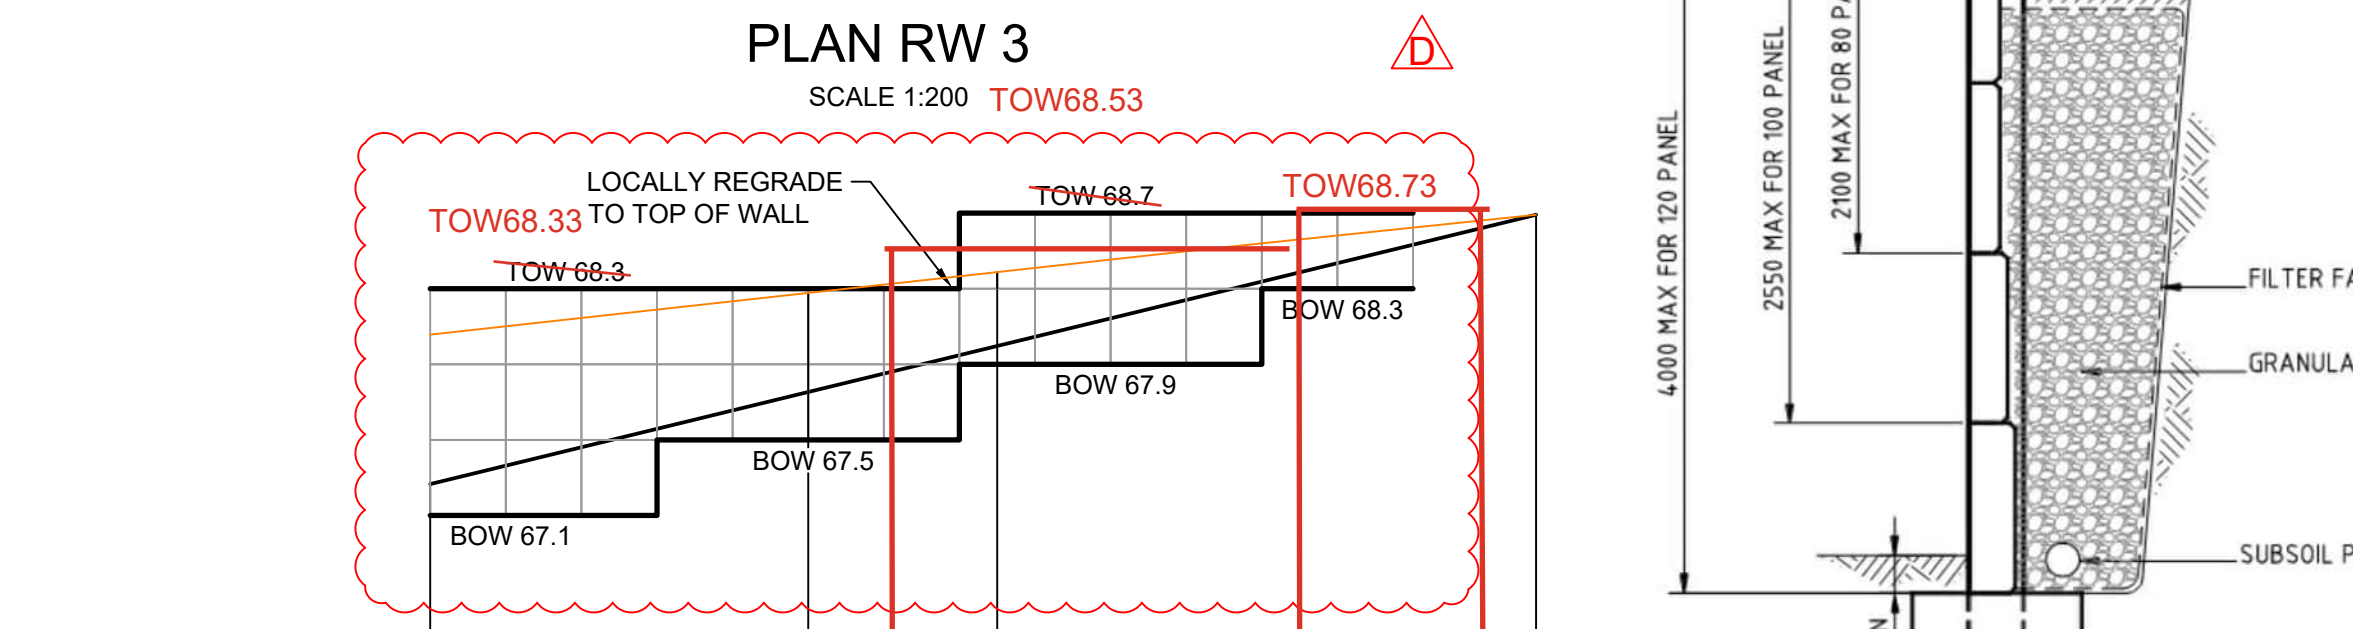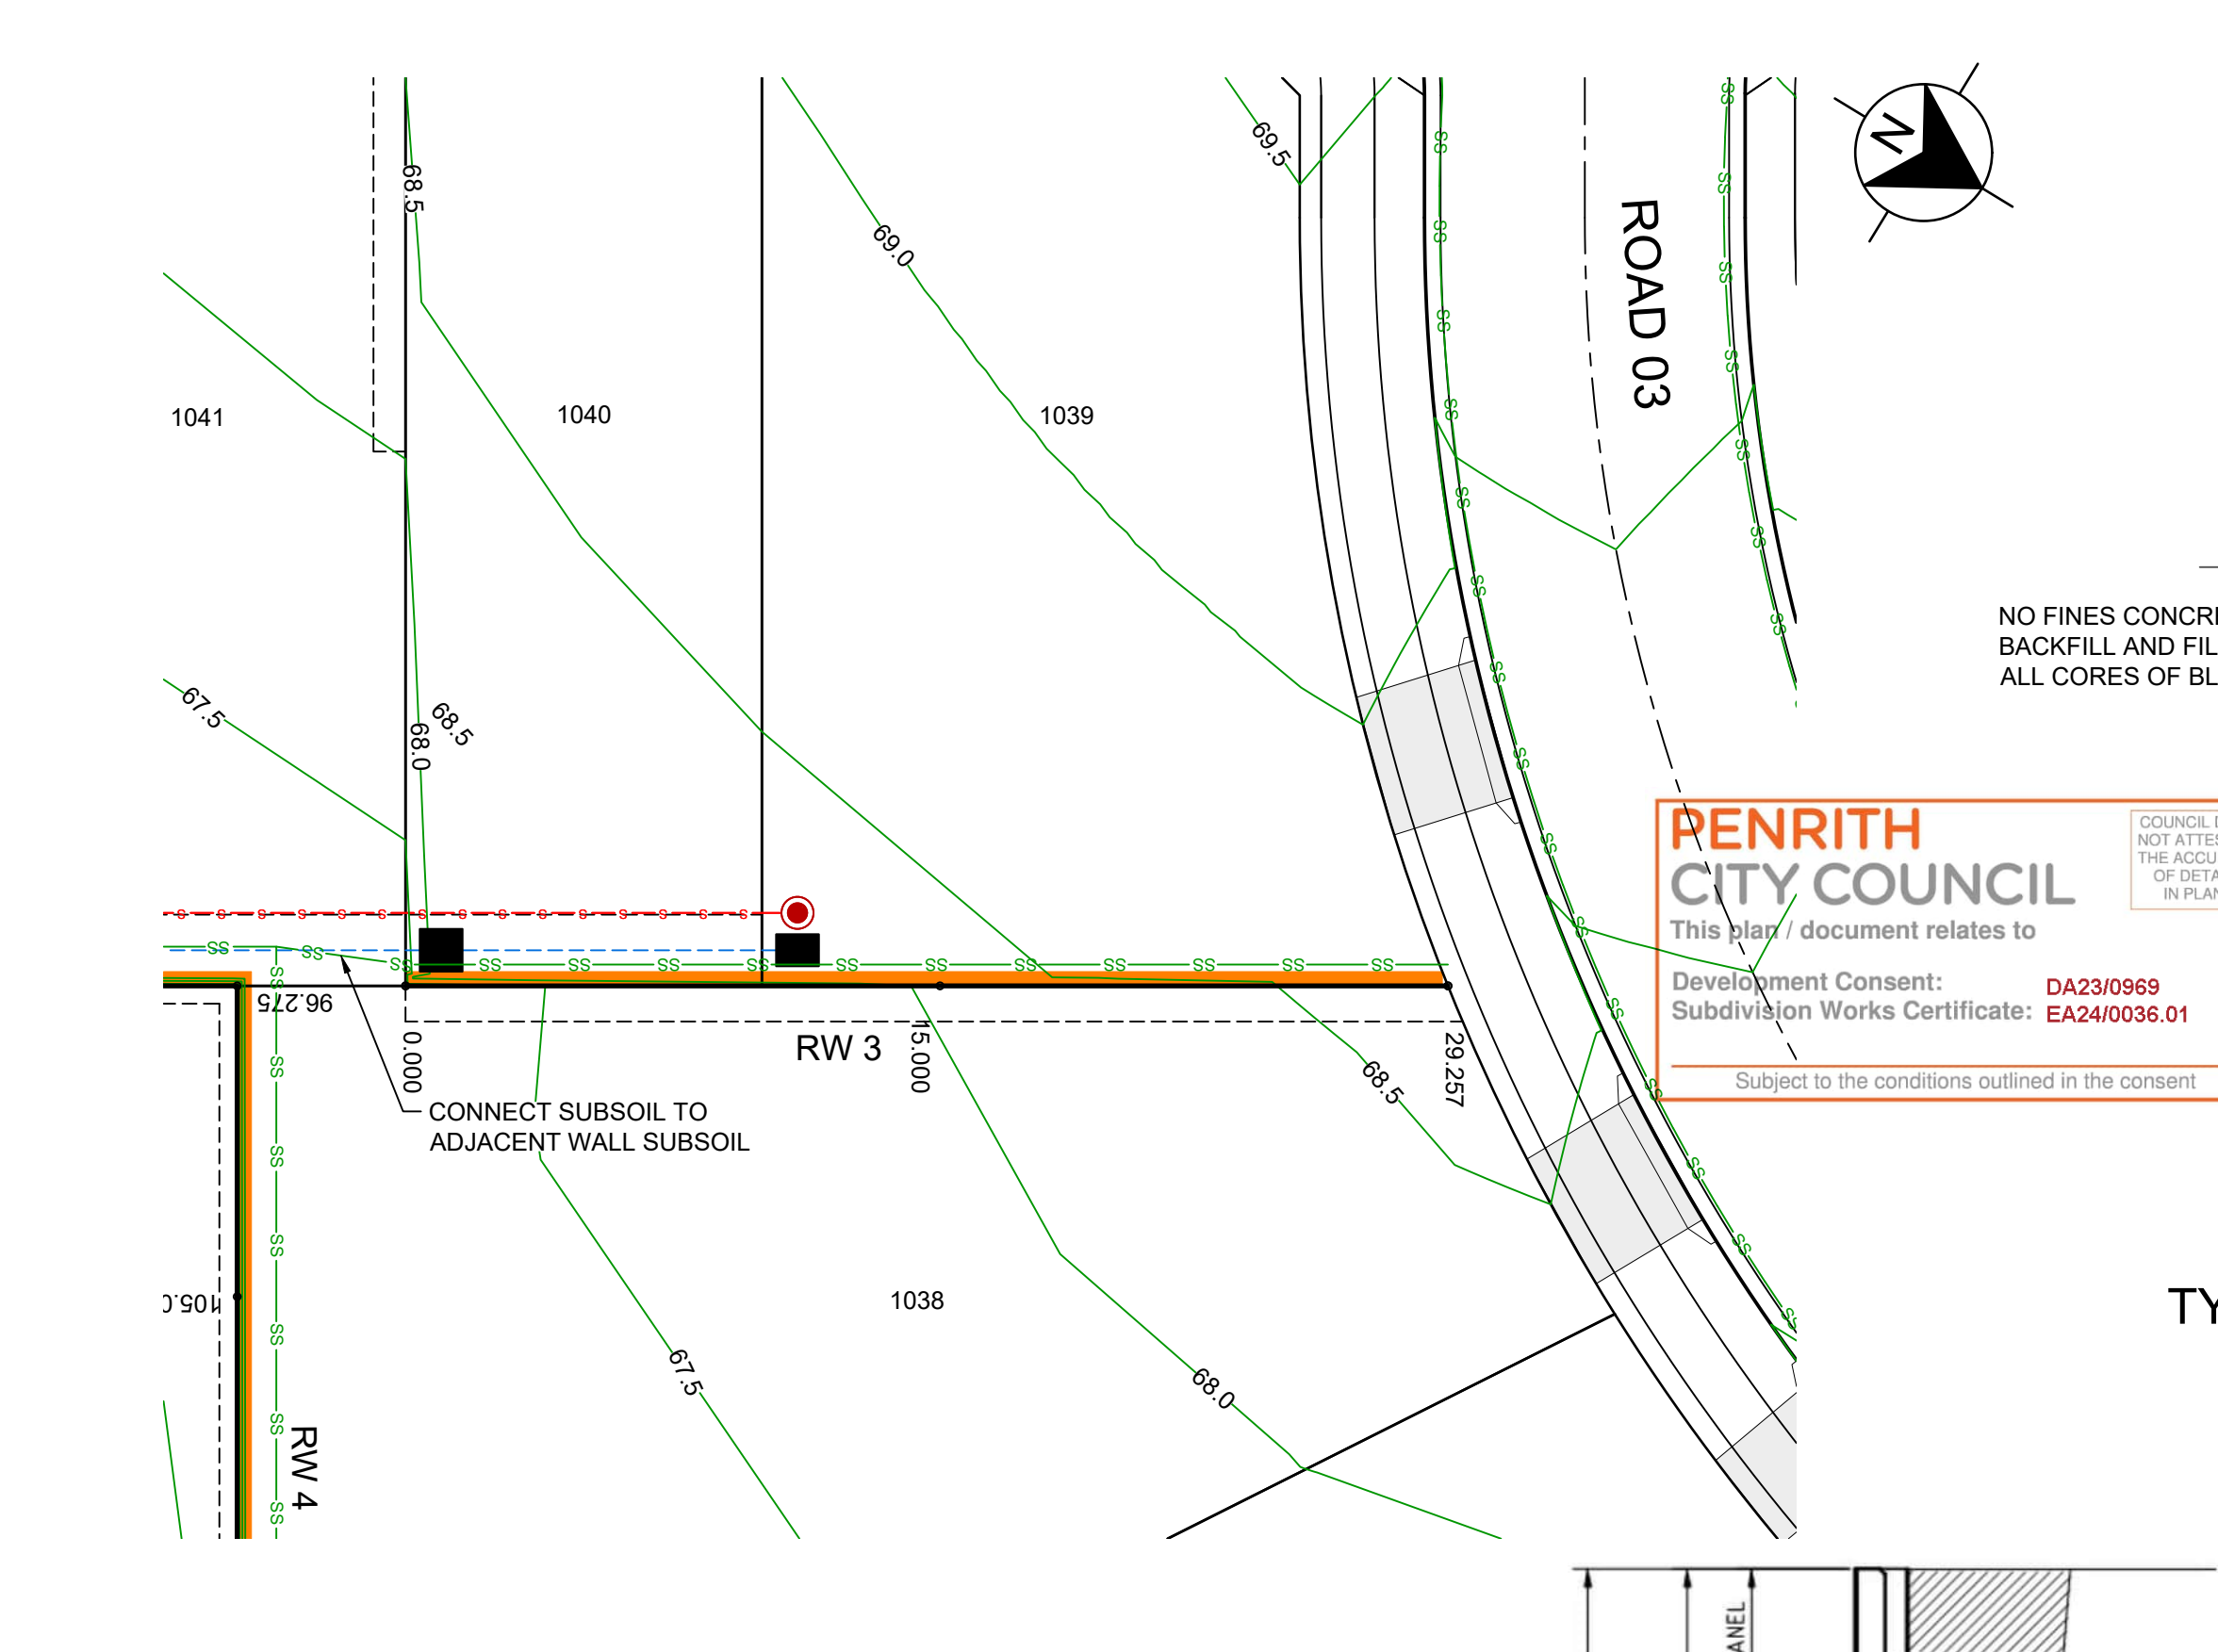

RW 3			
CHAINAGE	EASTING	NORTHING	BEARING
0	289667.25	6260246.12	328°15'22.39"
15	289659.35	6260258.88	328°15'22.39"
29.26	289651.85	6260271	328°15'22.39"

RW 3			
CHAINAGE	EASTING	NORTHING	BEARING
0	289667.25	6260246.12	328°15'22.39"
15	289659.35	6260258.88	328°15'22.39"
29.26	289651.85	6260271	328°15'22.39"

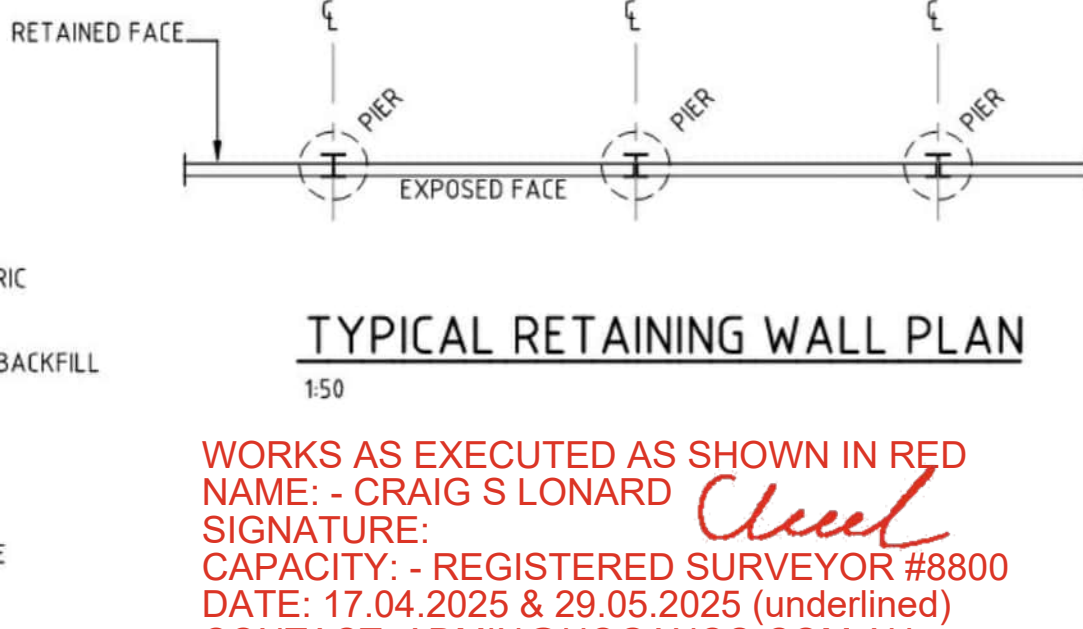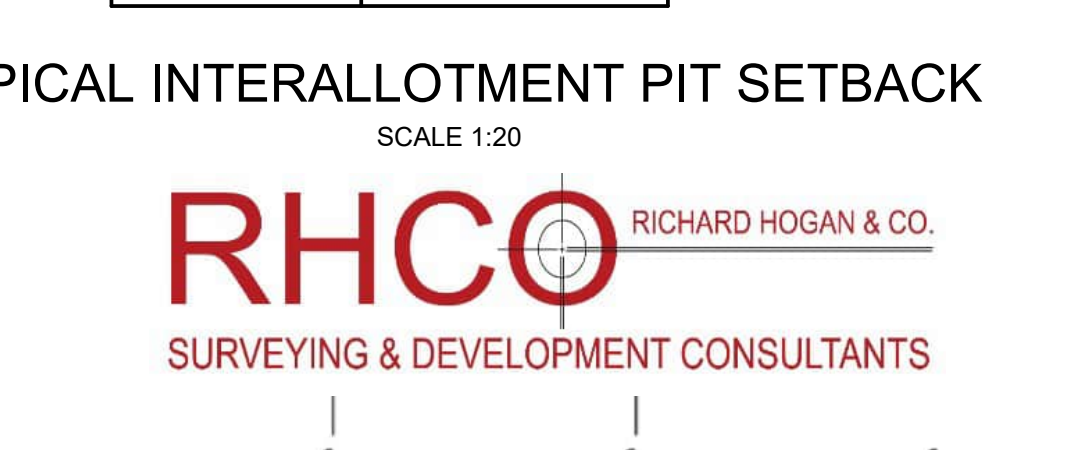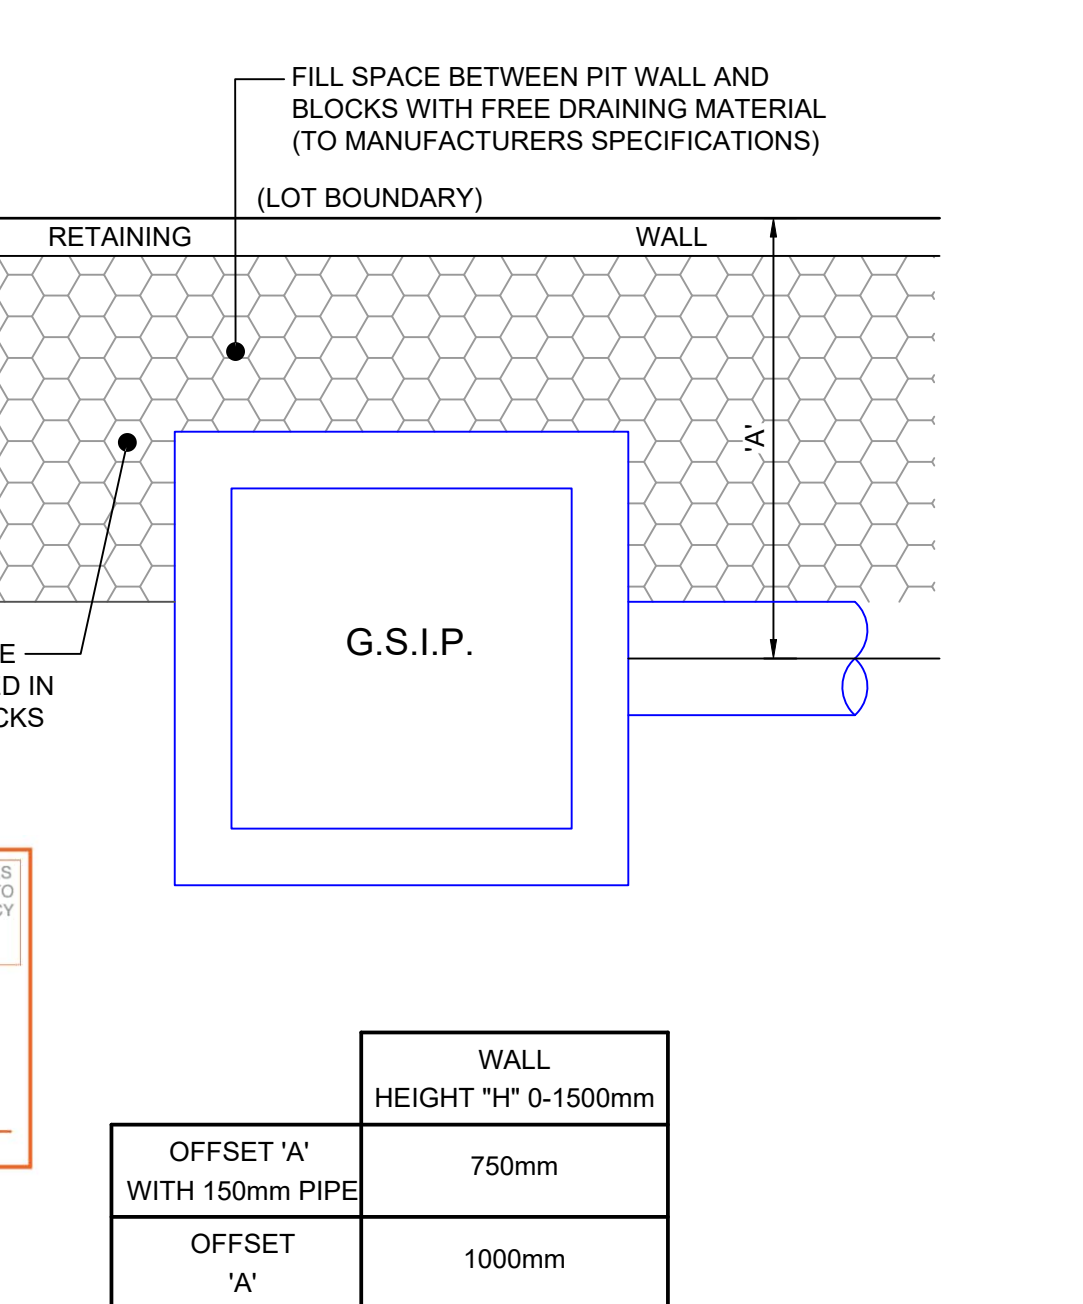

LEGEND	
	RETAINING WALL (SLEEPER WALL)
	INTERALLOTMENT DRAINAGE LINE & PIT
	DRAINAGE LINE & PIT
	SUBSOIL

NOTES:

- LOCALLY GRADE THE TOP & BOTTOM OF RETAINING WALL GROUND LEVELS TO MAINTAIN 1.5m MAX. VISIBLE HEIGHT
- RETAINING WALL PROFILES SHOWN ARE INDICATIVE ONLY.
- SUBJECT TO STRUCTURAL CERTIFICATION
- THE SUPPORTS/POSTS SHALL BE PAINTED TO MATCH THE SANDSTONE COLOURED PANELS FOR ALL THE RETAINING WALLS THAT FRONTS A PUBLIC ROAD. THIS INCLUDES THE FIRST 6m FROM THE STREET OF THE SIDE LOT RETAINING WALLS

1:20 (AT A1)	1:200 (AT A1)	1:400 (AT A3)
800 400 0 800 1600 2400 3200 4000	400 200 0 400 800 1200 1600 2000	4 2 0 4 8 12 16 20
MILLIMETRES	MILLIMETRES	METRES

J. WYNDHAM PRINCE
CONSULTING CIVIL INFRASTRUCTURE ENGINEERS & PROJECT MANAGERS

PO Box 4366 PENRITH WESTFIELD NSW 2750
P 02 4720 3300 W www.jwprince.com.au E jwp@jwprince.com.au



STATUS:
ISSUE FOR CONSTRUCTION

THIS DRAWING MUST NOT BE USED FOR CONSTRUCTION UNLESS SIGNED AS PART OF AN APPROVED CONSTRUCTION CERTIFICATE.

ORCHARD HILLS NORTH
STAGE 1 CADDENS ROAD
RETAINING WALL PLAN & LONGITUDINAL SECTIONS
SHEET 1

AZIMUTH: M.G.A. 2020 DATUM: A.H.D. ORIGIN: SSM 1112 PLAN No: 110265-09-DD1600

PROJECT No:
110265-09
SHEET No:
DD1600

D

Plotted: 14 November, 2024 9:54:54 AM File Name: C:\Synergy\WS\data\AS\JWP07110265_09 - Precinct 1 Development_110265-09-DD1600.dwg

LEGEND

RETAINING WALL (SLEEPER WALL)

INTERALLOTMENT DRAINAGE LINE & PIT

SS

NOTES:

LOCALLY GRADE THE TOP & BOTTOM OF RETAINING WALL GROUND LEVELS TO MAINTAIN 1.5m MAX. VISIBLE HEIGHT

RETAINING WALL PROFILES SHOWN ARE INDICATIVE ONLY. SUBJECT TO STRUCTURAL CERTIFICATION

THE SUPPORTS/POSTS SHALL BE PAINTED TO MATCH THE SANDSTONE COLOURED PANELS FOR ALL THE RETAINING WALLS THAT FRONTS A PUBLIC ROAD. THIS INCLUDES THE FIRST 6m FROM THE STREET OF THE SIDE LOT RETAINING WALLS


PENRITH CITY COUNCIL

This plan / document relates to


Development Consent: DA23/0969

Subdivision Works Certificate: EA24/0036.01

Subject to the conditions outlined in the consent

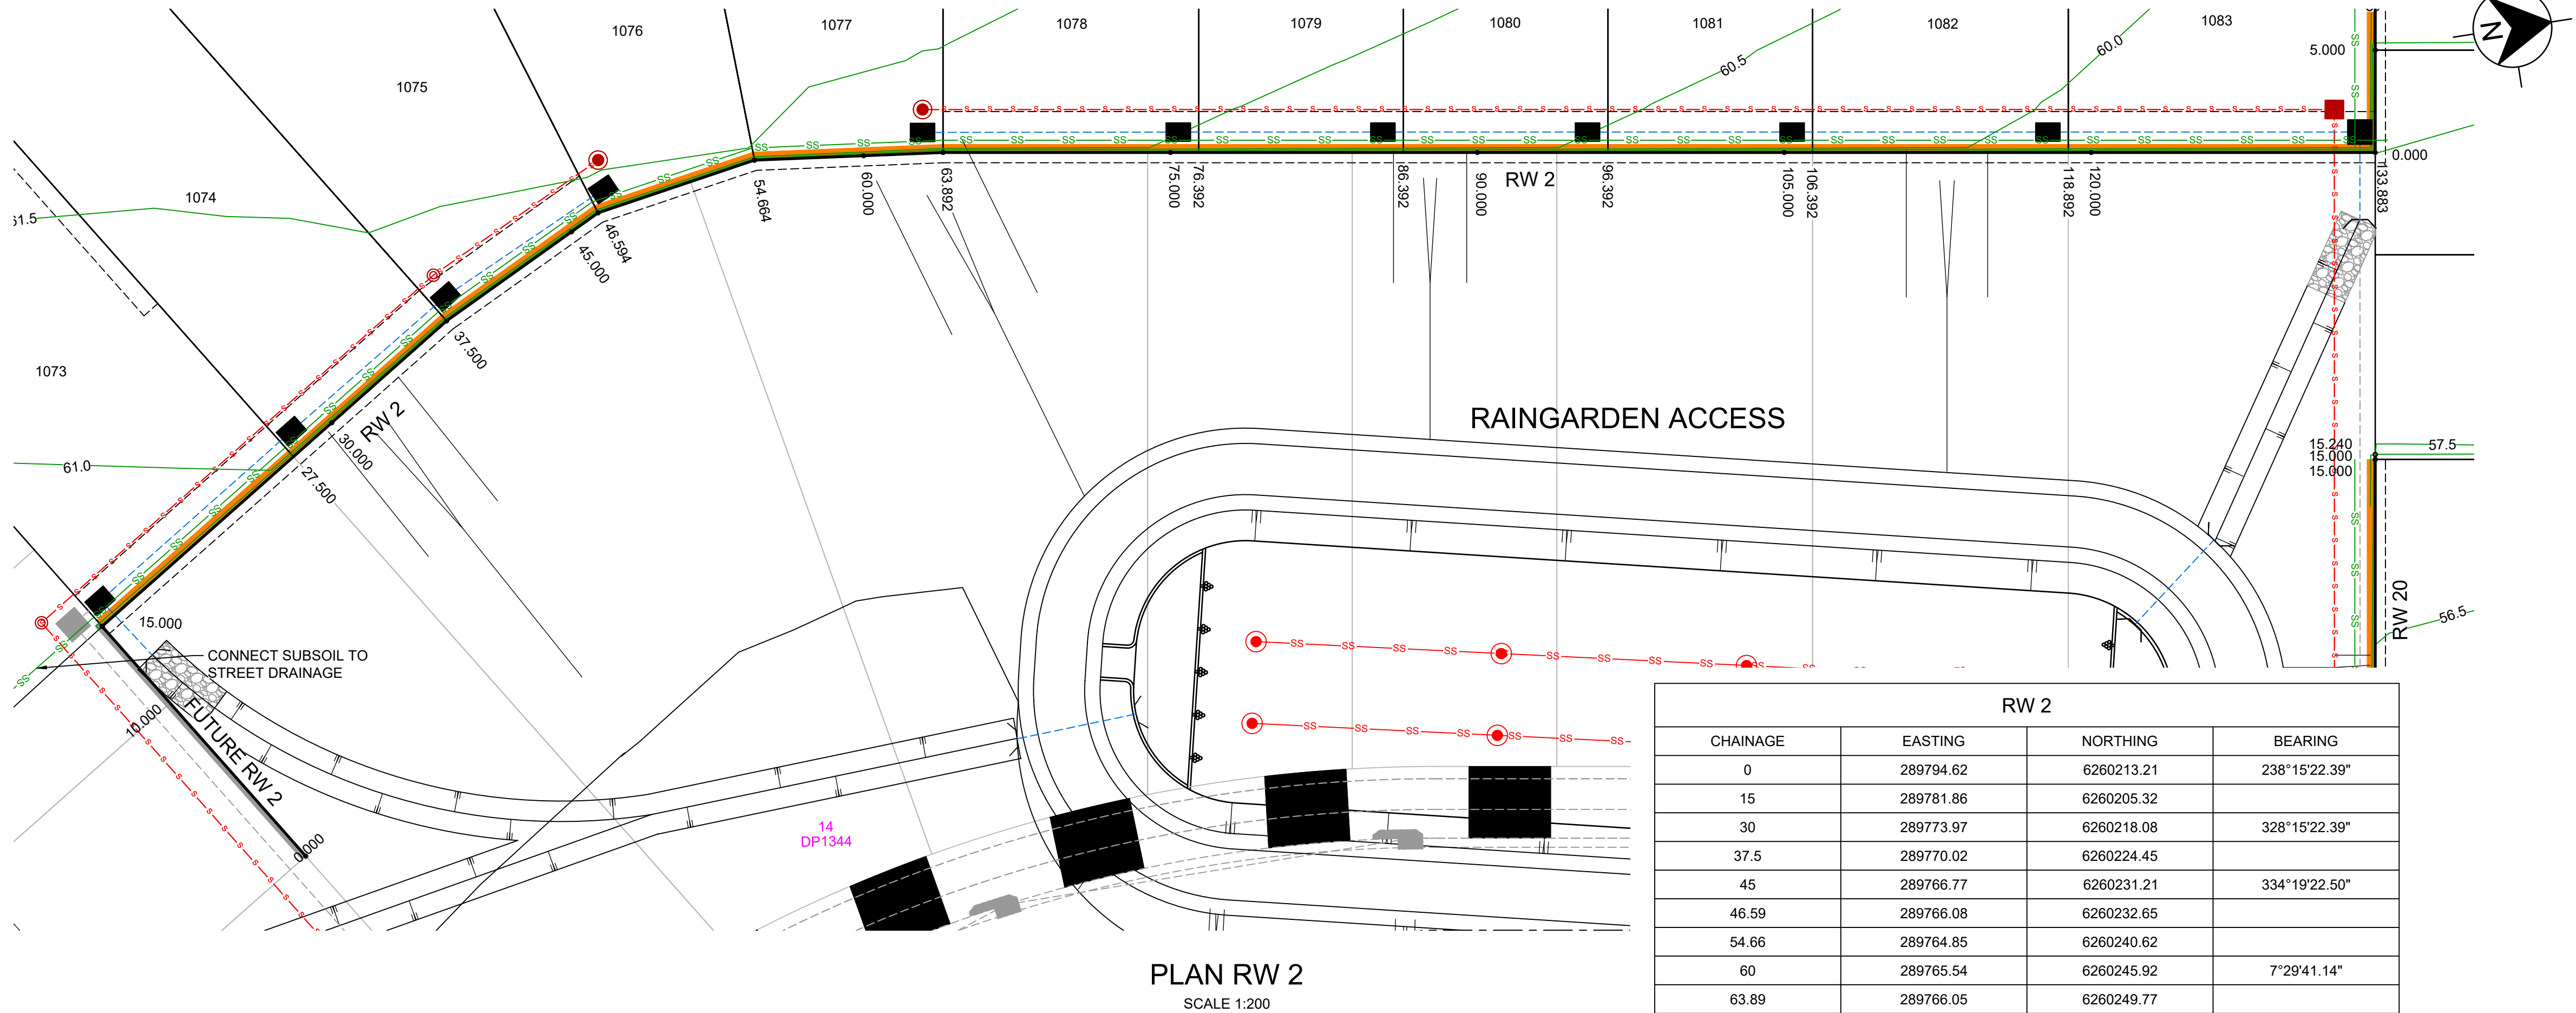

RW 2			
CHAINAGE	EASTING	NORTHING	BEARING
0	289794.62	6260213.21	238°15'22.39"
15	289781.86	6260205.32	
30	289773.97	6260218.08	328°15'22.39"
37.5	289770.02	6260224.45	
45	289766.77	6260231.21	334°19'22.50"
46.59	289766.08	6260232.65	
54.66	289764.85	6260240.62	
60	289765.54	6260245.92	7°29'41.14"
63.89	289766.05	6260249.77	
75	289767.94	6260260.72	9°49'01.32"
90	289770.5	6260275.5	9°49'01.32"
105	289773.06	6260290.28	9°49'01.32"
120	289775.62	6260305.06	9°49'01.32"
133.88	289777.98	6260318.74	9°49'01.32"

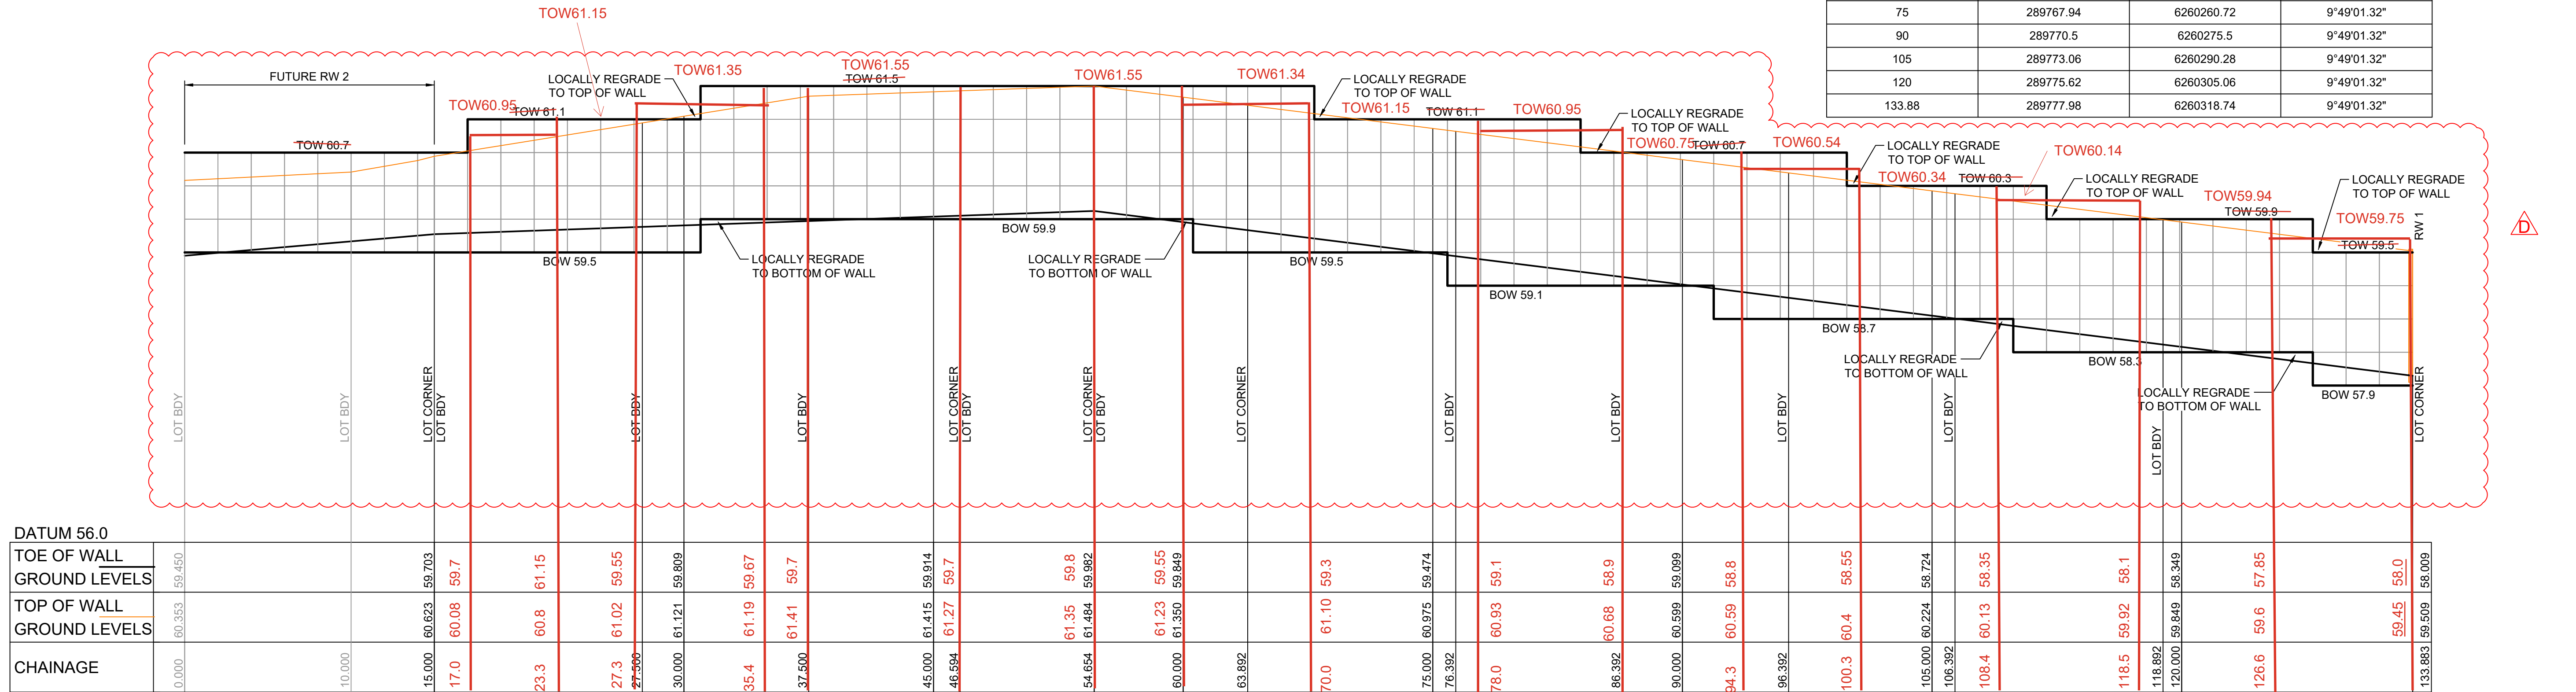

DATUM 56.0																
TOE OF WALL	GROUND LEVELS	0.000	10.000	15.000	17.0	23.3	27.3	27.560	30.000	35.4	37.500	45.000	46.594	54.654	60.000	63.892
TOP OF WALL	GROUND LEVELS	60.353		60.623	60.08	60.8	61.02	61.15	61.121	61.19	61.41	61.415	61.27	61.35	61.23	60.975
CHAINAGE		0.000	10.000	15.000	17.0	23.3	27.3	27.560	30.000	35.4	37.500	45.000	46.594	54.654	60.000	63.892

WORKS AS EXECUTED AS SHOWN IN RED
NAME: - CRAIG S LONARD
SIGNATURE: *Craig S Lonard*
CAPACITY: - REGISTERED SURVEYOR #8800
DATE: 17.04.2025 & 09.05.2025
CONTACT: ADMIN@HOGANCO.COM.AU


RHCO

RICHARD HOGAN & CO.

SURVEYING & DEVELOPMENT CONSULTANTS

LEVELS OBSERVED ON TOE OR RW 2 ARE
AT BEW LEVEL ONLY FSL TO BE CONSTRUCTED
AS PART OF STAGE 2 SWC WORKS

LONGITUDINAL SECTION RW 2
HORIZONTAL SCALE 1:200
VERTICAL SCALE 1:40

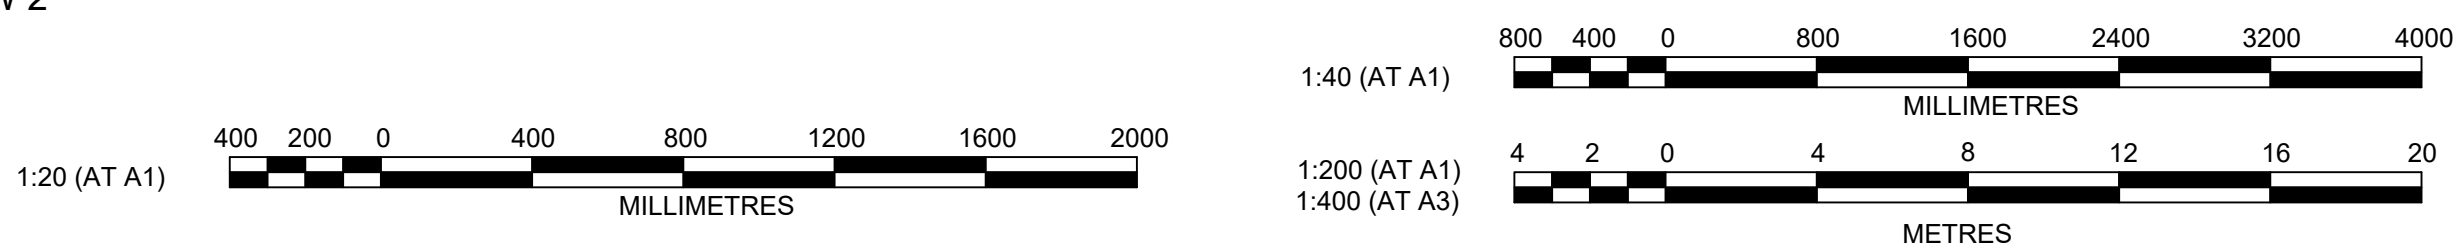

AMENDMENT	DES	DRN	CKD	APR	DATE
D	AMEND RETAINING WALL PROFILE TO SLEEPER WALL	MMC	EJ	MS	07/11/24
C	FOR CONSTRUCTION	MMC	GA	MS	27/09/24
B	LONG SECTIONS, SETOUT & TYPICAL ADDED	MMC	GA	DG	12/09/24
A	ISSUE FOR TENDER	MMC	GA	MS	10/04/24

J. WYNDHAM PRINCE

CONSULTING CIVIL INFRASTRUCTURE ENGINEERS & PROJECT MANAGERS

PO Box 4366 PENRITH WESTFIELD NSW 2750

P 02 4720 3300 W www.jwprince.com.au E jwp@jwprince.com.au

CLIENT:

LEGACYPROPERTY

STATUS:

ISSUE FOR CONSTRUCTION

THIS DRAWING MUST NOT BE USED FOR CONSTRUCTION UNLESS
SIGNED AS PART OF AN APPROVED CONSTRUCTION CERTIFICATE.

ORCHARD HILLS NORTH
STAGE 1 CADDENS ROAD
RETAINING WALL PLAN & LONGITUDINAL SECTIONS
SHEET 2

PROJECT No:
110265-09

SHEET No:
DD1601

AZIMUTH: M.G.A. 2020



DATUM: A.H.D.

ORIGIN: SSM 1112

PLAN No: 110265-09-DD1601

D

Plotted: 14 November, 2024 9:54:55 AM File Name: C:\Synergy\W\data\AS\JWP07110265_09 - Precinct 1 Development_1353\3\Design\DD\Stage 1 SWC\110265-09-DD1600.dwg

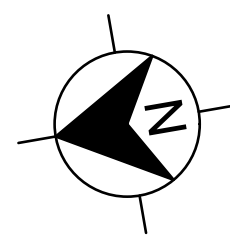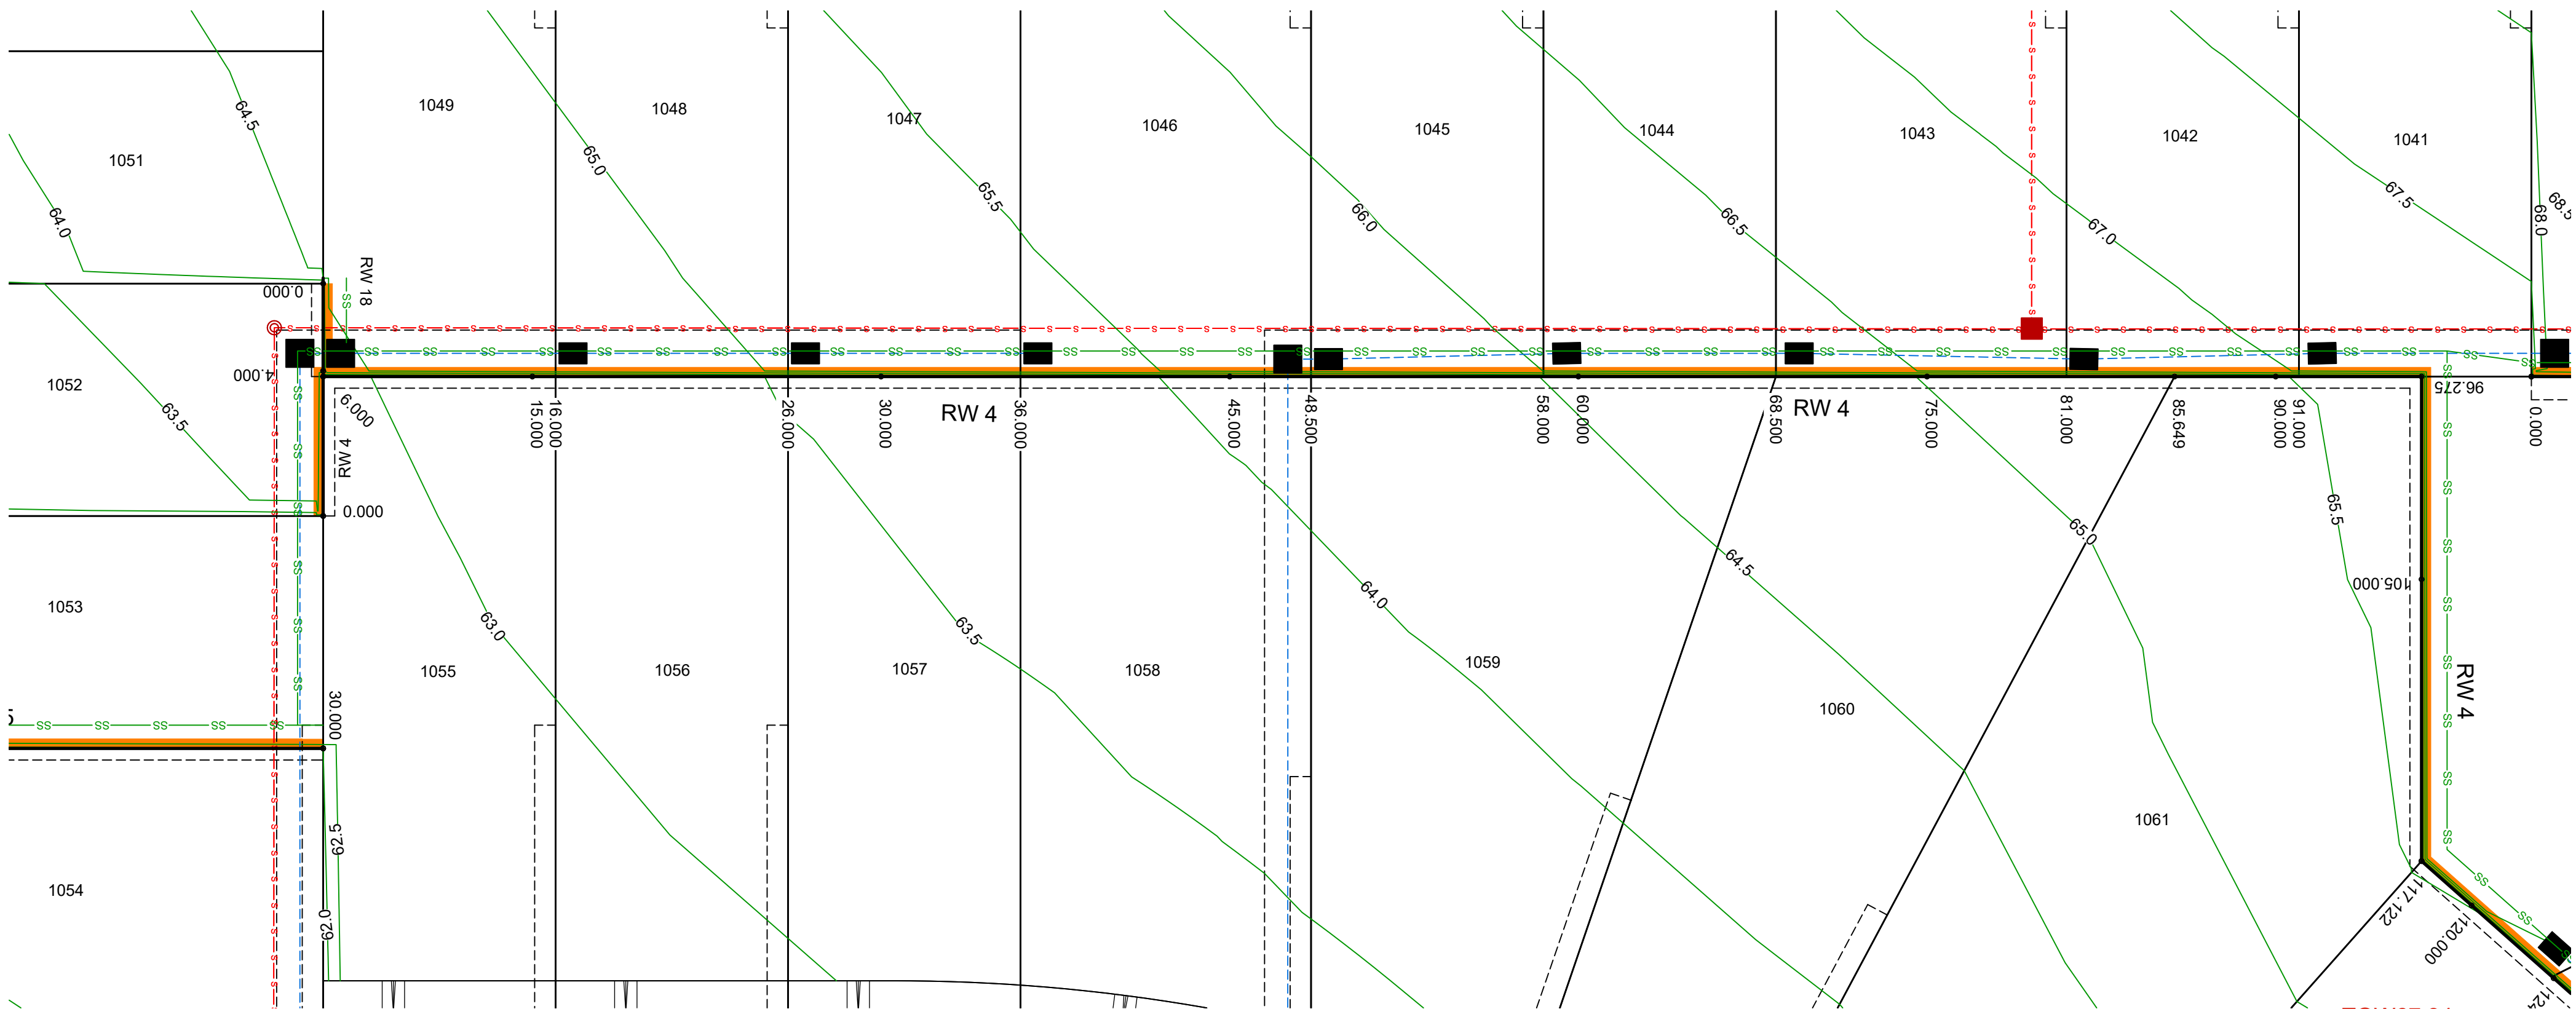


LEGEND	
	RETAINING WALL (SLEEPER WALL)
	INTERALLOTMENT DRAINAGE LINE & PIT
	DRAINAGE LINE & PIT
	SUBSOIL

- NOTES:
- LOCALLY GRADE THE TOP & BOTTOM OF RETAINING WALL GROUND LEVELS TO MAINTAIN 1.5m MAX. VISIBLE HEIGHT
 - RETAINING WALL PROFILES SHOWN ARE INDICATIVE ONLY. SUBJECT TO STRUCTURAL CERTIFICATION
 - THE SUPPORTS/POSTS SHALL BE PAINTED TO MATCH THE SANDSTONE COLOURED PANELS FOR ALL THE RETAINING WALLS THAT FRONTS A PUBLIC ROAD. THIS INCLUDES THE FIRST 6m FROM THE STREET OF THE SIDE LOT RETAINING WALLS

WORKS AS EXECUTED AS SHOWN IN RED
NAME: - CRAIG S LONARD
SIGNATURE:
CAPACITY: - REGISTERED SURVEYOR #8800
DATE: 17.04.2025 & 09.05.2025
CONTACT: ADMIN@HOGANCO.COM.AU



RHCO RICHARD HOGAN & CO.
SURVEYING & DEVELOPMENT CONSULTANTS

RW 4			
CHAINAGE	EASTING	NORTHING	BEARING
0	289722.33	6260168.49	238°15'22.39"
6	289717.23	6260165.33	
15	289712.49	6260172.99	328°15'22.39"
30	289704.6	6260185.74	328°15'22.39"
45	289696.71	6260198.5	328°15'22.39"
60	289688.82	6260211.26	328°15'22.39"
75	289680.93	6260224.01	328°15'22.39"
90	289673.03	6260236.77	328°15'22.39"
96.27	289669.73	6260242.1	
105	289677.15	6260246.7	58°15'22.39"
117.12	289687.46	6260253.07	
120	289687.95	6260255.91	9°49'01.32"
135	289690.51	6260270.69	9°49'01.32"
150	289693.07	6260285.47	9°49'01.32"
165	289695.63	6260300.25	9°49'01.32"
180	289698.18	6260315.03	9°49'01.32"
195	289700.74	6260329.81	9°49'01.32"
197.12	289701.10	6260331.90	9°49'01.32"

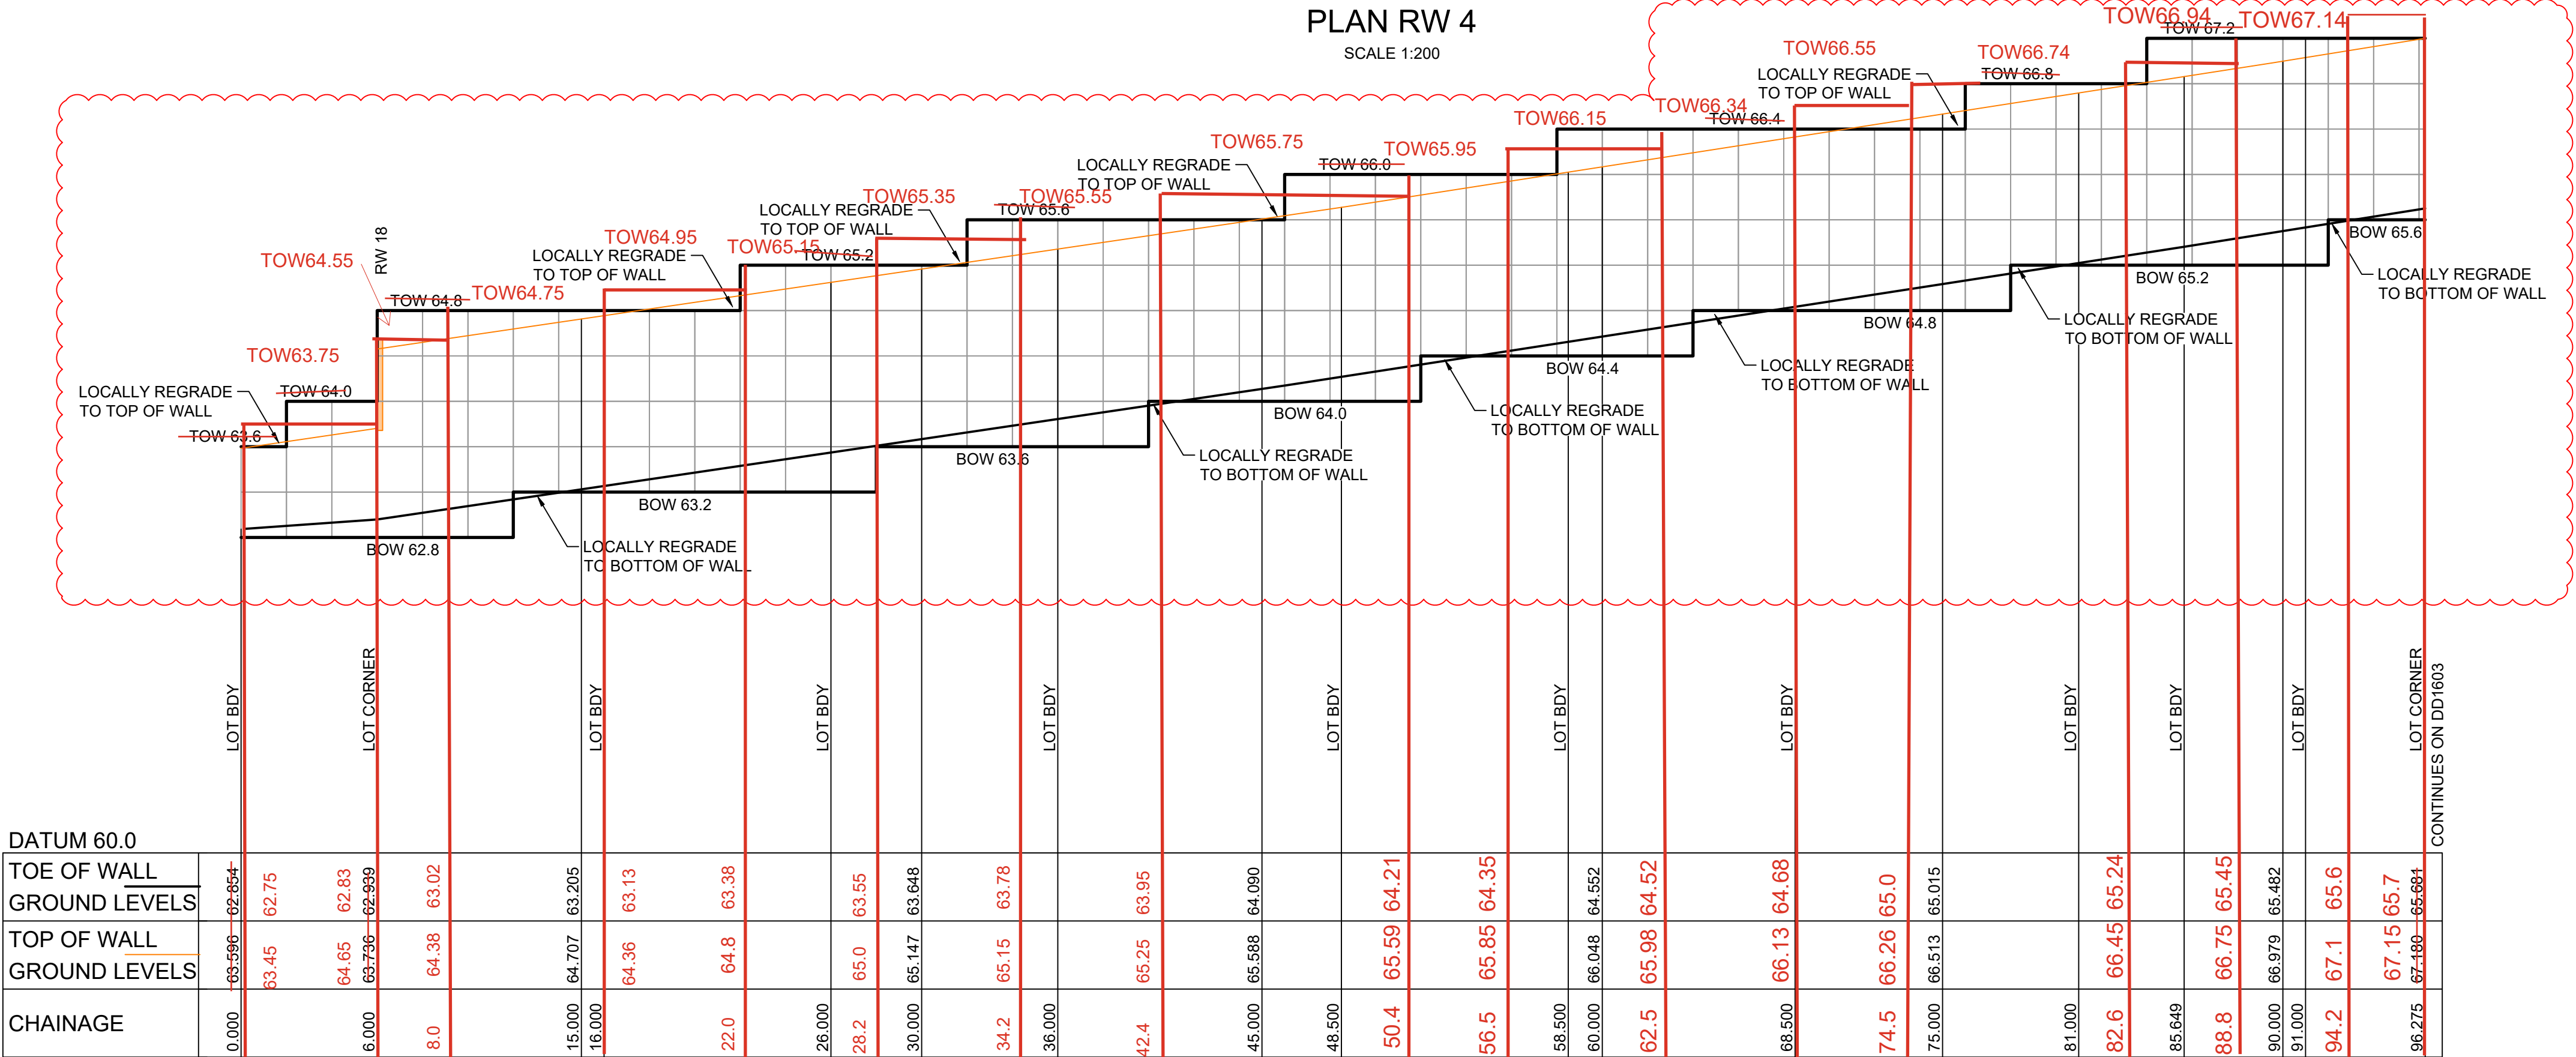

DATUM 60.0	
TOE OF WALL	GROUND LEVELS
0.000	62.596
6.000	62.596
8.0	62.596
15.000	62.596
16.000	62.596
22.0	62.596
26.000	62.596
28.2	62.596
30.000	62.596
34.2	62.596
36.000	62.596
42.4	62.596
45.000	62.596
48.500	62.596
50.4	62.596
56.5	62.596
58.500	62.596
60.000	62.596
62.5	62.596
68.500	62.596
74.5	62.596
75.000	62.596
81.000	62.596
82.6	62.596
85.649	62.596
88.8	62.596
90.000	62.596
91.000	62.596
94.2	62.596
96.275	62.596

LONGITUDINAL SECTION RW 4
HORIZONTAL SCALE 1:200
VERTICAL SCALE 1:40

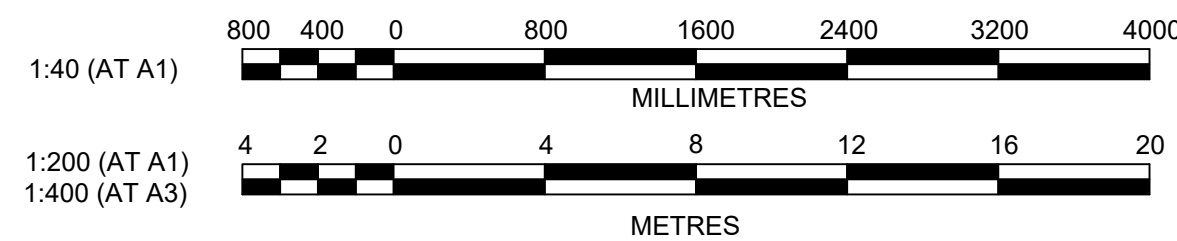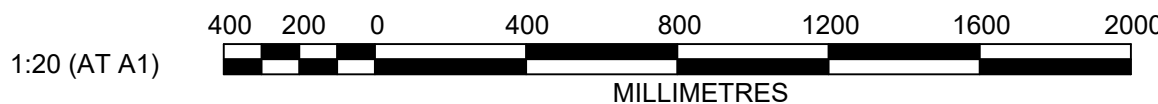

AMENDMENT	DES	DRN	CKD	APR	DATE
D	AMEND RETAINING WALL PROFILE TO SLEEPER WALL	MMC	EJ	MS	07/11/24
C	FOR CONSTRUCTION	MMC	GA	MS	27/09/24
B	LONG SECTIONS, SETOUT & TYPICAL ADDED	MMC	GA	DG	12/09/24
A	ISSUE FOR TENDER	MMC	GA	MS	10/04/24

J. WYNDHAM PRINCE
CONSULTING CIVIL INFRASTRUCTURE ENGINEERS & PROJECT MANAGERS

PO Box 4366 PENRITH WESTFIELD NSW 2750
P 02 4720 3300 W www.jwprince.com.au E jwp@jwprince.com.au



STATUS:
ISSUE FOR CONSTRUCTION


THIS DRAWING MUST NOT BE USED FOR CONSTRUCTION UNLESS SIGNED AS PART OF AN APPROVED CONSTRUCTION CERTIFICATE.

ORCHARD HILLS NORTH
STAGE 1 CADDENS ROAD
RETAINING WALL PLAN & LONGITUDINAL SECTIONS
SHEET 3

AZIMUTH: M.G.A. 2020 DATUM: A.H.D. ORIGIN: SSM 1112 PLAN No: 110265-09-DD1602

PROJECT No:
110265-09
SHEET No:
DD1602


D

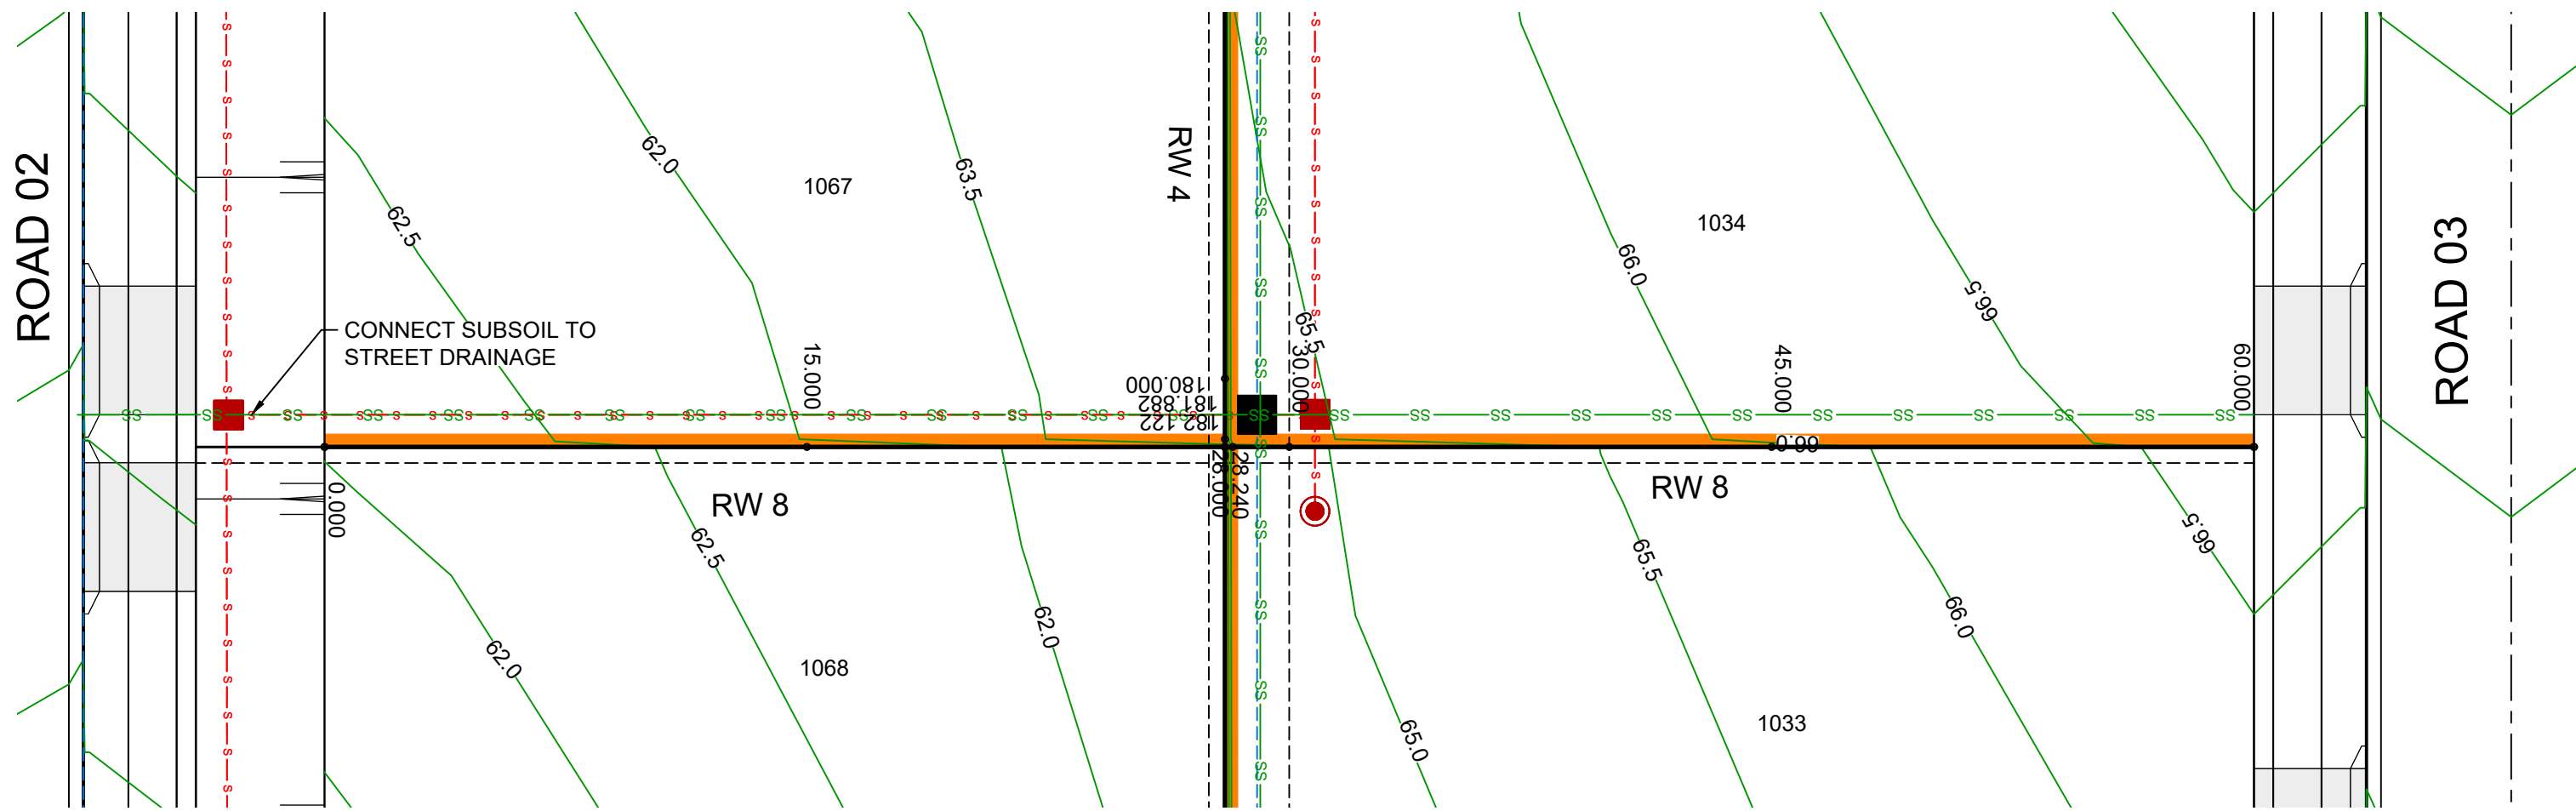

PLAN RW 8
SCALE 1:200


NOTES:

- LOCALLY GRADE THE TOP & BOTTOM OF RETAINING WALL GROUND LEVELS TO MAINTAIN 1.5m MAX. VISIBLE HEIGHT
- RETAINING WALL PROFILES SHOWN ARE INDICATIVE ONLY. SUBJECT TO STRUCTURAL CERTIFICATION
- THE SUPPORTS/POSTS SHALL BE PAINTED TO MATCH THE SANDSTONE COLOURED PANELS FOR ALL THE RETAINING WALLS THAT FRONTS A PUBLIC ROAD. THIS INCLUDES THE FIRST 6m FROM THE STREET OF THE SIDE LOT RETAINING WALLS

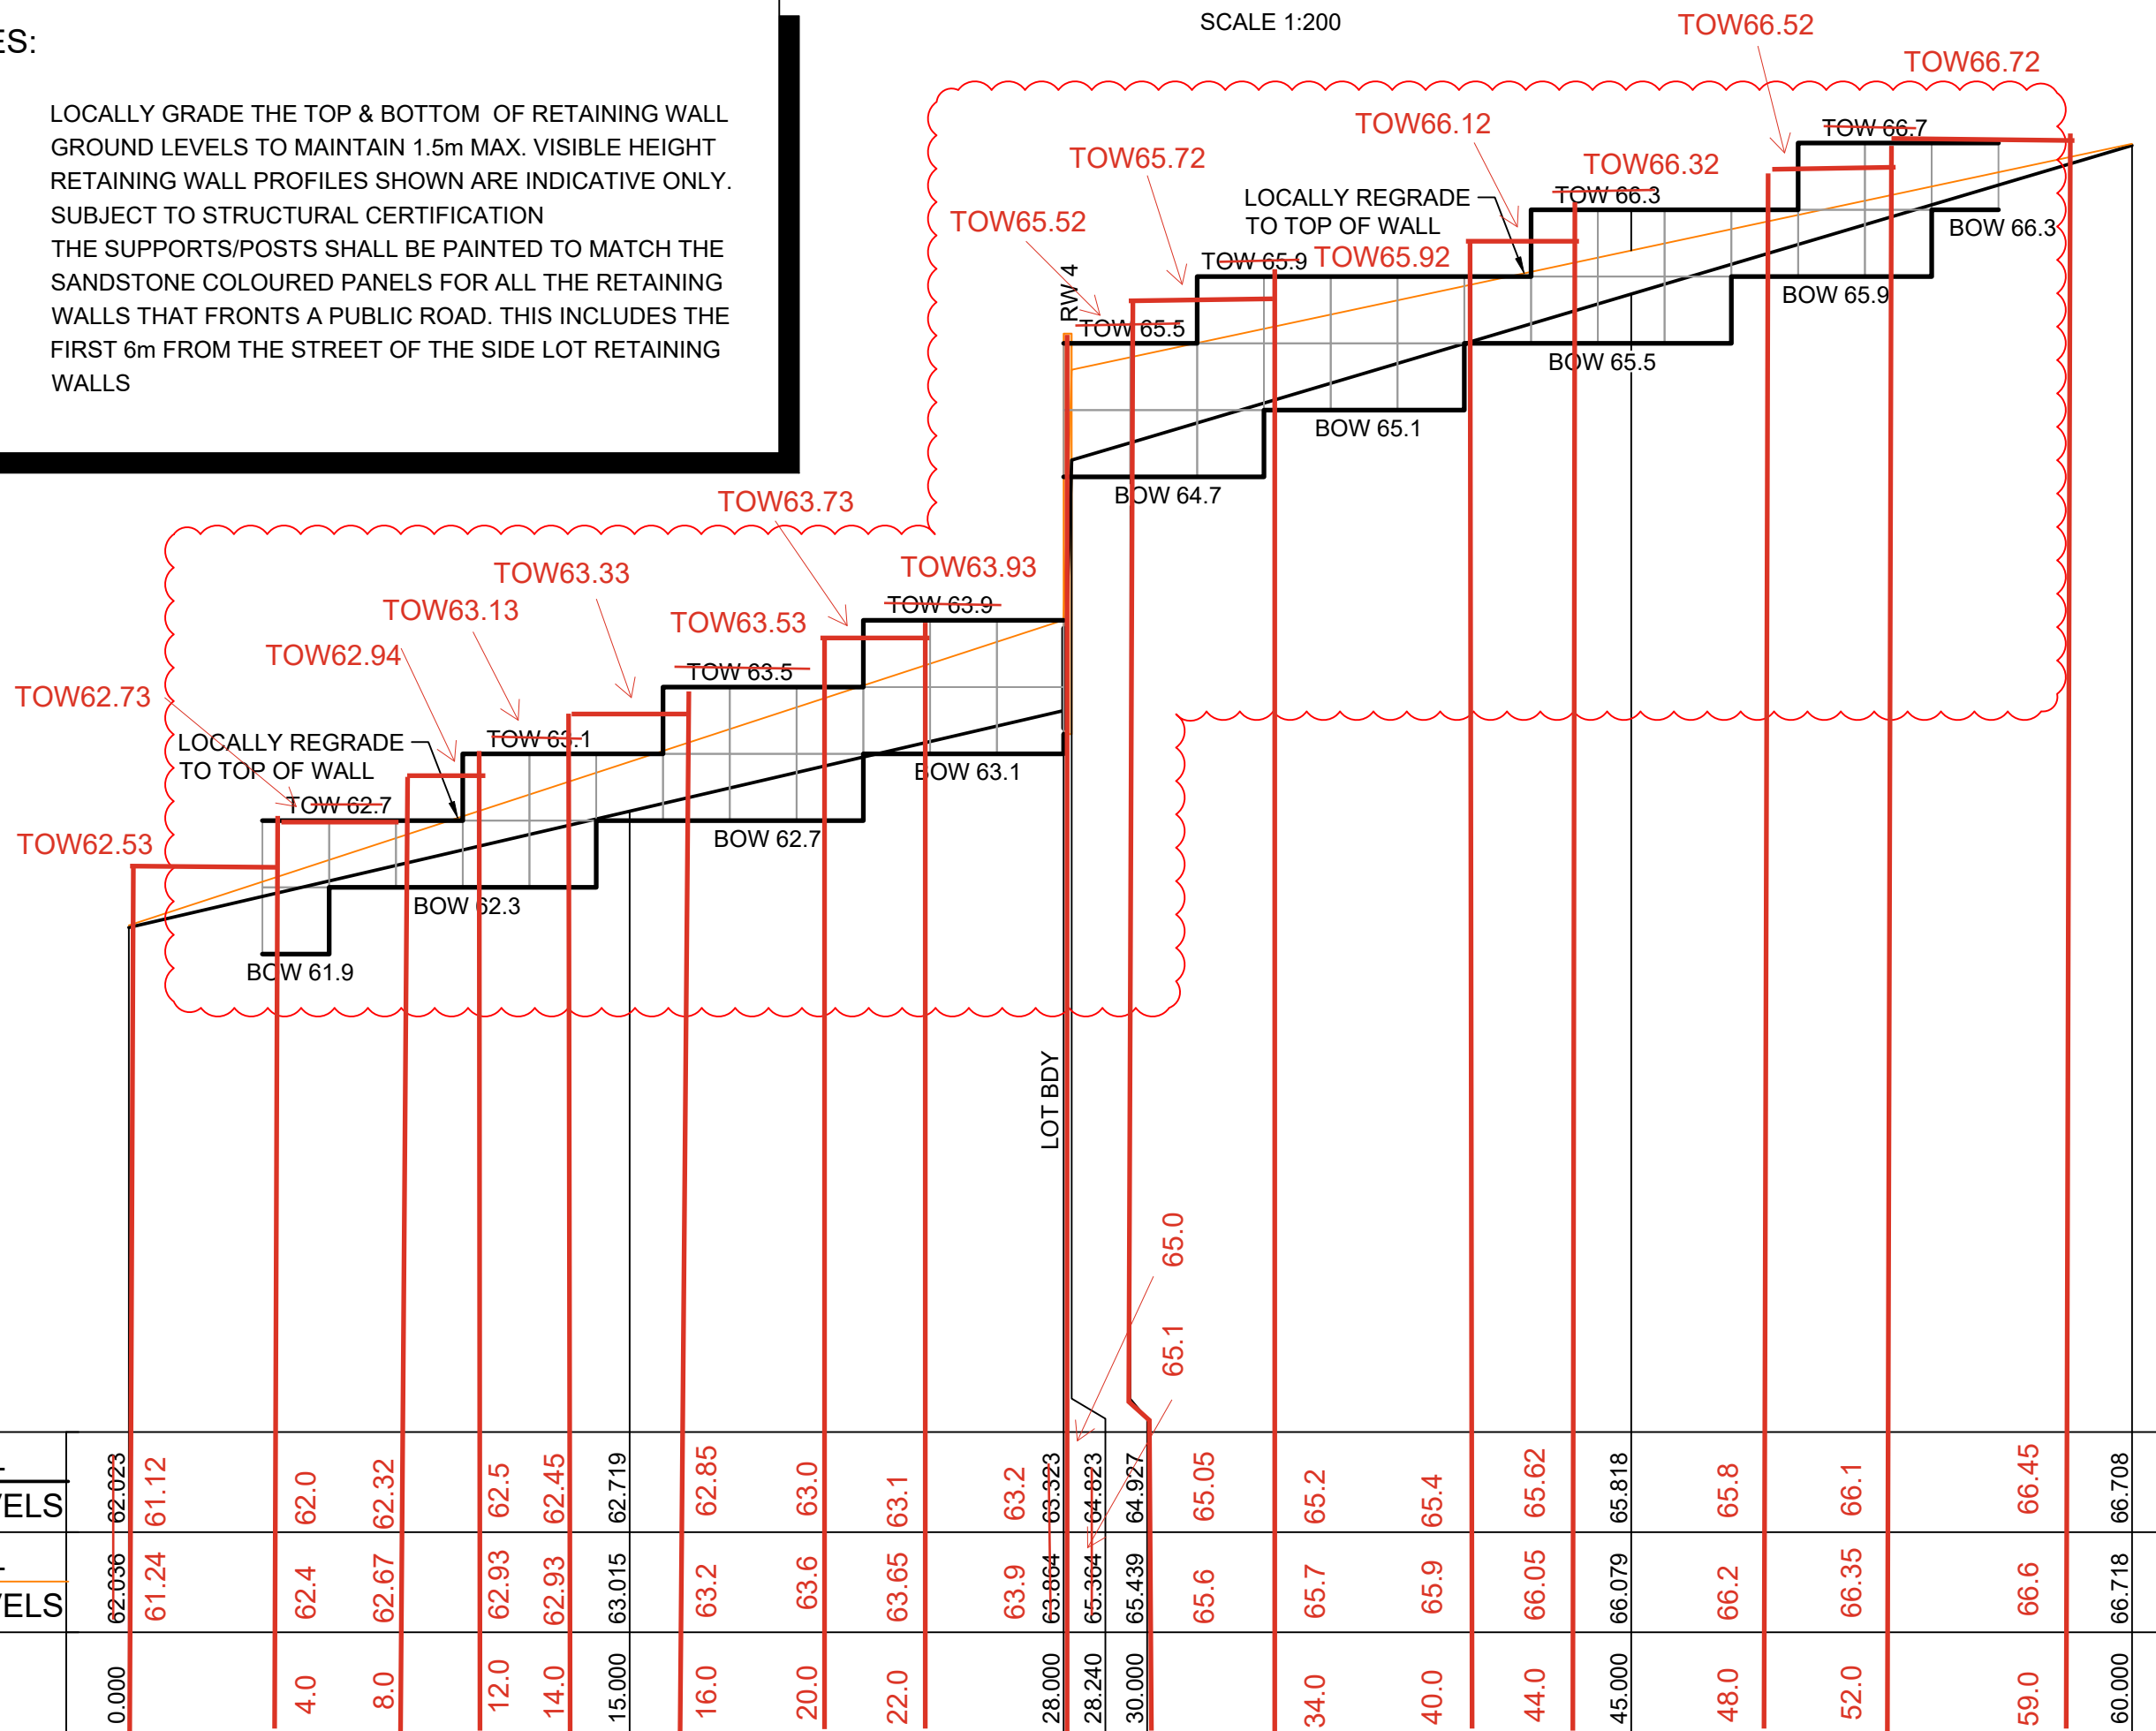


LONGITUDINAL SECTION RW 8
HORIZONTAL SCALE 1:200
VERTICAL SCALE 1:40

RW 8			
CHAINAGE	EASTING	NORTHING	BEARING
0	289726.13	6260312.35	279°49'01.32"
15	289711.35	6260314.9	279°49'01.32"
30	289696.57	6260317.46	279°49'01.32"
45	289681.79	6260320.02	279°49'01.32"
60	289667.01	6260322.58	279°49'01.32"

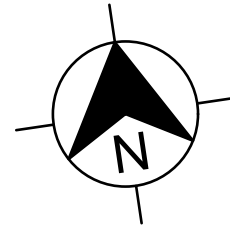

RHCO RICHARD HOGAN & CO.
SURVEYING & DEVELOPMENT CONSULTANTS


WORKS AS EXECUTED AS SHOWN IN RED
NAME: - CRAIG S LONARD
SIGNATURE: *[Signature]*
CAPACITY: - REGISTERED SURVEYOR #8800
DATE: 17.04.2025
CONTACT: ADMIN@HOGANCO.COM.AU

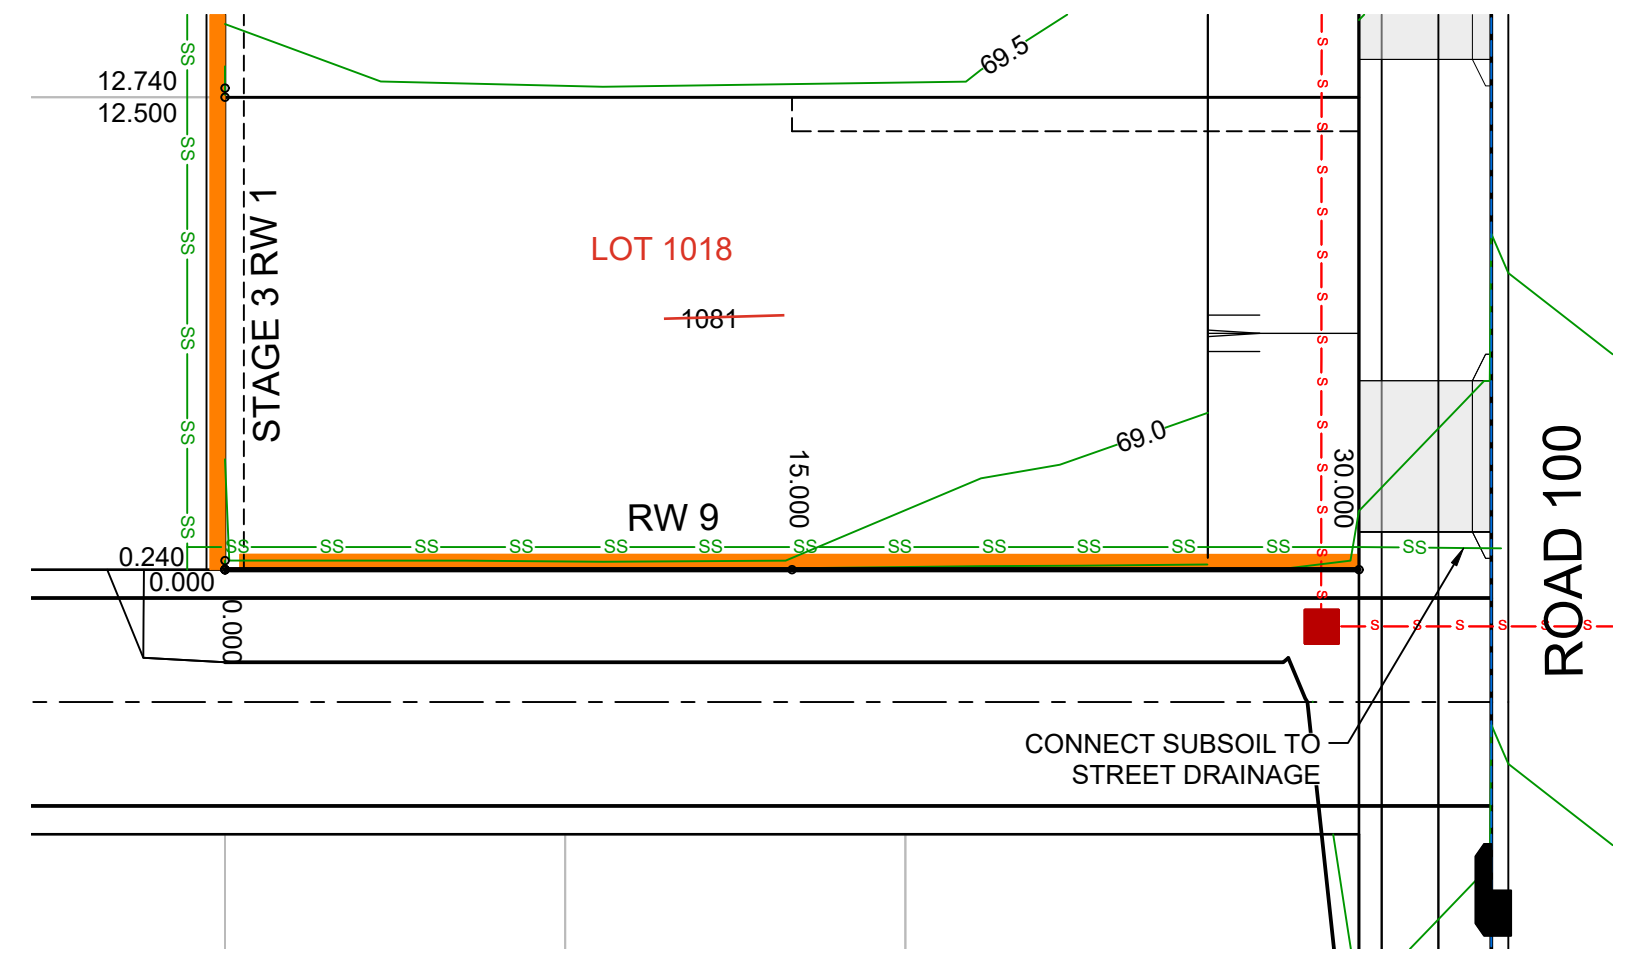

PLAN RW 9
SCALE 1:200

LEGEND


- RETAINING WALL (SLEEPER WALL)
- INTERALLOTMENT DRAINAGE LINE & PIT
- DRAINAGE LINE & PIT
- SUBSOIL

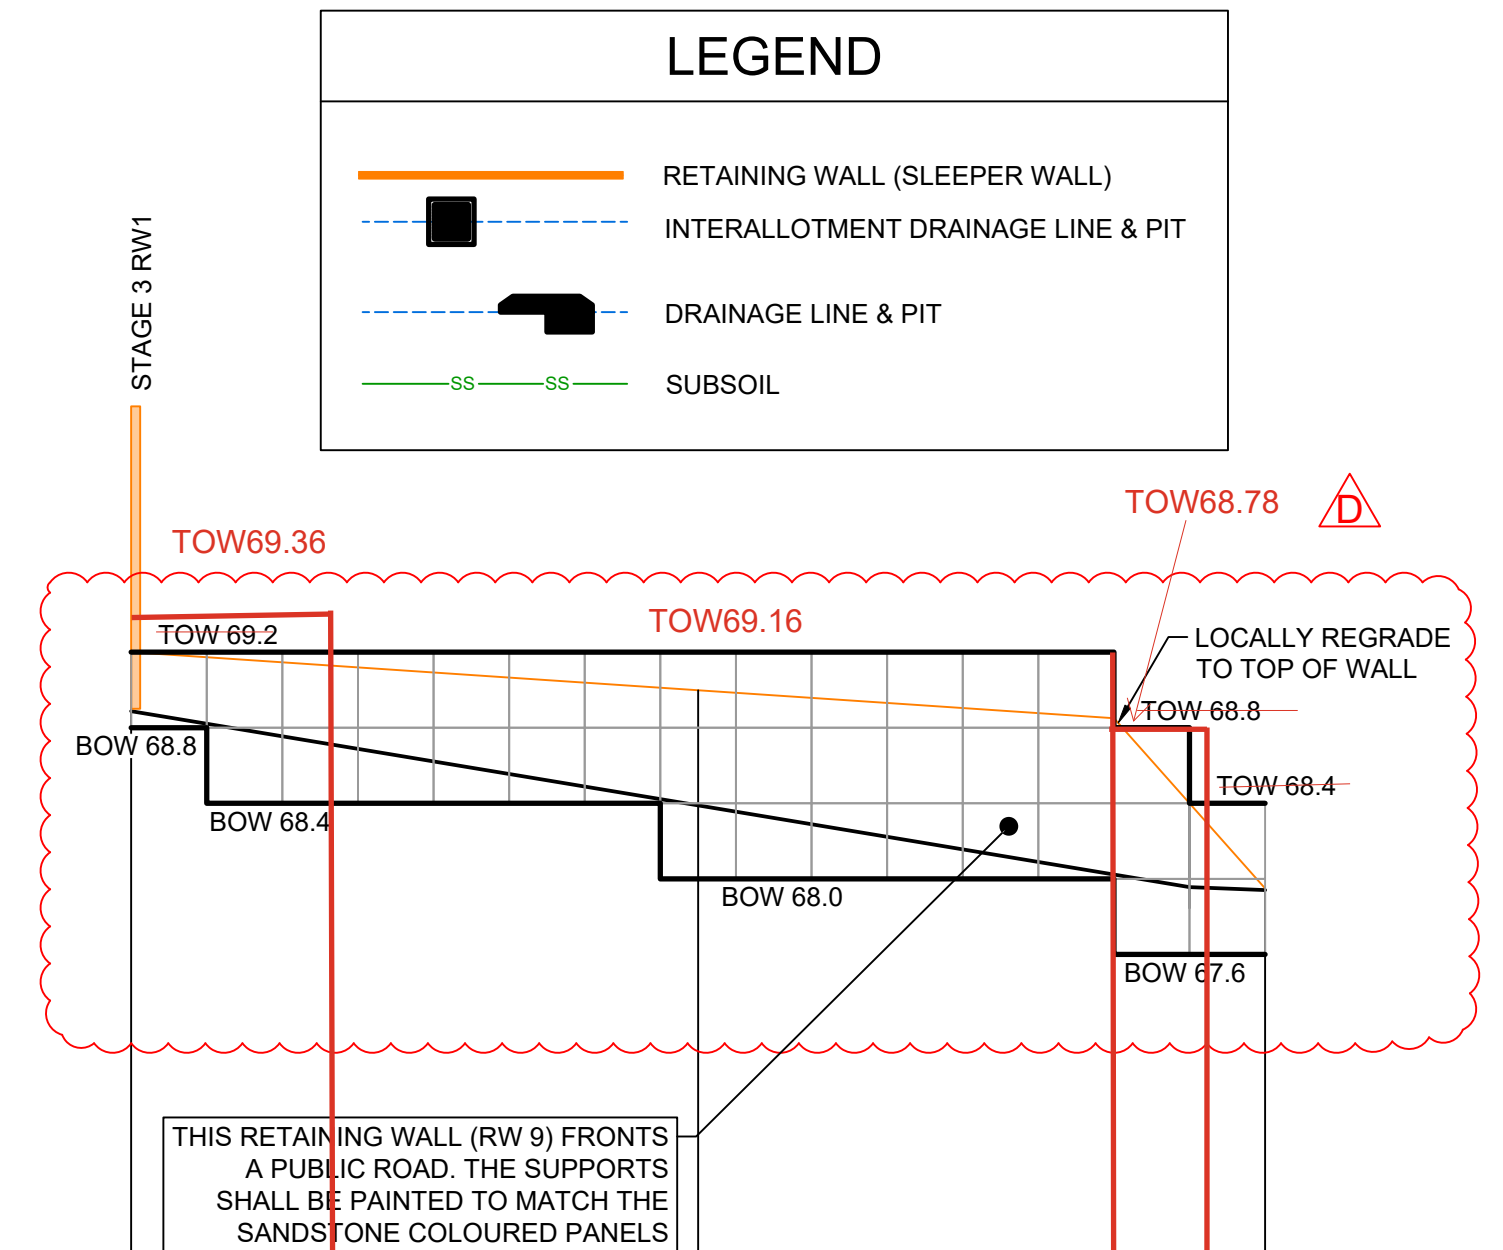

DATUM 65.0			
TOE OF WALL	GROUND LEVELS	TOP OF WALL	GROUND LEVELS
0.000	68.887	68.99	68.90
10.0	68.98	68.98	68.90
15.000	68.998	68.998	68.98
26.000	68.849	68.849	67.8
28.0	67.92	67.92	67.8
30.000	67.949	67.949	67.940

LONGITUDINAL SECTION RW 9
HORIZONTAL SCALE 1:200
VERTICAL SCALE 1:40

RW 9			
CHAINAGE	EASTING	NORTHING	BEARING
0	289613.14	6260189.13	58°15'22.39"
15	289625.89	6260197.02	58°15'22.39"
30	289638.65	6260204.91	58°15'22.39"

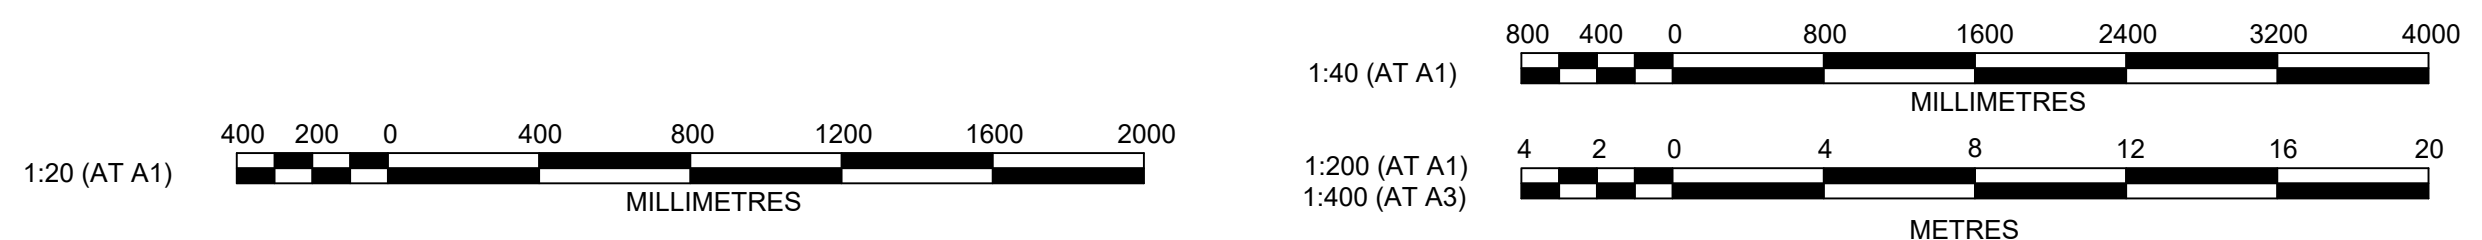

AMENDMENT	DES	DRN	CKD	APR	DATE
D	AMEND RETAINING WALL PROFILE TO SLEEPER WALL	MMC	EJ	MS	07/11/24
C	FOR CONSTRUCTION	MMC	GA	MS	27/09/24
B	LONG SECTIONS, SETOUT & TYPICAL ADDED	MMC	GA	DG	12/09/24
A	ISSUE FOR TENDER	MMC	GA	MS	10/04/24

J. WYNDHAM PRINCE
CONSULTING CIVIL INFRASTRUCTURE ENGINEERS & PROJECT MANAGERS

PO Box 4366 PENRITH WESTFIELD NSW 2750
P 02 4720 3300 W www.jwprince.com.au E jwp@jwprince.com.au

CLIENT:



STATUS:

ISSUE FOR CONSTRUCTION


THIS DRAWING MUST NOT BE USED FOR CONSTRUCTION UNLESS SIGNED AS PART OF AN APPROVED CONSTRUCTION CERTIFICATE.

ORCHARD HILLS NORTH
STAGE 1 CADDENS ROAD
RETAINING WALL PLAN & LONGITUDINAL SECTIONS
SHEET 6


PROJECT No:
110265-09
SHEET No:
DD1605

AZIMUTH: M.G.A. 2020 DATUM: A.H.D. ORIGIN: SSM 1112 PLAN No: 110265-09-DD1605

D

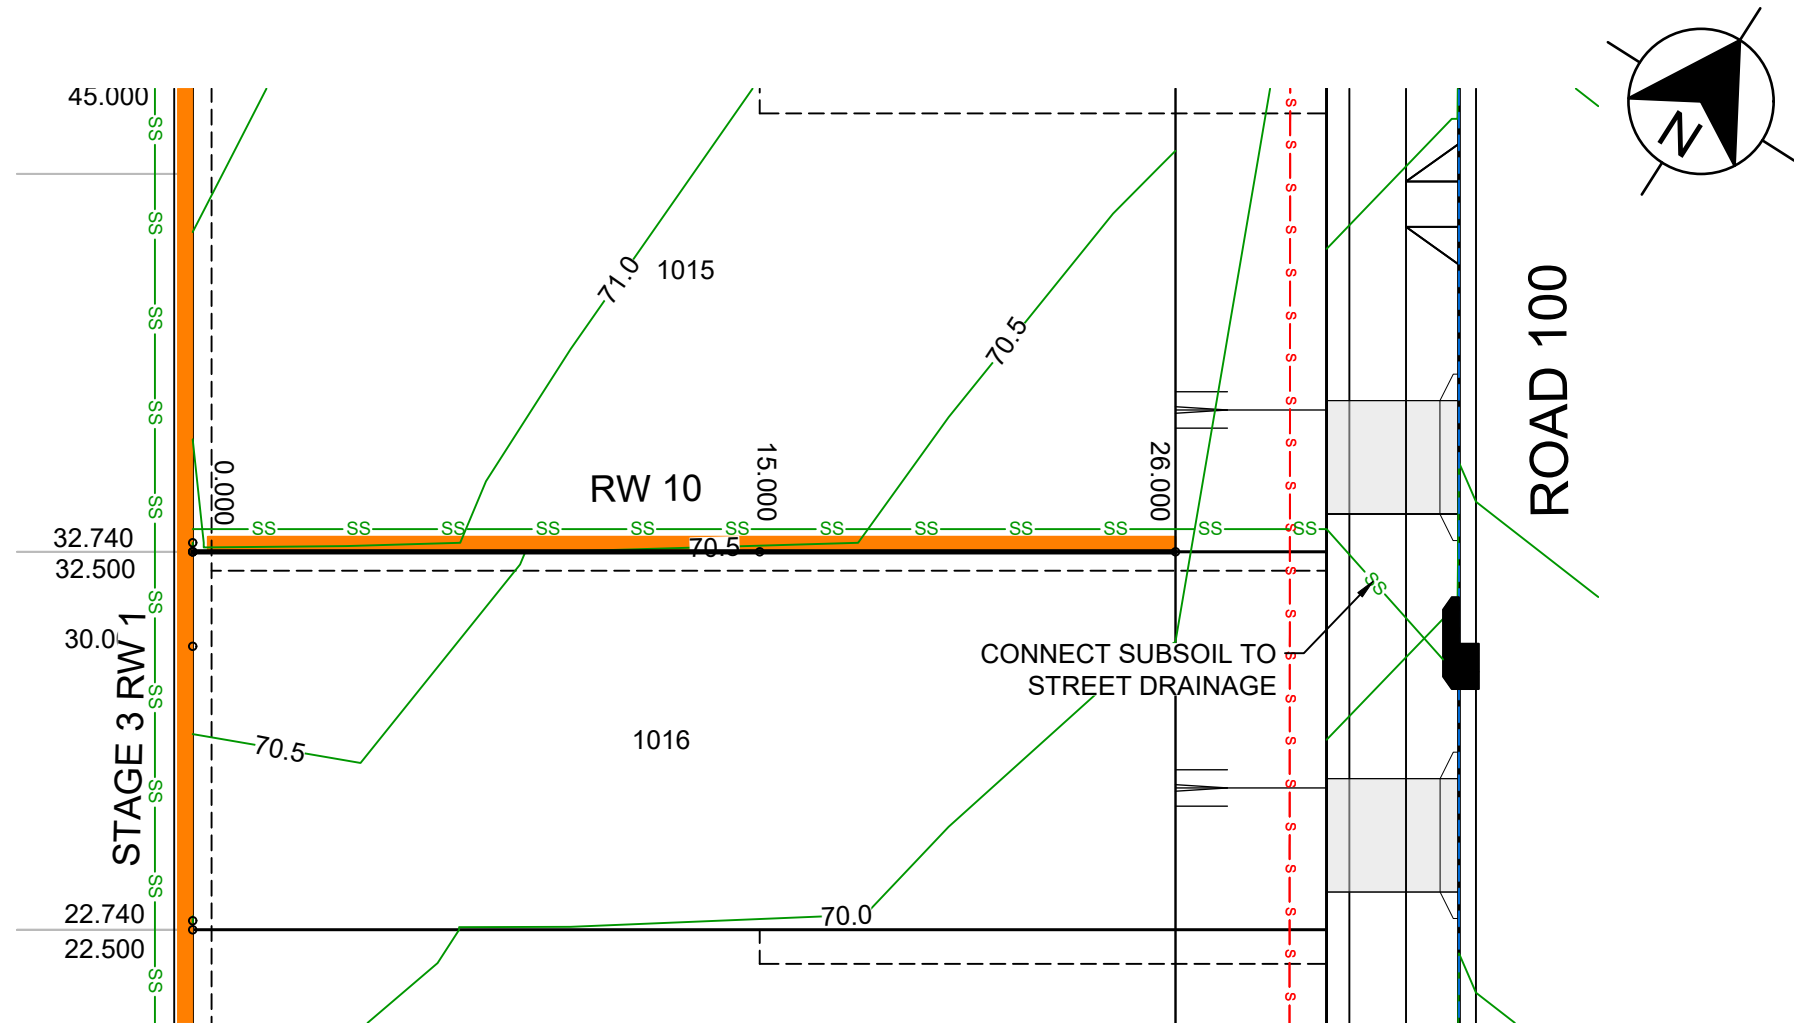

PLAN RW 10
SCALE 1:200

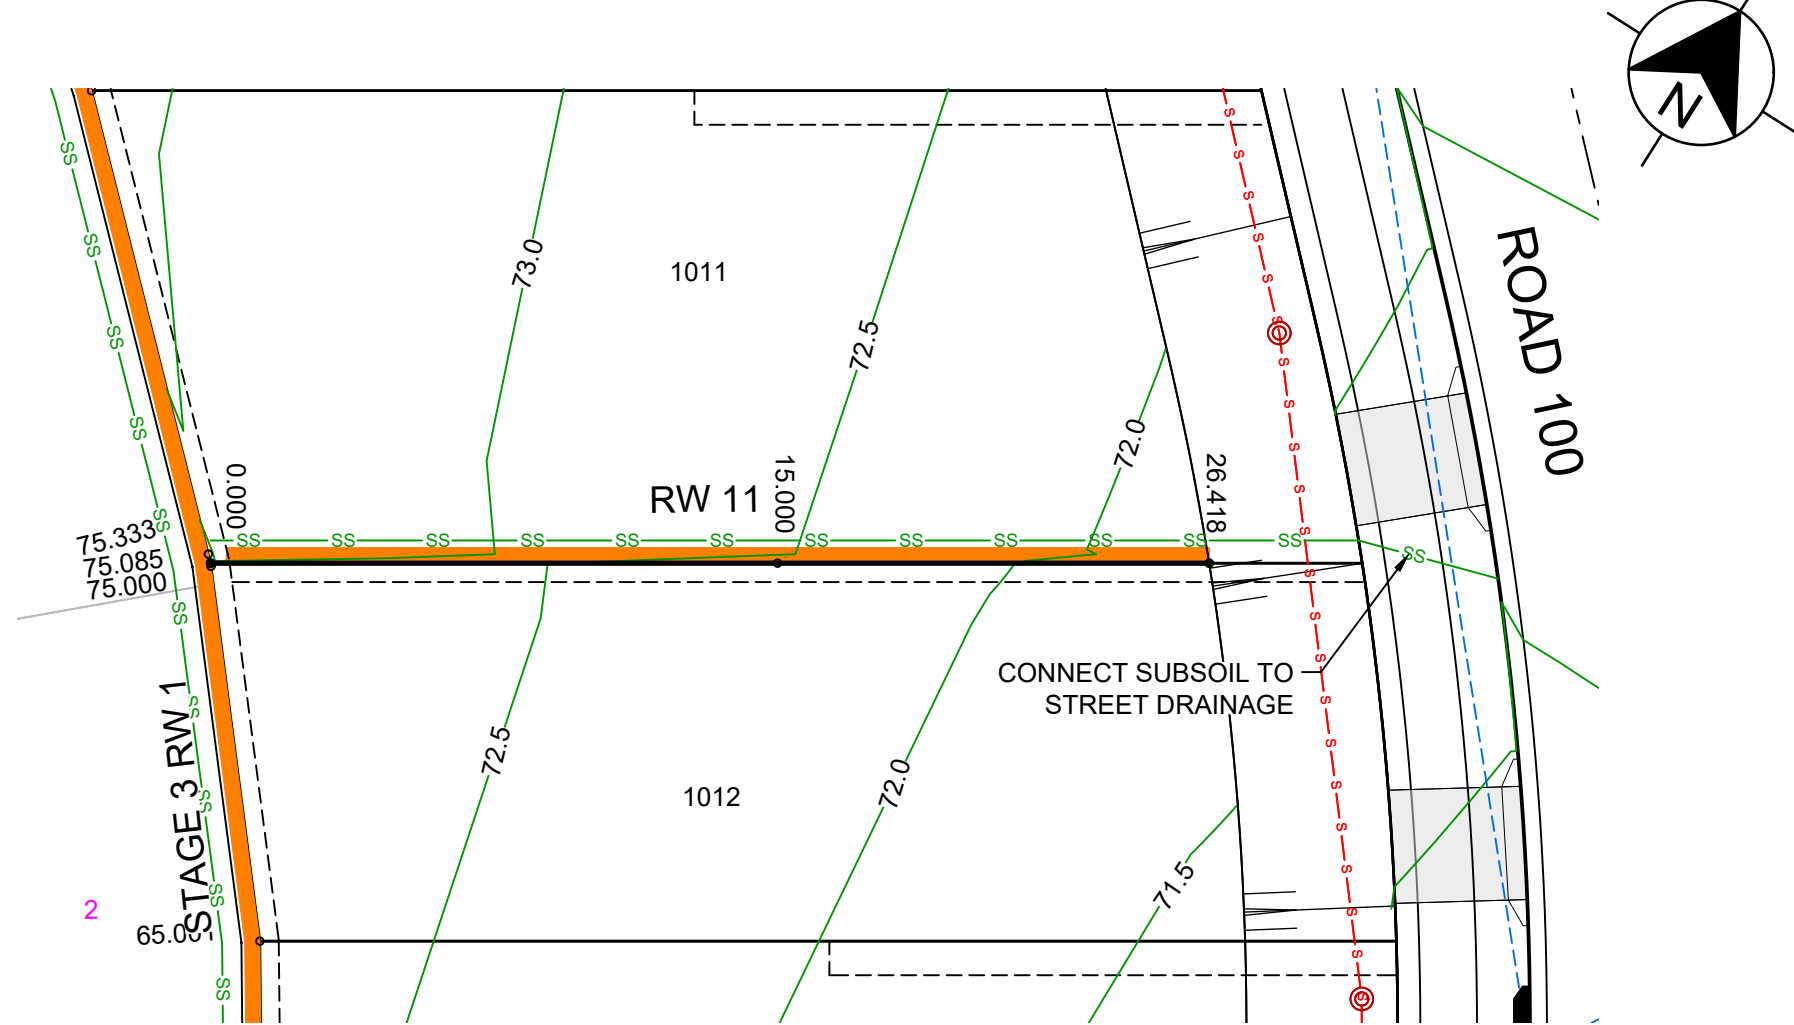


PLAN RW 11
SCALE 1:200

LEGEND

- RETAINING WALL (SLEEPER WALL)
- INTERALLOTMENT DRAINAGE LINE & PIT
- DRAINAGE LINE & PIT
- SUBSOIL


- NOTES:**
- LOCALLY GRADE THE TOP & BOTTOM OF RETAINING WALL GROUND LEVELS TO MAINTAIN 1.5m MAX. VISIBLE HEIGHT
 - RETAINING WALL PROFILES SHOWN ARE INDICATIVE ONLY.
 - SUBJECT TO STRUCTURAL CERTIFICATION
 - THE SUPPORTS/POSTS SHALL BE PAINTED TO MATCH THE SANDSTONE COLOURED PANELS FOR ALL THE RETAINING WALLS THAT FRONTS A PUBLIC ROAD. THIS INCLUDES THE FIRST 6m FROM THE STREET OF THE SIDE LOT RETAINING WALLS

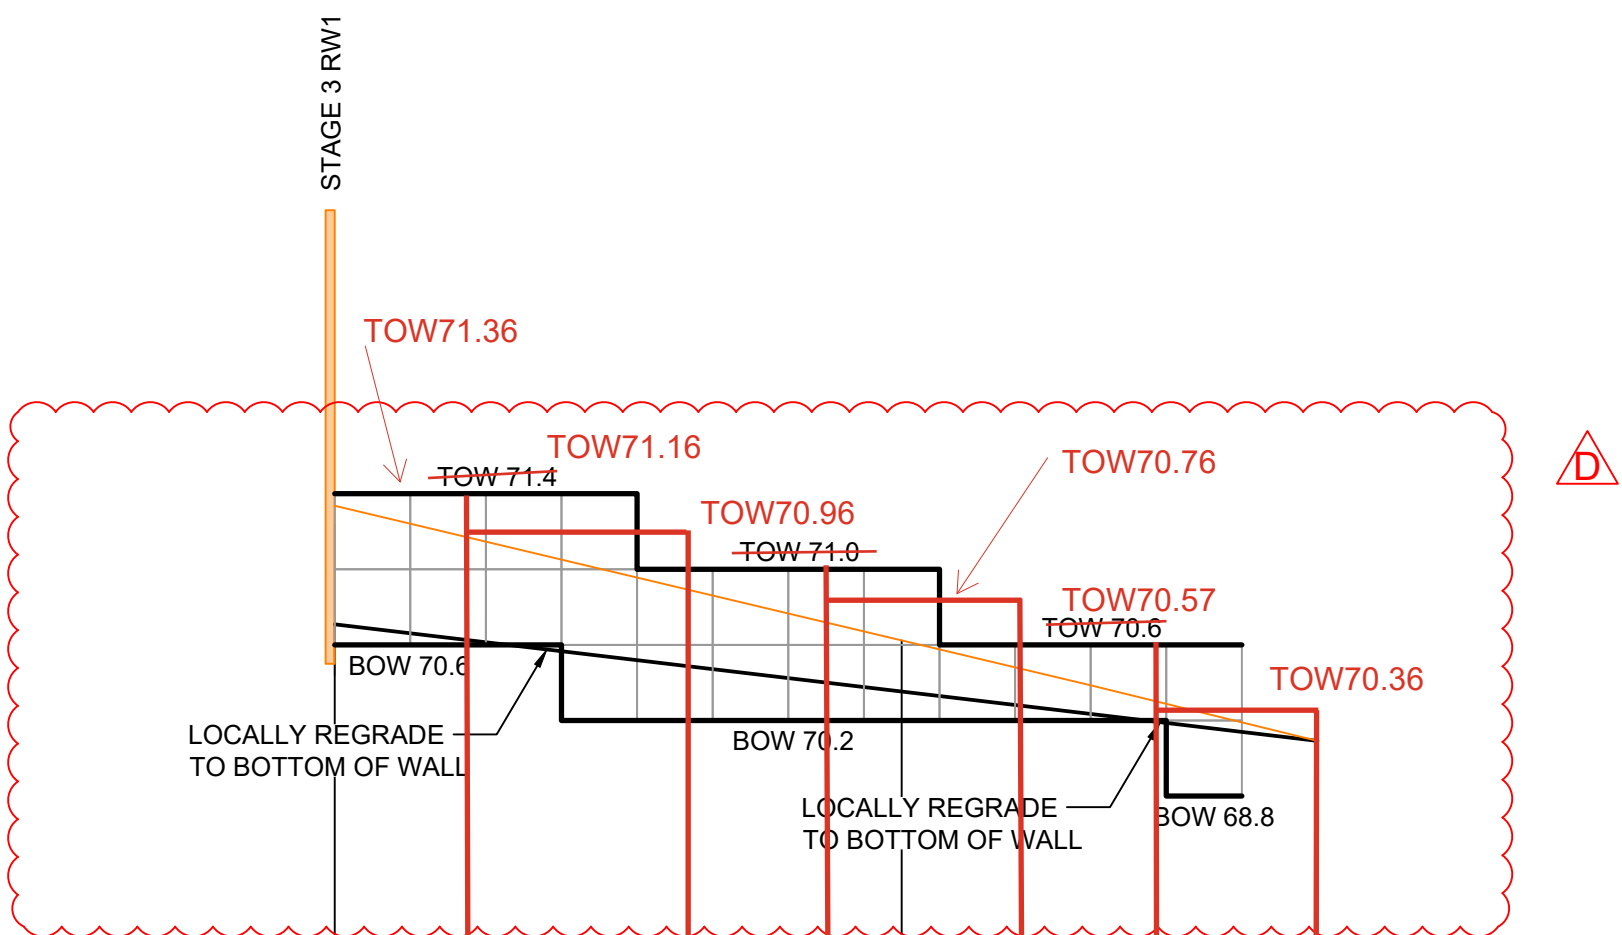

DATUM 67.0								
TOE OF WALL		70.709	70.53		70.38		70.29	70.353
GROUND LEVELS		71.336	70.12	71.03	70.83	70.63	70.43	70.10
TOP OF WALL		70.12	71.03		70.83	70.63	70.43	70.10
GROUND LEVELS		71.336	70.12	71.03	70.83	70.63	70.43	70.10
CHAINAGE		0.000	6.0		10.0	14.4	15.000	18.0
							22.0	25.000

LONGITUDINAL SECTION RW 10
HORIZONTAL SCALE 1:200
VERTICAL SCALE 1:40

RW 10			
CHAINAGE	EASTING	NORTHING	BEARING
0	289596.04	6260216.77	58°15'22.39"
15	289608.8	6260224.66	58°15'22.39"
26	289618.15	6260230.45	58°15'22.39"

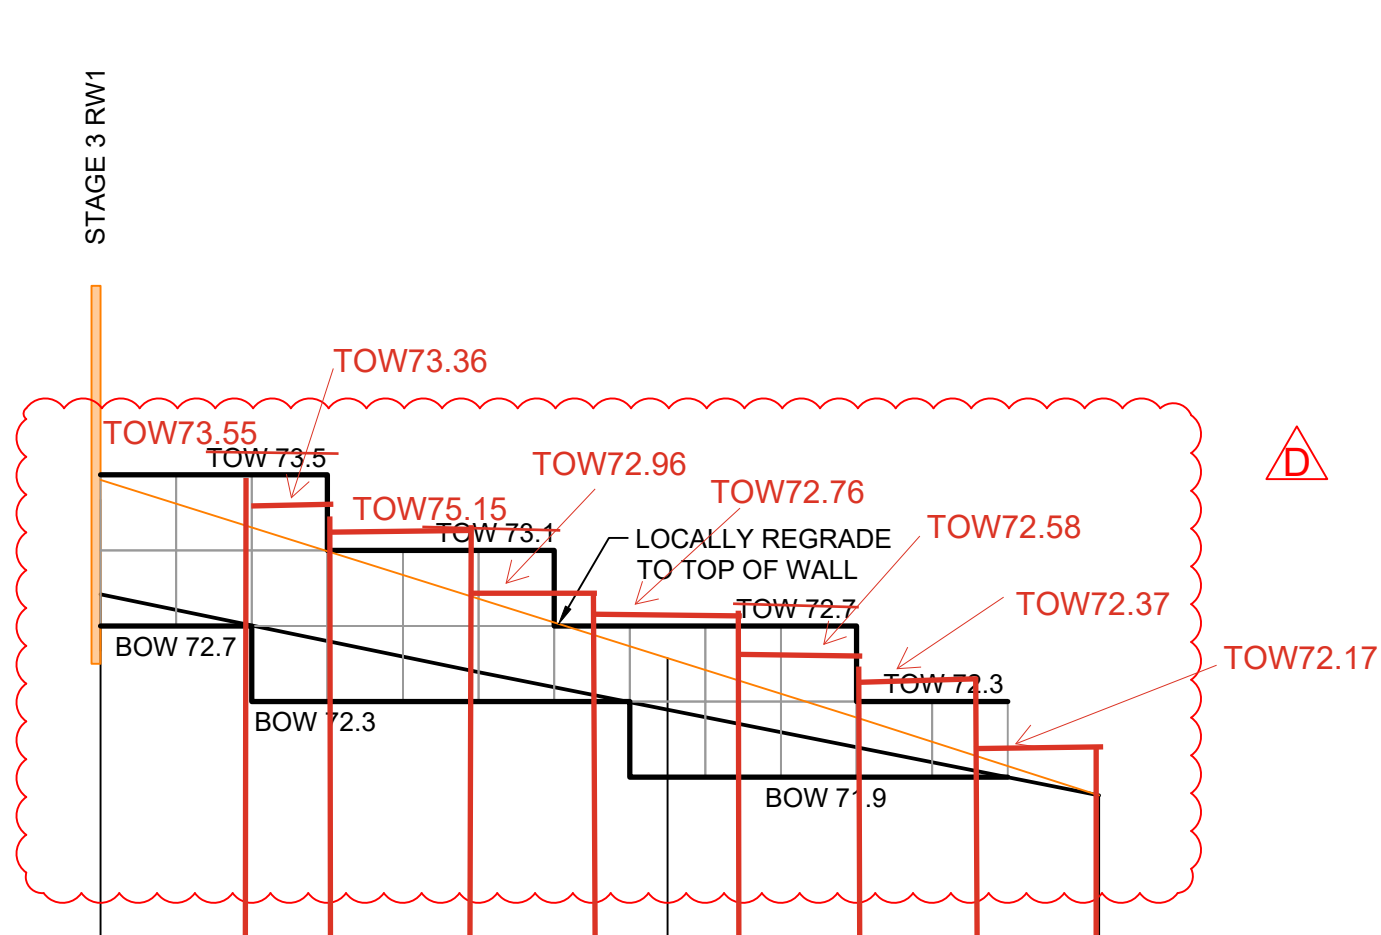

DATUM 69.0								
TOE OF WALL		72.853	72.64	72.64	72.58	72.31	72.25	72.257
GROUND LEVELS		73.473	73.31	73.03	72.85	72.68	72.50	72.530
TOP OF WALL		73.473	73.31	73.03	72.85	72.68	72.50	72.530
GROUND LEVELS		73.473	73.31	73.03	72.85	72.68	72.50	72.530
CHAINAGE		0.000	4.0	6.0	10.0	14.0	15.000	16.0
							20.0	22.0
							26.418	26.418


LONGITUDINAL SECTION RW 11
HORIZONTAL SCALE 1:200
VERTICAL SCALE 1:40

RW 11			
CHAINAGE	EASTING	NORTHING	BEARING
0	289572.48	6260252.17	58°15'22.39"
15	289585.24	6260260.06	58°15'22.39"
26.42	289594.95	6260266.07	58°15'22.39"

WORKS AS EXECUTED AS SHOWN IN RED
NAME: - CRAIG S LONARD
SIGNATURE: *Craig S Lonard*
CAPACITY: - REGISTERED SURVEYOR #8800
DATE: 17.04.2025
CONTACT: ADMIN@HOGANCO.COM.AU

RHCO RICHARD HOGAN & CO.
SURVEYING & DEVELOPMENT CONSULTANTS

PENRITH CITY COUNCIL
This plan / document relates to:
Development Consent: DA23/0969
Subdivision Works Certificate: EA24/0036.01
Subject to the conditions outlined in the consent

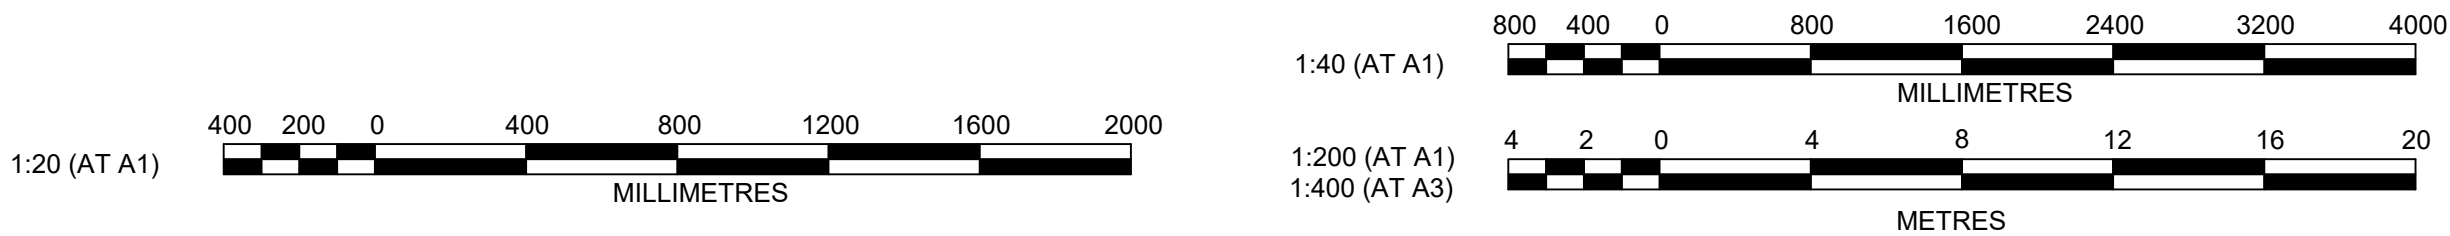

D	AMEND RETAINING WALL PROFILE TO SLEEPER WALL	MMC	EJ	MS	MS	07/11/24
C	FOR CONSTRUCTION	MMC	GA	MS	MS	27/09/24
B	LONG SECTIONS, SETOUT & TYPICAL ADDED	MMC	GA	DG	CR	12/09/24
A	ISSUE FOR TENDER	MMC	GA	MS		10/04/24
	AMENDMENT	DES	DRN	CKD	APR	DATE

J. WYNDHAM PRINCE
CONSULTING CIVIL INFRASTRUCTURE ENGINEERS & PROJECT MANAGERS

PO Box 4366 PENRITH WESTFIELD NSW 2750
P 02 4720 3300 W www.jwprince.com.au E jwp@jwprince.com.au

CLIENT:
LEGACYPROPERTY

STATUS:
ISSUE FOR CONSTRUCTION
THIS DRAWING MUST NOT BE USED FOR CONSTRUCTION UNLESS SIGNED AS PART OF AN APPROVED CONSTRUCTION CERTIFICATE.


ORCHARD HILLS NORTH
STAGE 1 CADDENS ROAD
RETAINING WALL PLAN & LONGITUDINAL SECTIONS
SHEET 7

AZIMUTH: M.G.A. 2020
DATUM: A.H.D.
ORIGIN: SSM 1112
PLAN No: 110265-09-DD1606
D

PROJECT No:
110265-09
SHEET No:
DD1606


LEGEND	
	RETAINING WALL (SLEEPER WALL)
	INTERALLOTMENT DRAINAGE LINE & PIT
	DRAINAGE LINE & PIT
	SUBSOIL

- NOTES:
- LOCALLY GRADE THE TOP & BOTTOM OF RETAINING WALL GROUND LEVELS TO MAINTAIN 1.5m MAX. VISIBLE HEIGHT
 - RETAINING WALL PROFILES SHOWN ARE INDICATIVE ONLY. SUBJECT TO STRUCTURAL CERTIFICATION
 - THE SUPPORTS/POSTS SHALL BE PAINTED TO MATCH THE SANDSTONE COLOURED PANELS FOR ALL THE RETAINING WALLS THAT FRONTS A PUBLIC ROAD. THIS INCLUDES THE FIRST 6m FROM THE STREET OF THE SIDE LOT RETAINING WALLS

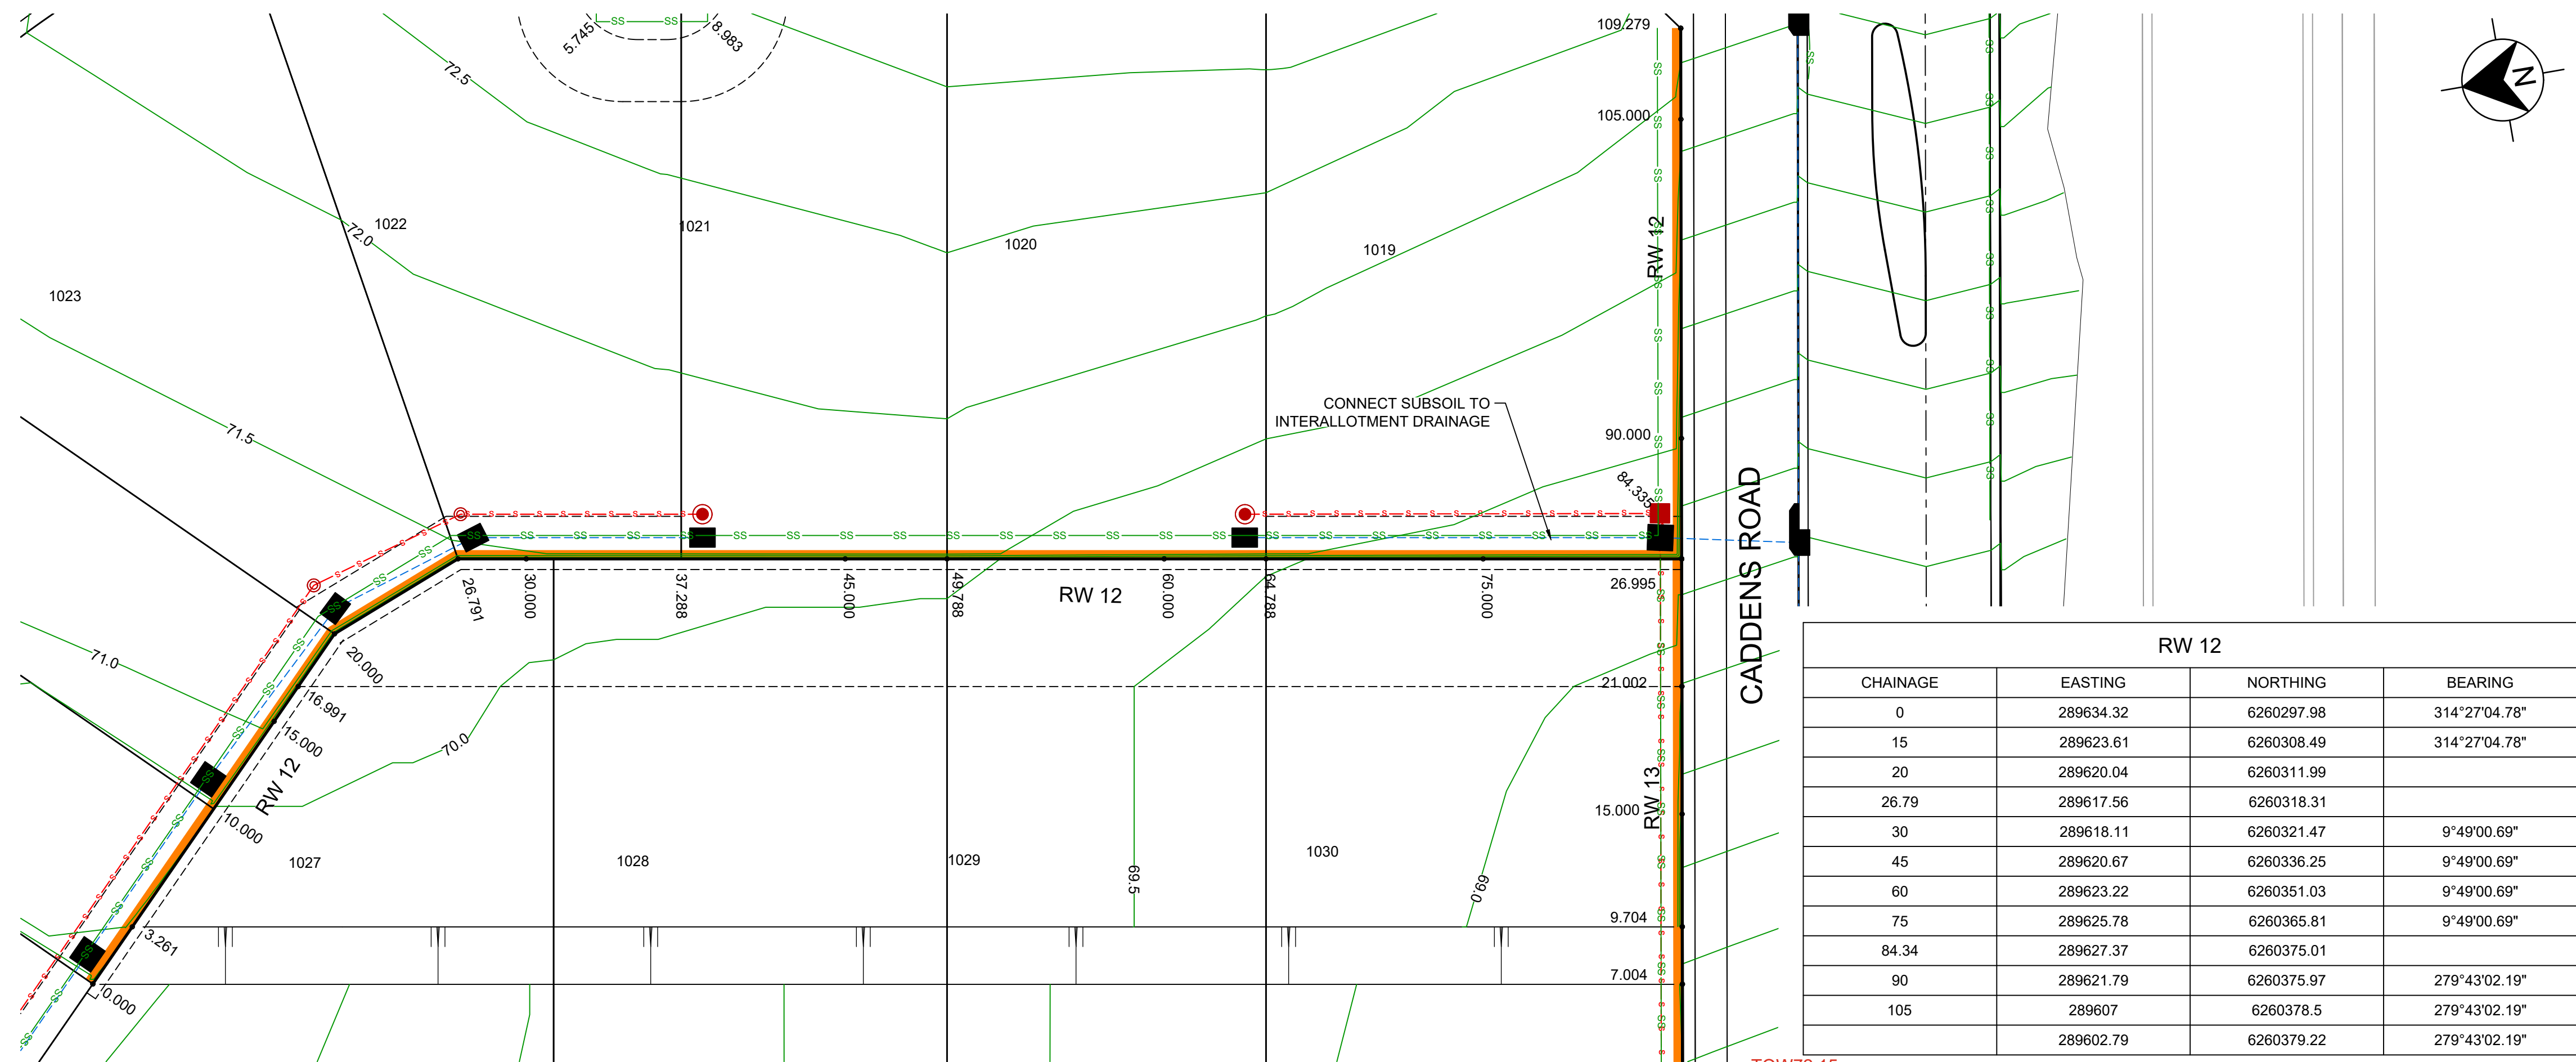

RW 12			
CHAINAGE	EASTING	NORTHING	BEARING
0	289634.32	6260297.98	314°27'04.78"
15	289623.61	6260308.49	314°27'04.78"
20	289620.04	6260311.99	
26.79	289617.56	6260318.31	
30	289618.11	6260321.47	9°49'00.69"
45	289620.67	6260336.25	9°49'00.69"
60	289623.22	6260351.03	9°49'00.69"
75	289625.78	6260365.81	9°49'00.69"
84.34	289627.37	6260375.01	
90	289621.79	6260375.97	279°43'02.19"
105	289607	6260378.5	279°43'02.19"
	289602.79	6260379.22	279°43'02.19"

PLAN RW 12
SCALE 1:200

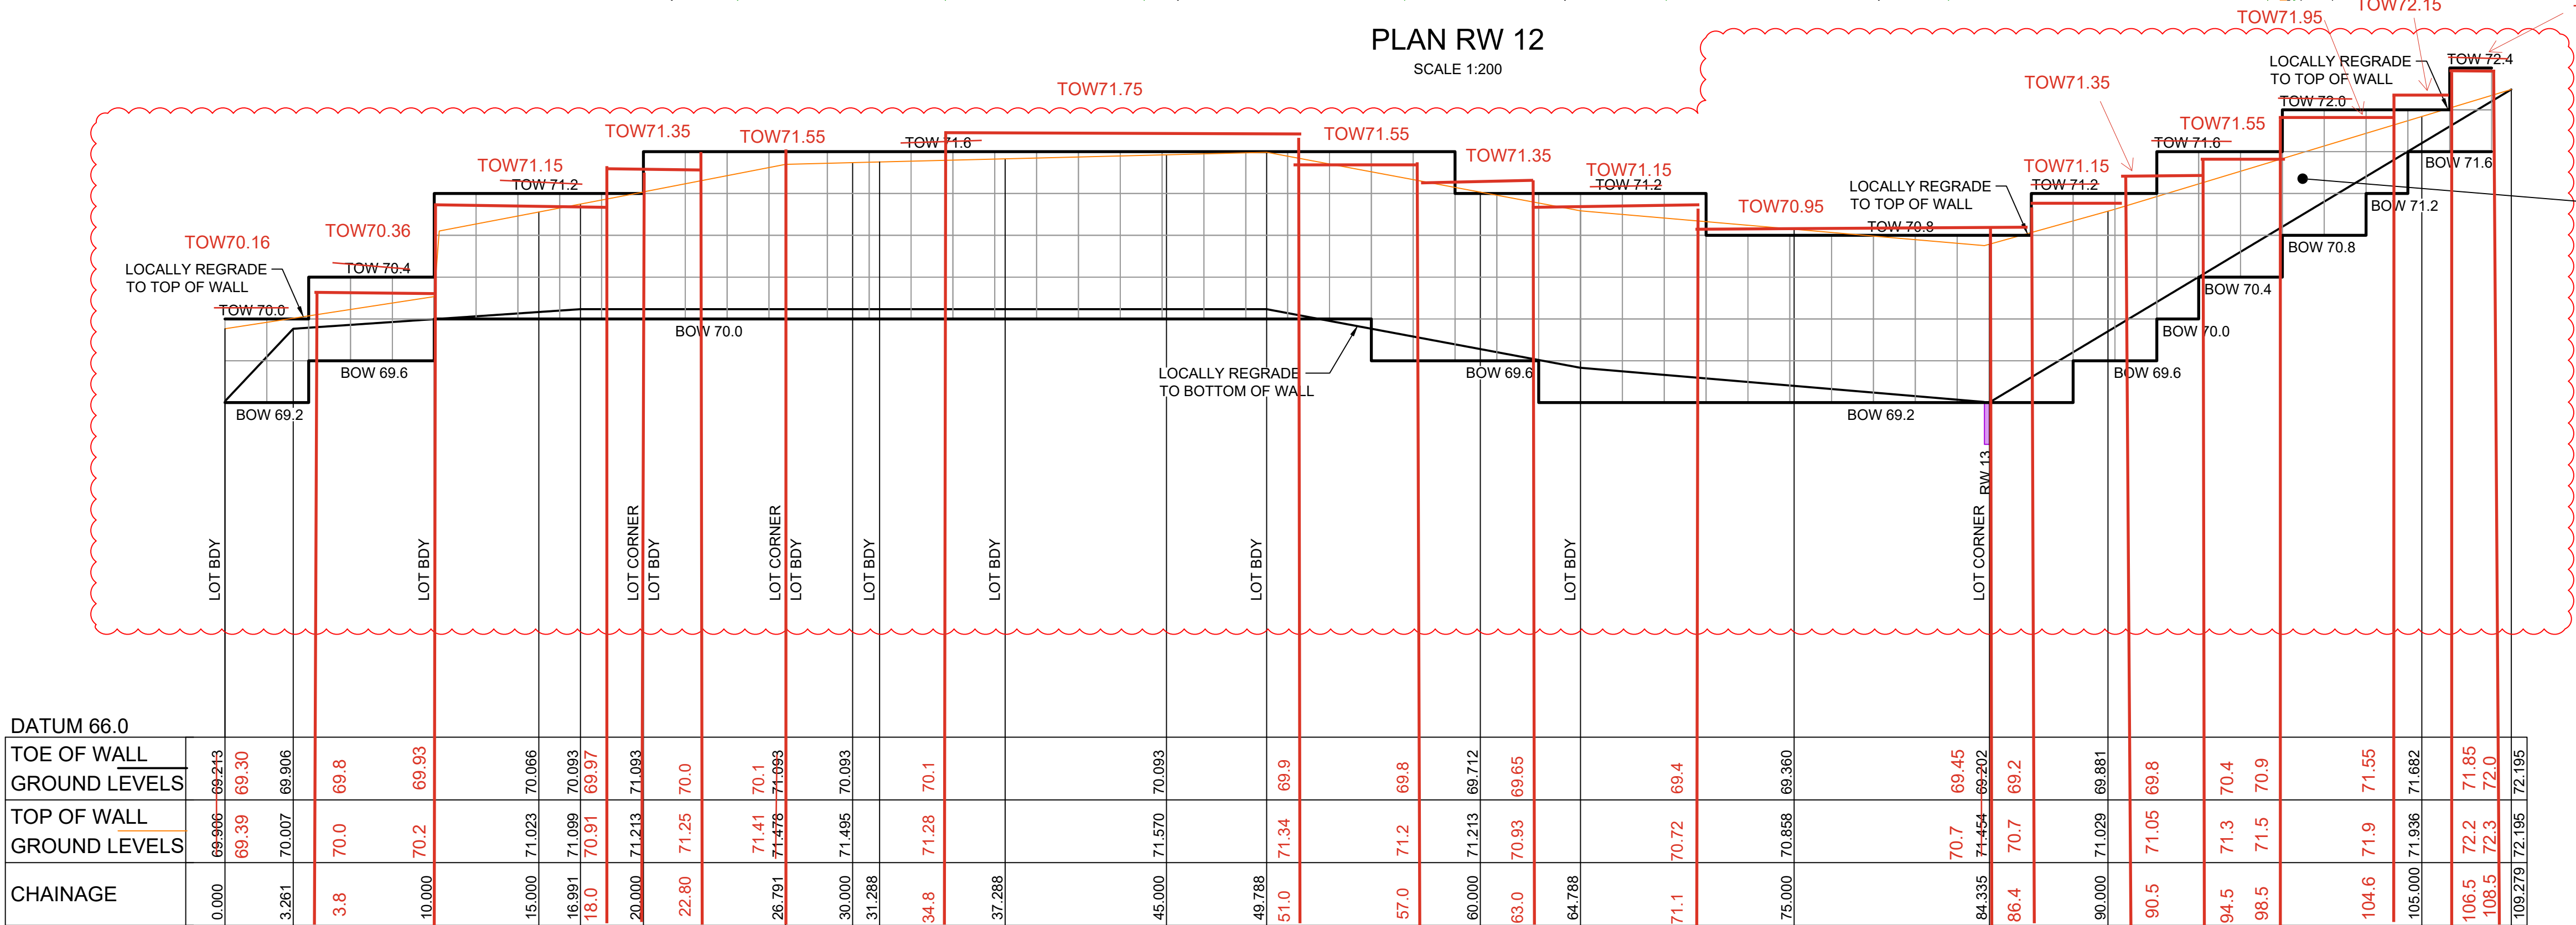


PART OF THIS RETAINING WALL (RW 12) FRONTS A PUBLIC ROAD. THE SUPPORTS SHALL BE PAINTED TO MATCH THE SANDSTONE COLOURED PANELS

WORKS AS EXECUTED AS SHOWN IN RED
NAME: - CRAIG S LONARD
SIGNATURE:
CAPACITY: - REGISTERED SURVEYOR #8800
DATE: 17.04.2025
CONTACT: ADMIN@HOGANCO.COM.AU

RHCO RICHARD HOGAN & CO.
SURVEYING & DEVELOPMENT CONSULTANTS

PENRITH CITY COUNCIL
This plan / document relates to
Development Consent: DA23/0969
Subdivision Works Certificate: EA24/0036.01
Subject to the conditions outlined in the consent

LONGITUDINAL SECTION RW 12
HORIZONTAL SCALE 1:200
VERTICAL SCALE 1:40

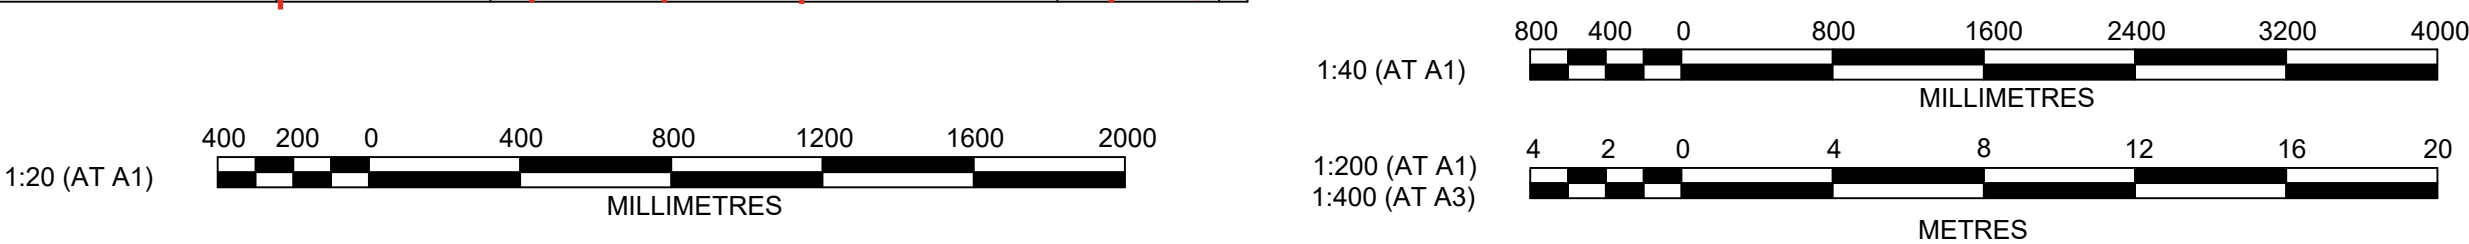

D	AMEND RETAINING WALL PROFILE TO SLEEPER WALL	MMC	EJ	MS	MS	07/11/24
C	FOR CONSTRUCTION	MMC	GA	MS	MS	27/09/24
B	LONG SECTIONS, SETOUT & TYPICAL ADDED	MMC	GA	DG	CR	12/09/24
A	ISSUE FOR TENDER	MMC	GA	MS	CR	10/04/24
	AMENDMENT	DES	DRN	CKD	APR	DATE

J. WYNDHAM PRINCE
CONSULTING CIVIL INFRASTRUCTURE ENGINEERS & PROJECT MANAGERS

PO Box 4366 PENRITH WESTFIELD NSW 2750
P 02 4720 3300 W www.jwprince.com.au E jwp@jwprince.com.au

CLIENT:


LEGACYPROPERTY

STATUS:
ISSUE FOR CONSTRUCTION
THIS DRAWING MUST NOT BE USED FOR CONSTRUCTION UNLESS SIGNED AS PART OF AN APPROVED CONSTRUCTION CERTIFICATE.

**ORCHARD HILLS NORTH
STAGE 1 CADDENS ROAD**
RETAINING WALL PLAN & LONGITUDINAL SECTIONS
SHEET 8


AZIMUTH: M.G.A. 2020
DATUM: A.H.D.
ORIGIN: SSM 1112
PLAN No: 110265-09-DD1607
D

PROJECT No:
110265-09
SHEET No:
DD1607

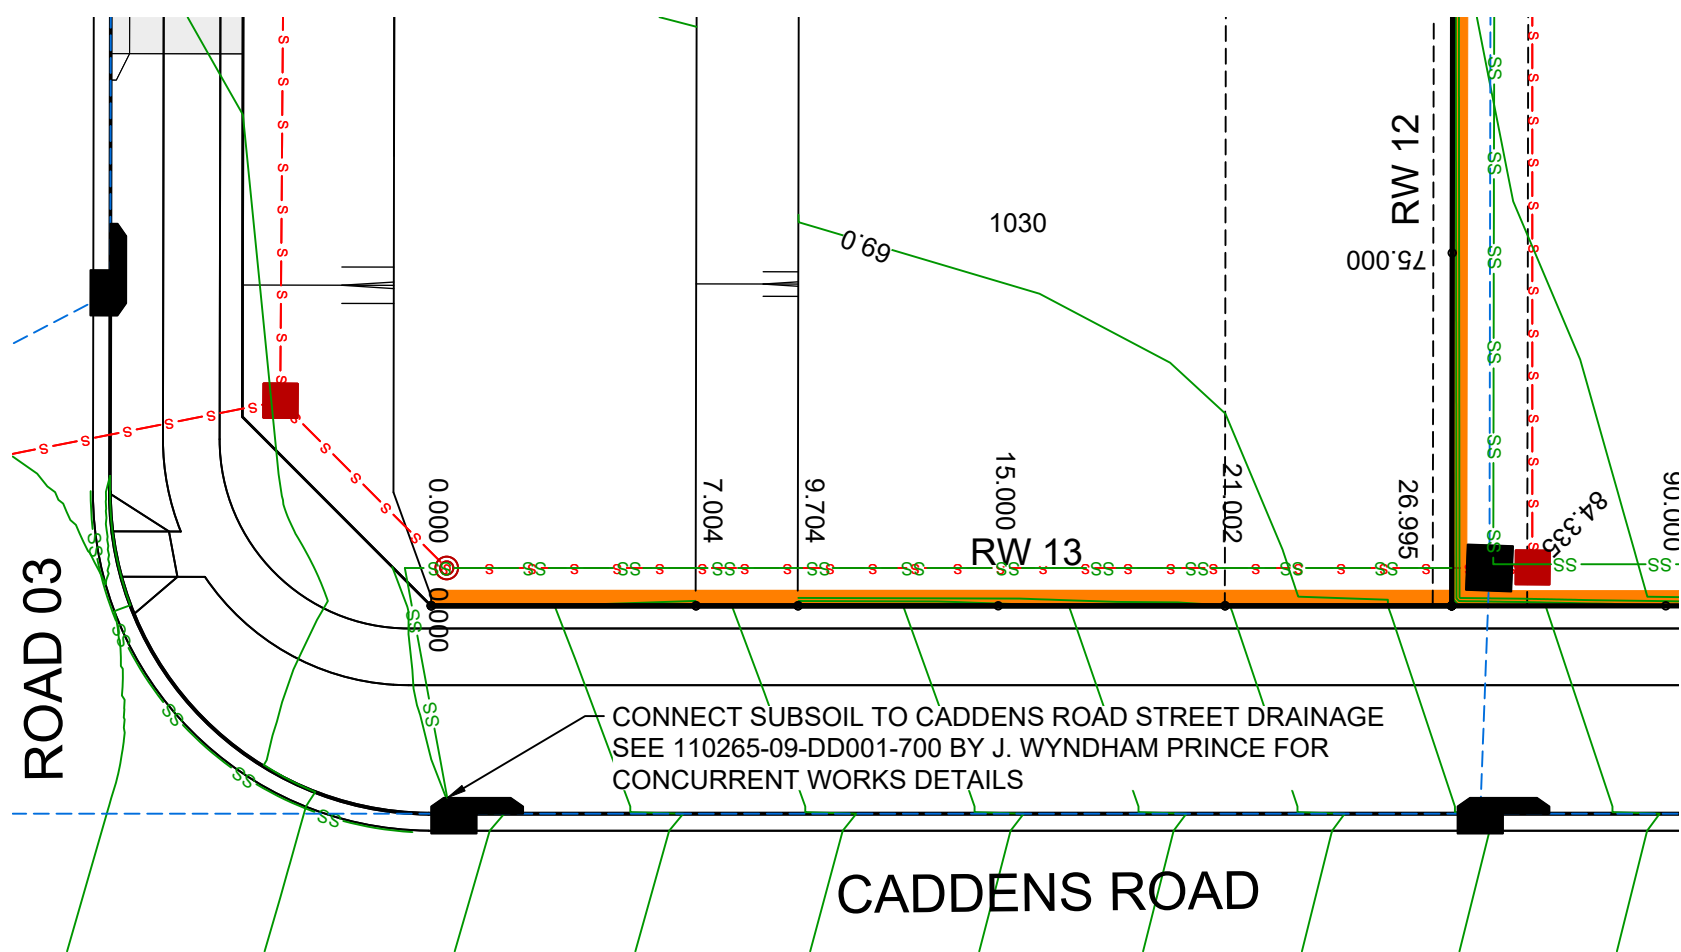


PLAN RW 13
SCALE 1:200

RW 13			
CHAINAGE	EASTING	NORTHING	BEARING
0	289653.98	6260370.46	279°43'01.89"
15	289639.2	6260372.99	279°43'01.89"
26.99	289627.37	6260375.01	279°43'01.89"

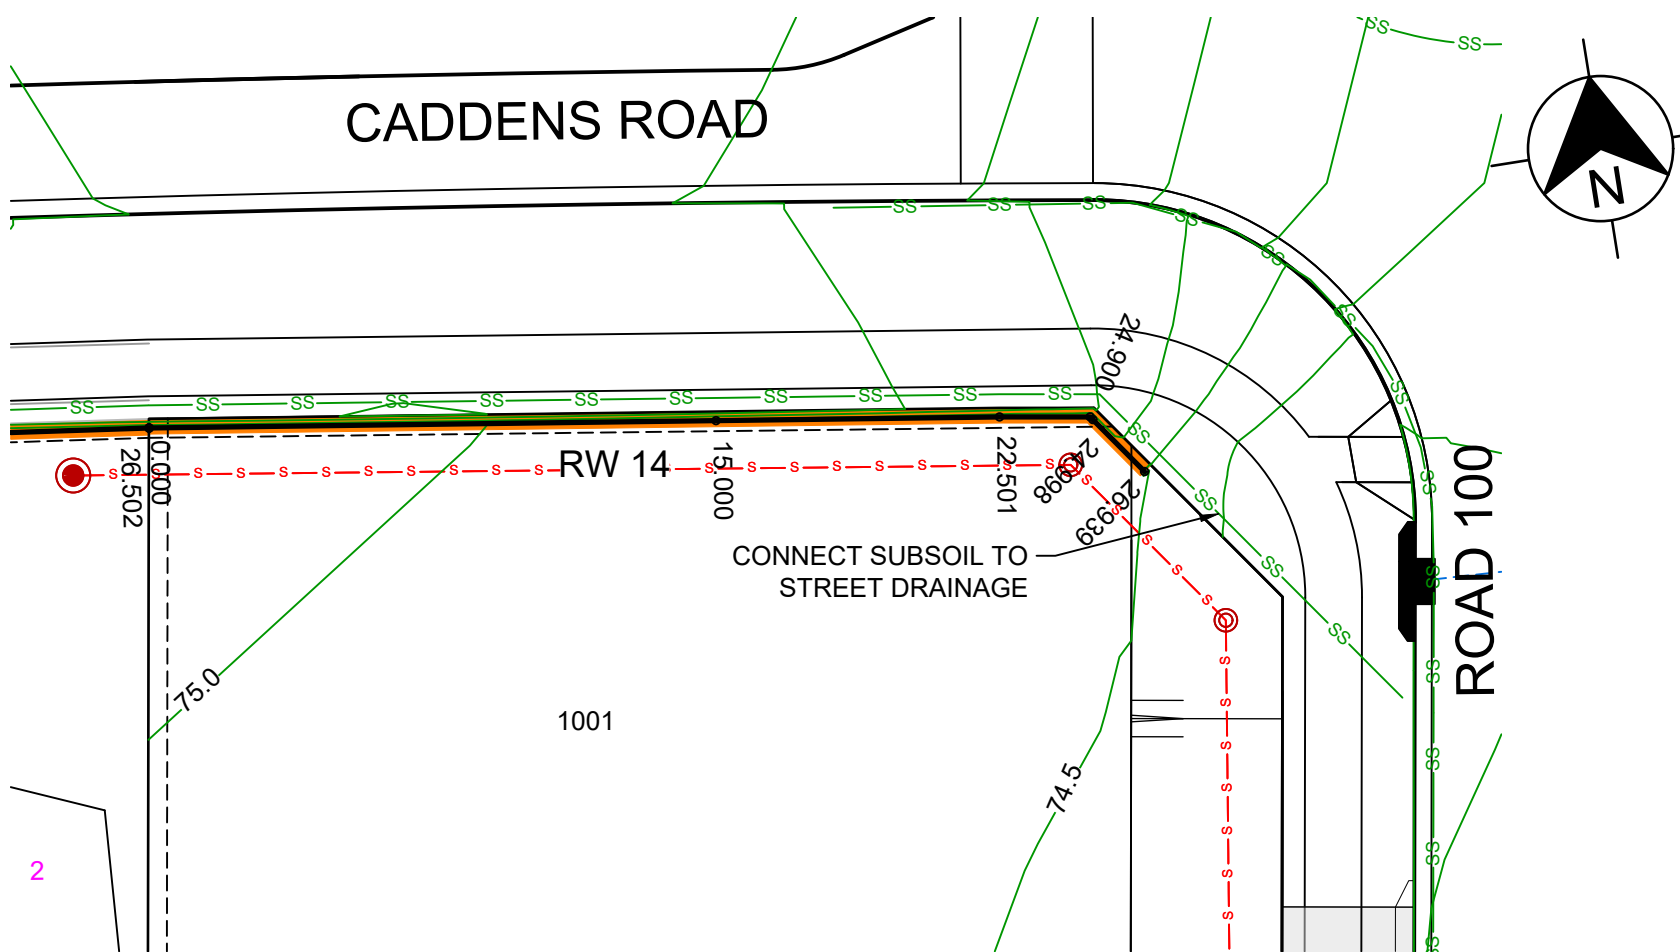

PLAN RW 14
SCALE 1:200

RW 14			
CHAINAGE	EASTING	NORTHING	BEARING
0	289550.4	6260387.65	98°58'16.86"
15	289565.22	6260385.31	98°58'16.86"
22.5	289572.63	6260384.14	
24.9	289574.99	6260383.74	
26.94	289576.17	6260382.07	144°46'01.69"

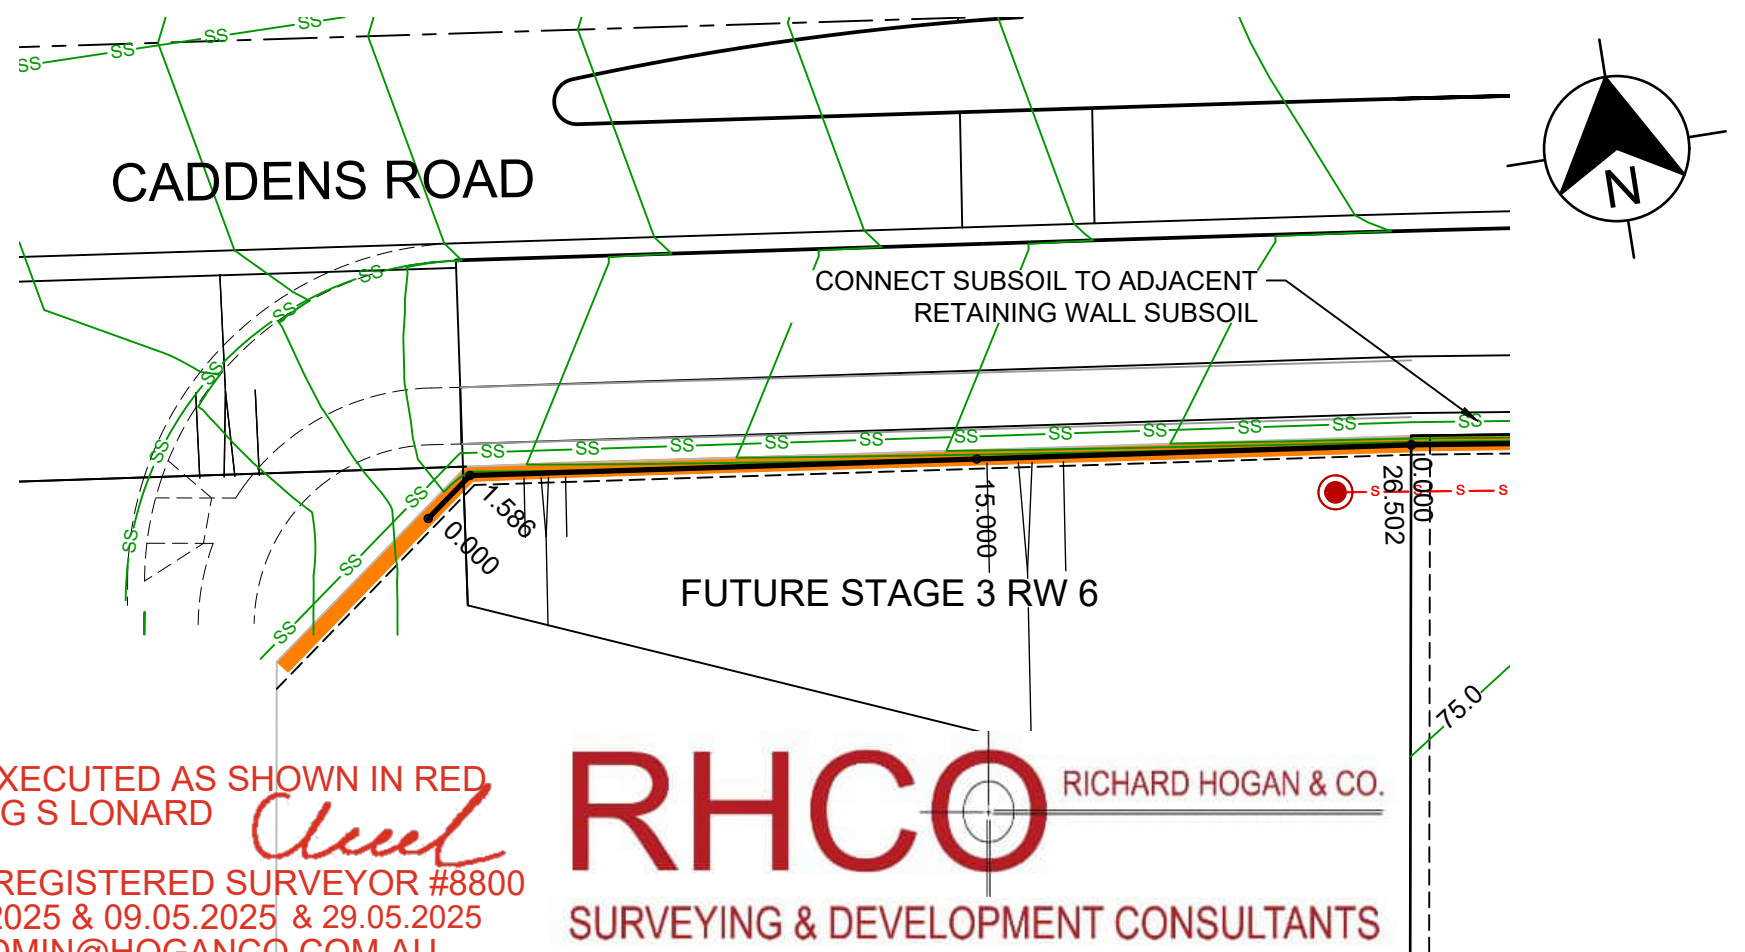


PLAN FUTURE STAGE 3 RW 6
SCALE 1:200

STAGE 3 RW 6			
CHAINAGE	EASTING	NORTHING	BEARING
0	289524.44	6260390.12	53°50'05.94"
1.59	289525.72	6260391.06	
15	289539.01	6260389.22	97°51'10.17"
26.5	289550.4	6260387.65	97°51'10.17"

WORKS AS EXECUTED AS SHOWN IN RED
NAME: - CRAIG S LONARD
SIGNATURE:
CAPACITY: - REGISTERED SURVEYOR #8800
DATE: 17.04.2025 & 09.05.2025 & 29.05.2025
CONTACT: ADMIN@HOGANCO.COM.AU

RHCO RICHARD HOGAN & CO.
SURVEYING & DEVELOPMENT CONSULTANTS

THIS RETAINING WALL (RW 13) FRONTS A PUBLIC ROAD. THE SUPPORTS SHALL BE PAINTED TO MATCH THE SANDSTONE COLOURED PANELS

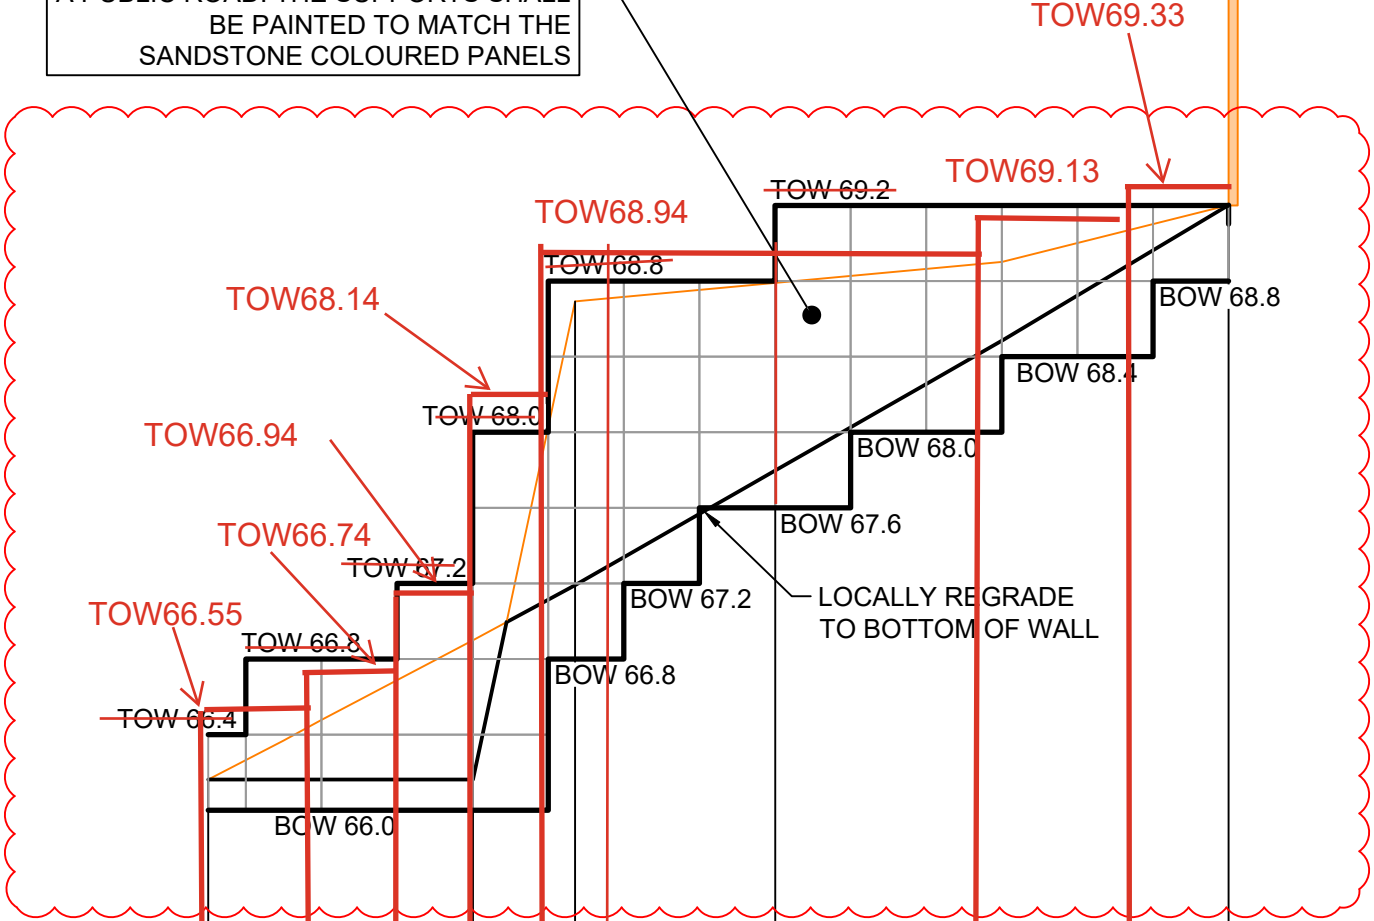


DATUM 63.0													
TOE OF WALL	GROUND LEVELS	0.000	66.102	66.102	66.35	66.55	66.65	66.65	66.65	66.95	66.97	66.102	66.300
TOP OF WALL		66.35	66.65	66.5	66.65	66.5	66.65	66.65	66.95	66.97	66.102	66.300	
GROUND LEVELS		66.102	66.35	66.65	66.5	66.65	66.65	66.95	66.97	66.102	66.300		
CHAINAGE		0.000	2.9	4.9	7.004	9.0	9.704	10.7	15.000	21.0	25.0	26.995	
		66.102	66.35	66.65	66.5	66.65	66.65	66.95	66.97	66.102	66.300		

LONGITUDINAL SECTION RW 13
HORIZONTAL SCALE 1:200
VERTICAL SCALE 1:40

ALL WAE LEVELS FOR RET WALL 13 UPDTAED 29.05.2025

THIS RETAINING WALL (RW 14) MAY HAVE SUPPORTS FRONTING A PUBLIC ROAD. THE SUPPORTS SHALL BE PAINTED TO MATCH THE SANDSTONE COLOURED PANELS

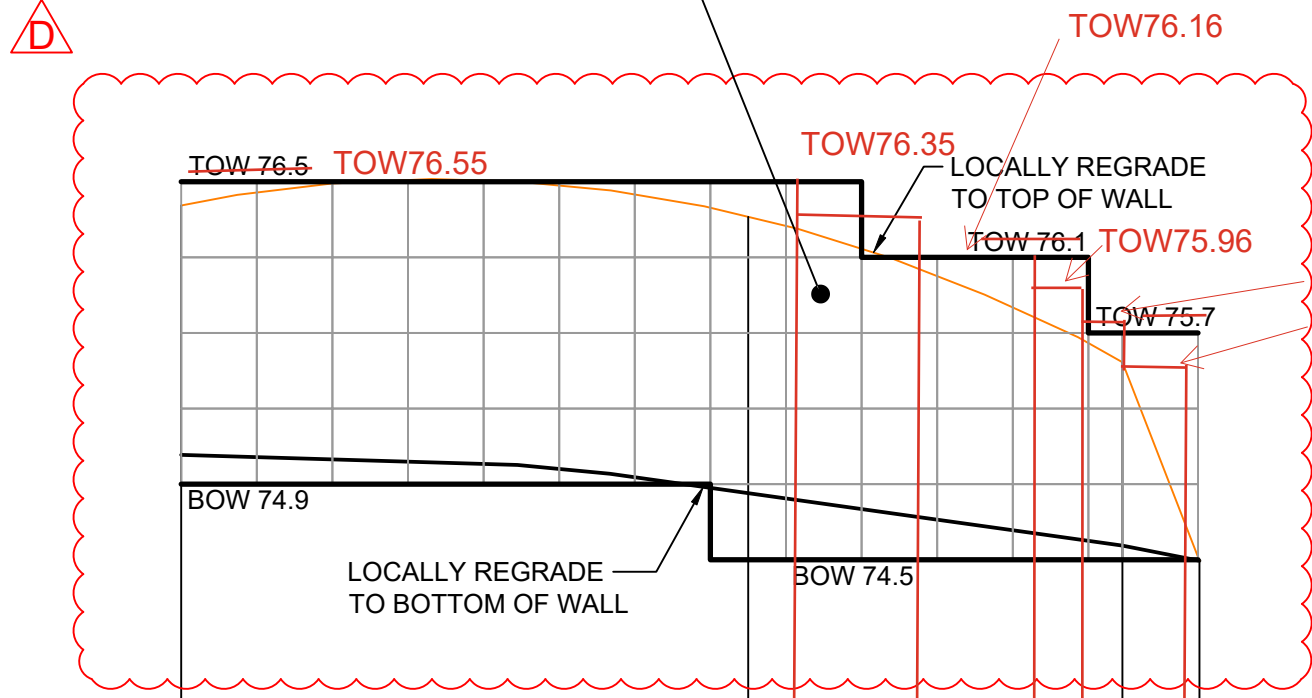

DATUM 71.0											
TOE OF WALL	GROUND LEVELS	0.000	15.000	15.9	20.0	22.0	24.0	24.900	26.300	26.2	26.2
TOP OF WALL		76.374	76.314	76.8	76.3	76.0	74.6	74.496	74.086	74.4	74.4
GROUND LEVELS		76.374	76.314	76.8	76.3	76.0	74.6	74.496	74.086	74.4	74.4
CHAINAGE		0.000	15.000	15.9	20.0	22.0	24.0	24.900	26.300	26.2	26.2
		0.000	15.000	15.9	20.0	22.0	24.0	24.900	26.300	26.2	26.2


LONGITUDINAL SECTION RW 14
HORIZONTAL SCALE 1:200
VERTICAL SCALE 1:40

LEGEND

- RETAINING WALL (SLEEPER WALL)
- INTERALLOTMENT DRAINAGE LINE & PIT
- DRAINAGE LINE & PIT
- SUBSOIL

- NOTES:**
- LOCALLY GRADE THE TOP & BOTTOM OF RETAINING WALL GROUND LEVELS TO MAINTAIN 1.5m MAX. VISIBLE HEIGHT
 - RETAINING WALL PROFILES SHOWN ARE INDICATIVE ONLY.
 - SUBJECT TO STRUCTURAL CERTIFICATION THE SUPPORTS/POSTS SHALL BE PAINTED TO MATCH THE SANDSTONE COLOURED PANELS FOR ALL THE RETAINING WALLS THAT FRONTS A PUBLIC ROAD. THIS INCLUDES THE FIRST 6m FROM THE STREET OF THE SIDE LOT RETAINING WALLS



THIS RETAINING WALL (STAGE 3 RW 6) MAY HAVE SUPPORTS FRONTING A PUBLIC ROAD. THE SUPPORTS SHALL BE PAINTED TO MATCH THE SANDSTONE COLOURED PANELS

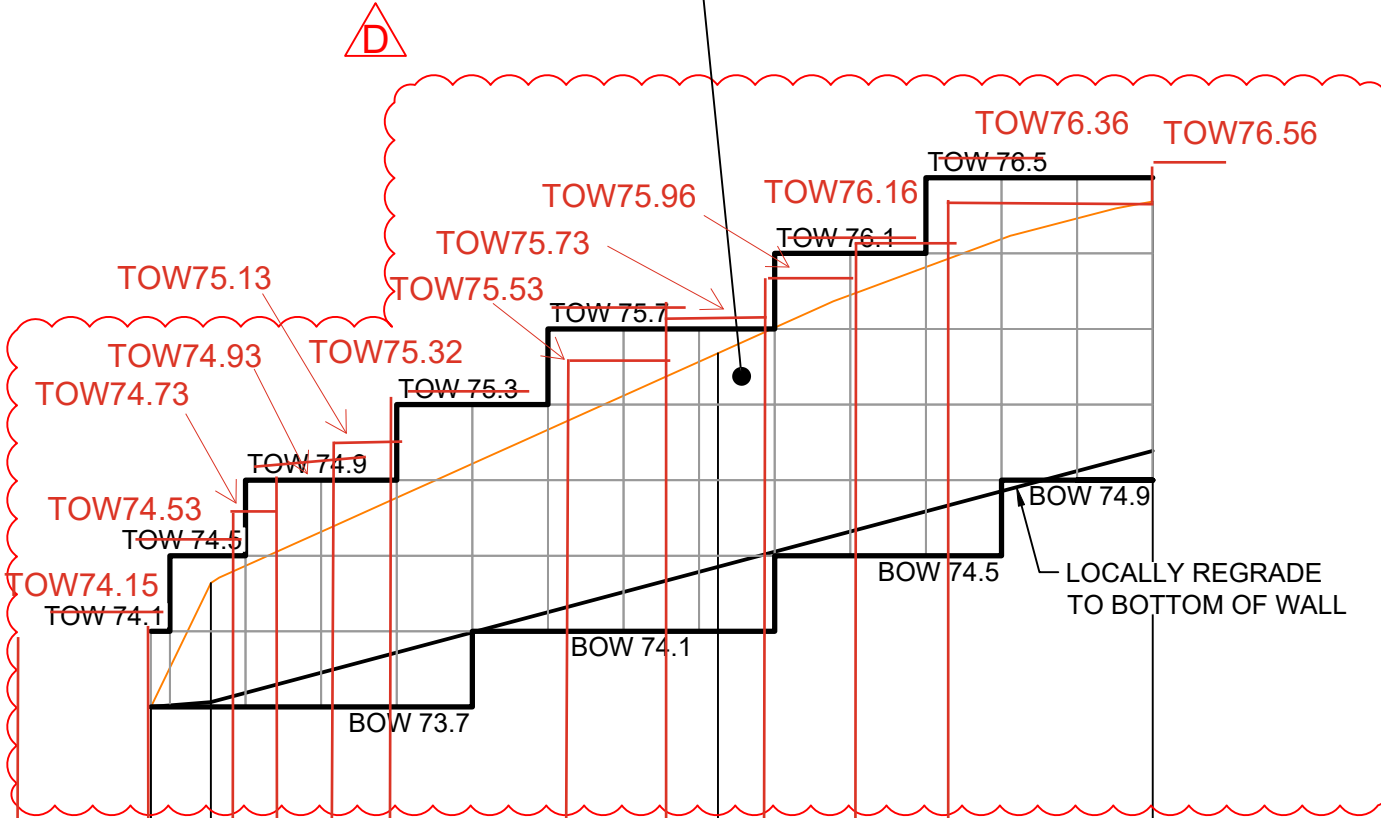

DATUM 71.0												
TOE OF WALL	GROUND LEVELS	-5.0	0.000	1.596	2.5	4.5	6.5	8.5	12.5	14.5	15.000	
		73.9	73.9	73.726	74.2	74.4	74.6	74.8	74.95	75.1	75.572	
TOP OF WALL		73.9	73.9	73.726	74.2	74.4	74.6	74.8	74.95	75.1	75.572	
GROUND LEVELS		73.9	73.9	73.726	74.2	74.4	74.6	74.8	74.95	75.1	75.572	
CHAINAGE		-5.0	0.000	1.596	2.5	4.5	6.5	8.5	12.5	14.5	15.000	

LONGITUDINAL SECTION FUTURE STAGE 3 RW 6

HORIZONTAL SCALE 1:200
VERTICAL SCALE 1:40

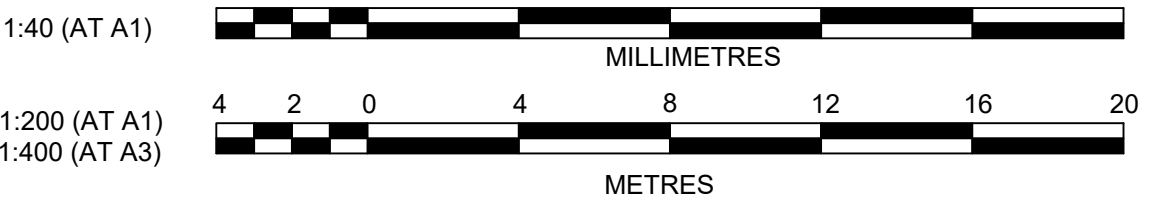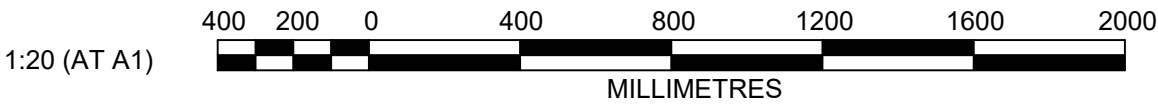

AMENDMENT	DES	DRN	CKD	APR	DATE
D					07/11/24
C					27/09/24
B					12/09/24
A					10/04/24

J. WYNDHAM PRINCE
CONSULTING CIVIL INFRASTRUCTURE ENGINEERS & PROJECT MANAGERS

PO Box 4366 PENRITH WESTFIELD NSW 2750
P 02 4720 3300 W www.jwprince.com.au E jwp@jwprince.com.au



ISSUE FOR CONSTRUCTION



THIS DRAWING MUST NOT BE USED FOR CONSTRUCTION UNLESS SIGNED AS PART OF AN APPROVED CONSTRUCTION CERTIFICATE.

ORCHARD HILLS NORTH
STAGE 1 CADDENS ROAD
RETAINING WALL PLAN & LONGITUDINAL SECTIONS
SHEET 9

AZIMUTH: M.G.A. 2020 DATUM: A.H.D. ORIGIN: SSM 1112 PLAN No: 110265-09-DD1608

PROJECT No:
110265-09
SHEET No:
DD1608

D

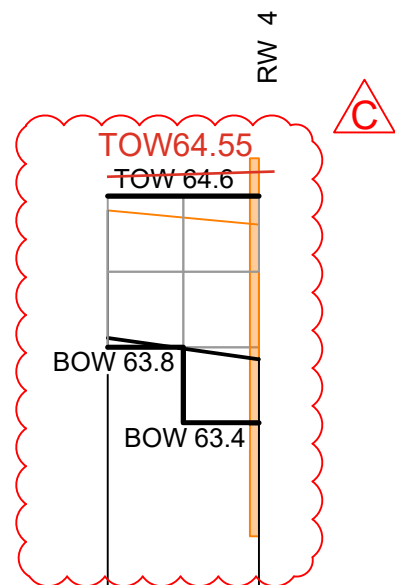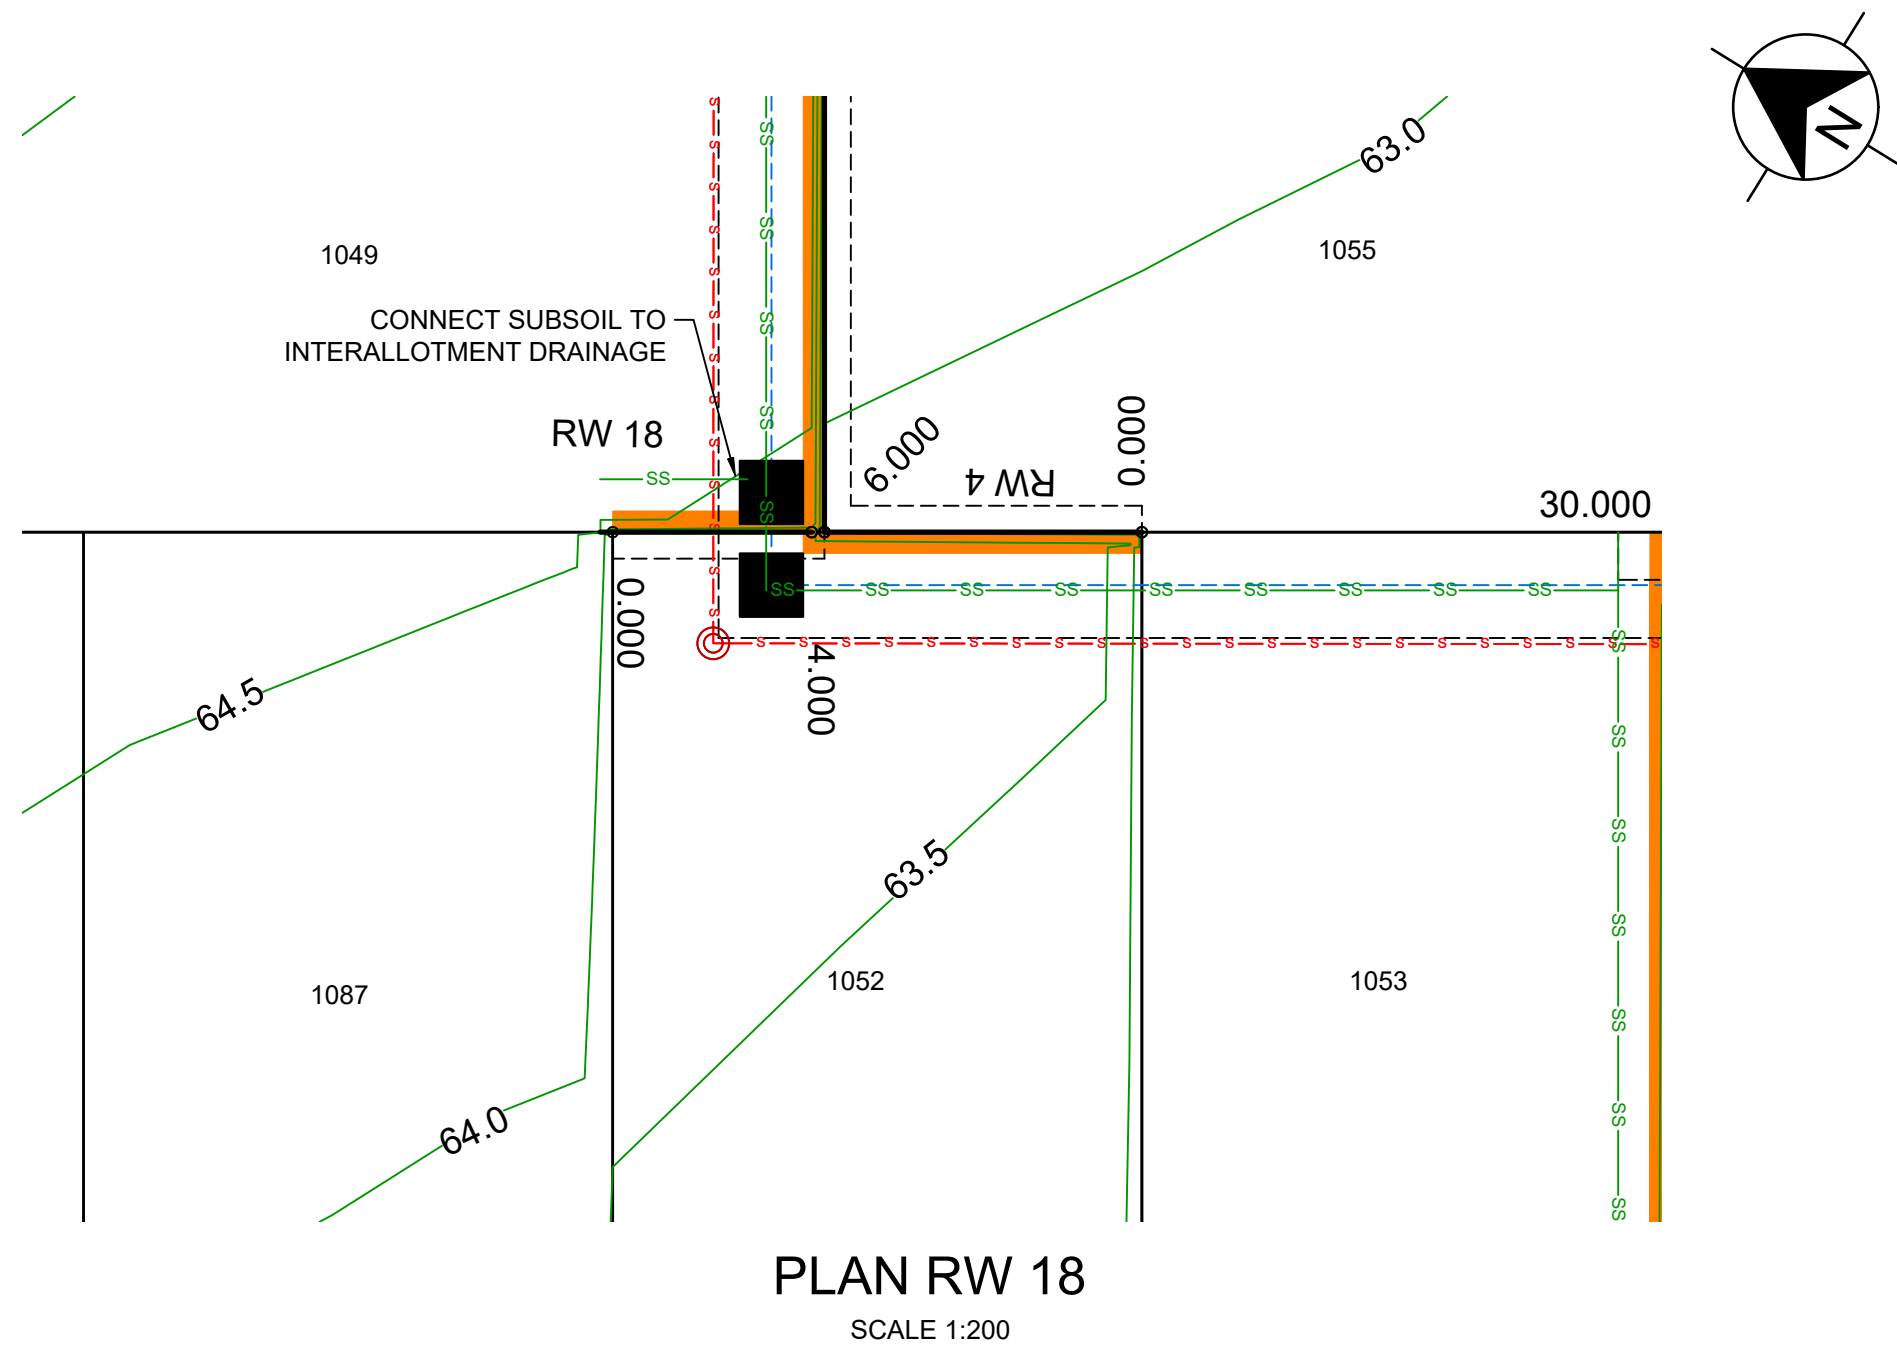

WORKS AS EXECUTED AS SHOWN IN RED
NAME: - CRAIG S LONARD
SIGNATURE: *Craig S Lonard*
CAPACITY: - REGISTERED SURVEYOR #8800
DATE: 17.04.2025
CONTACT: ADMIN@HOGANCO.COM.AU

RHCO RICHARD HOGAN & CO.
SURVEYING & DEVELOPMENT CONSULTANTS

DATUM 61.0	
TOE OF WALL	
GROUND LEVELS	63.59 63.50 63.50 63.745
TOP OF WALL	
GROUND LEVELS	64.524 64.5 64.5 64.449
CHAINAGE	0.000 4.000

LONGITUDINAL SECTION RW 18
HORIZONTAL SCALE 1:200
VERTICAL SCALE 1:40


RW 18			
CHAINAGE	EASTING	NORTHING	BEARING
0	289713.82	6260163.23	58°15'22.39"
4	289717.02	6260165.21	58°15'22.39"

- NOTES:
- LOCALLY GRADE THE TOP & BOTTOM OF RETAINING WALL GROUND LEVELS TO MAINTAIN 1.5m MAX. VISIBLE HEIGHT
 - RETAINING WALL PROFILES SHOWN ARE INDICATIVE ONLY. SUBJECT TO STRUCTURAL CERTIFICATION
 - THE SUPPORTS/POSTS SHALL BE PAINTED TO MATCH THE SANDSTONE COLOURED PANELS FOR ALL THE RETAINING WALLS THAT FRONTS A PUBLIC ROAD. THIS INCLUDES THE FIRST 6m FROM THE STREET OF THE SIDE LOT RETAINING WALLS


LEGEND

- RETAINING WALL (SLEEPER WALL)
- INTERALLOTMENT DRAINAGE LINE & PIT
- DRAINAGE LINE & PIT
- SUBSOIL

PENRITH CITY COUNCIL
This plan / document relates to
Development Consent: DA23/0969
Subdivision Works Certificate: EA24/0036.01
Subject to the conditions outlined in the consent

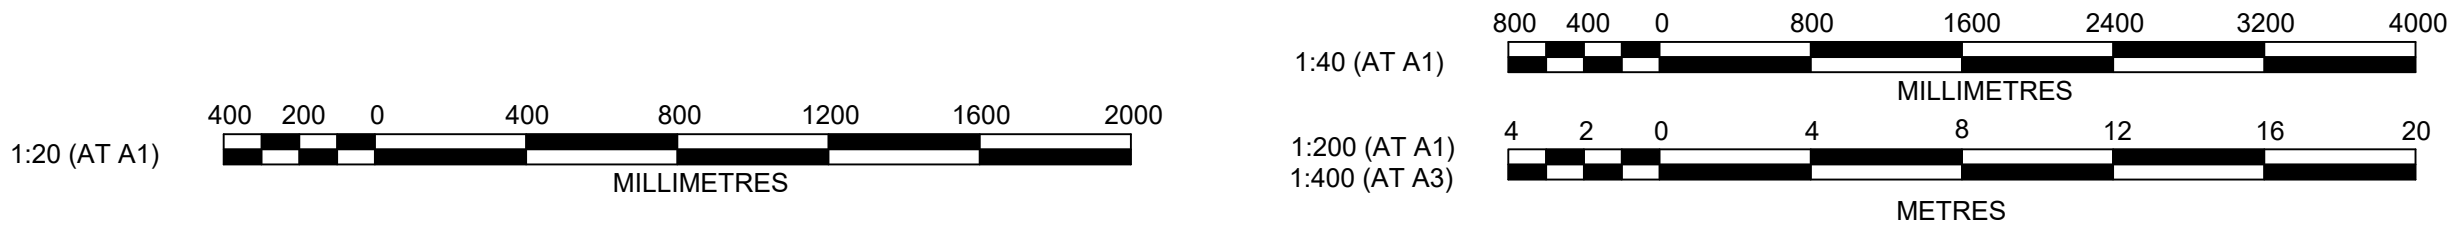

J. WYNDHAM PRINCE CONSULTING CIVIL INFRASTRUCTURE ENGINEERS & PROJECT MANAGERS PO Box 4366 PENRITH WESTFIELD NSW 2750 P 02 4720 3300 W www.jwprince.com.au E jwp@jwprince.com.au	CLIENT: LEGACYPROPERTY	STATUS: ISSUE FOR CONSTRUCTION THIS DRAWING MUST NOT BE USED FOR CONSTRUCTION UNLESS SIGNED AS PART OF AN APPROVED CONSTRUCTION CERTIFICATE.	ORCHARD HILLS NORTH STAGE 1 CADDENS ROAD RETAINING WALL PLAN & LONGITUDINAL SECTIONS SHEET 11	PROJECT No: 110265-09 SHEET No: DD1610																												
<table><tr><th>AMENDMENT</th><th>DES</th><th>DRN</th><th>CKD</th><th>APR</th><th>DATE</th></tr><tr><td>C</td><td>AMEND RETAINING WALL PROFILE TO SLEEPER WALL</td><td>MMC</td><td>EJ</td><td>MS</td><td>MS</td><td>07/11/24</td></tr><tr><td>B</td><td>FOR CONSTRUCTION</td><td>MMC</td><td>GA</td><td>MS</td><td>MS</td><td>27/09/24</td></tr><tr><td>A</td><td>RETAINING WALL ADDED; LONG SECTIONS, SETOUT & TYPICAL ADDED</td><td>MMC</td><td>GA</td><td>DG</td><td>CR</td><td>12/09/24</td></tr></table>	AMENDMENT	DES	DRN	CKD	APR	DATE	C	AMEND RETAINING WALL PROFILE TO SLEEPER WALL	MMC	EJ	MS	MS	07/11/24	B	FOR CONSTRUCTION	MMC	GA	MS	MS	27/09/24	A	RETAINING WALL ADDED; LONG SECTIONS, SETOUT & TYPICAL ADDED	MMC	GA	DG	CR	12/09/24	AZIMUTH: M.G.A. 2020	DATUM: A.H.D.	ORIGIN: SSM 1112	PLAN No: 110265-09-DD1610	C
AMENDMENT	DES	DRN	CKD	APR	DATE																											
C	AMEND RETAINING WALL PROFILE TO SLEEPER WALL	MMC	EJ	MS	MS	07/11/24																										
B	FOR CONSTRUCTION	MMC	GA	MS	MS	27/09/24																										
A	RETAINING WALL ADDED; LONG SECTIONS, SETOUT & TYPICAL ADDED	MMC	GA	DG	CR	12/09/24																										

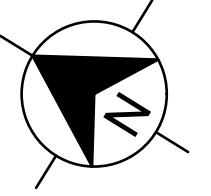


- LOCALLY GRADE THE TOP & BOTTOM OF RETAINING WALL GROUND LEVELS TO MAINTAIN 1.5m MAX. VISIBLE HEIGHT
- RETAINING WALL PROFILES SHOWN ARE INDICATIVE ONLY.
- SUBJECT TO STRUCTURAL CERTIFICATION
- THE SUPPORTS/POSTS SHALL BE PAINTED TO MATCH THE SANDSTONE COLOURED PANELS FOR ALL THE RETAINING WALLS THAT FRONTS A PUBLIC ROAD. THIS INCLUDES THE FIRST 6m FROM THE STREET OF THE SIDE LOT RETAINING WALLS

Diagram illustrating the components of a retaining wall system:


- RETAINING WALL (SLEEPER WALL)
- INTERALLOTMENT DRAINAGE LINE & PIT
- DRAINAGE LINE & PIT
- SUBSOIL

PLAN STAGE 3 RW 1
SCALE 1:200

RICHARD HOGAN & CO.

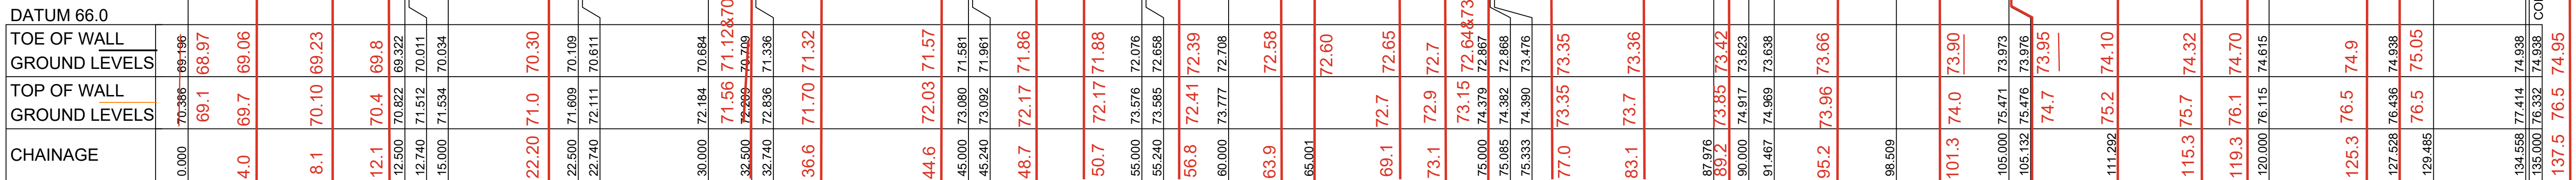

HORIZONTAL SCALE 1:200
VERTICAL SCALE 1:40

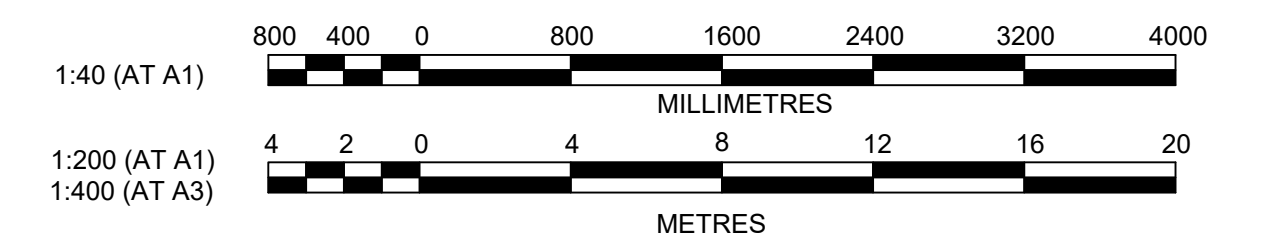

C	AMEND RETAINING WALL PROFILE TO SLEEPER WALL	MMC	EJ	MS	MS	07/11/24
B	FOR CONSTRUCTION	MMC	GA	MS	MS	27/09/24
A	RETAINING WALL ADDED; LONG SECTIONS, SETOUT & TYPICAL ADDED	MMC	GA	DG	CR	12/09/24
	AMENDMENT	DES	DRN	CKD	APR	DATE

PO Box 4366 PENRITH WESTFIELD NSW 2750
P 02 4720 3300 W www.jwprince.com.au E jwp@jwprince.com.au



LEGACYPROPERTY

ISSUE FOR CONSTRUCTION



THIS DRAWING MUST NOT BE USED FOR CONSTRUCTION UNLESS
SIGNED AS PART OF AN APPROVED CONSTRUCTION CERTIFICATE.

ORCHARD HILLS NORTH
STAGE 1 CADDENS ROAD
RETAINING WALL PLAN & LONGITUDINAL SECTIONS
SHEET 12

PROJECT No:	110265-09
SHEET No:	DD1611

AZIMUTH:	M.G.A. 2020	DATUM: A.H.D.	ORIGIN: SSM 1112	PLAN No: 110265-09-DD1611	C
----------	----------------	---------------	------------------	---------------------------	---


1

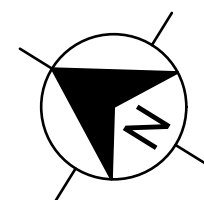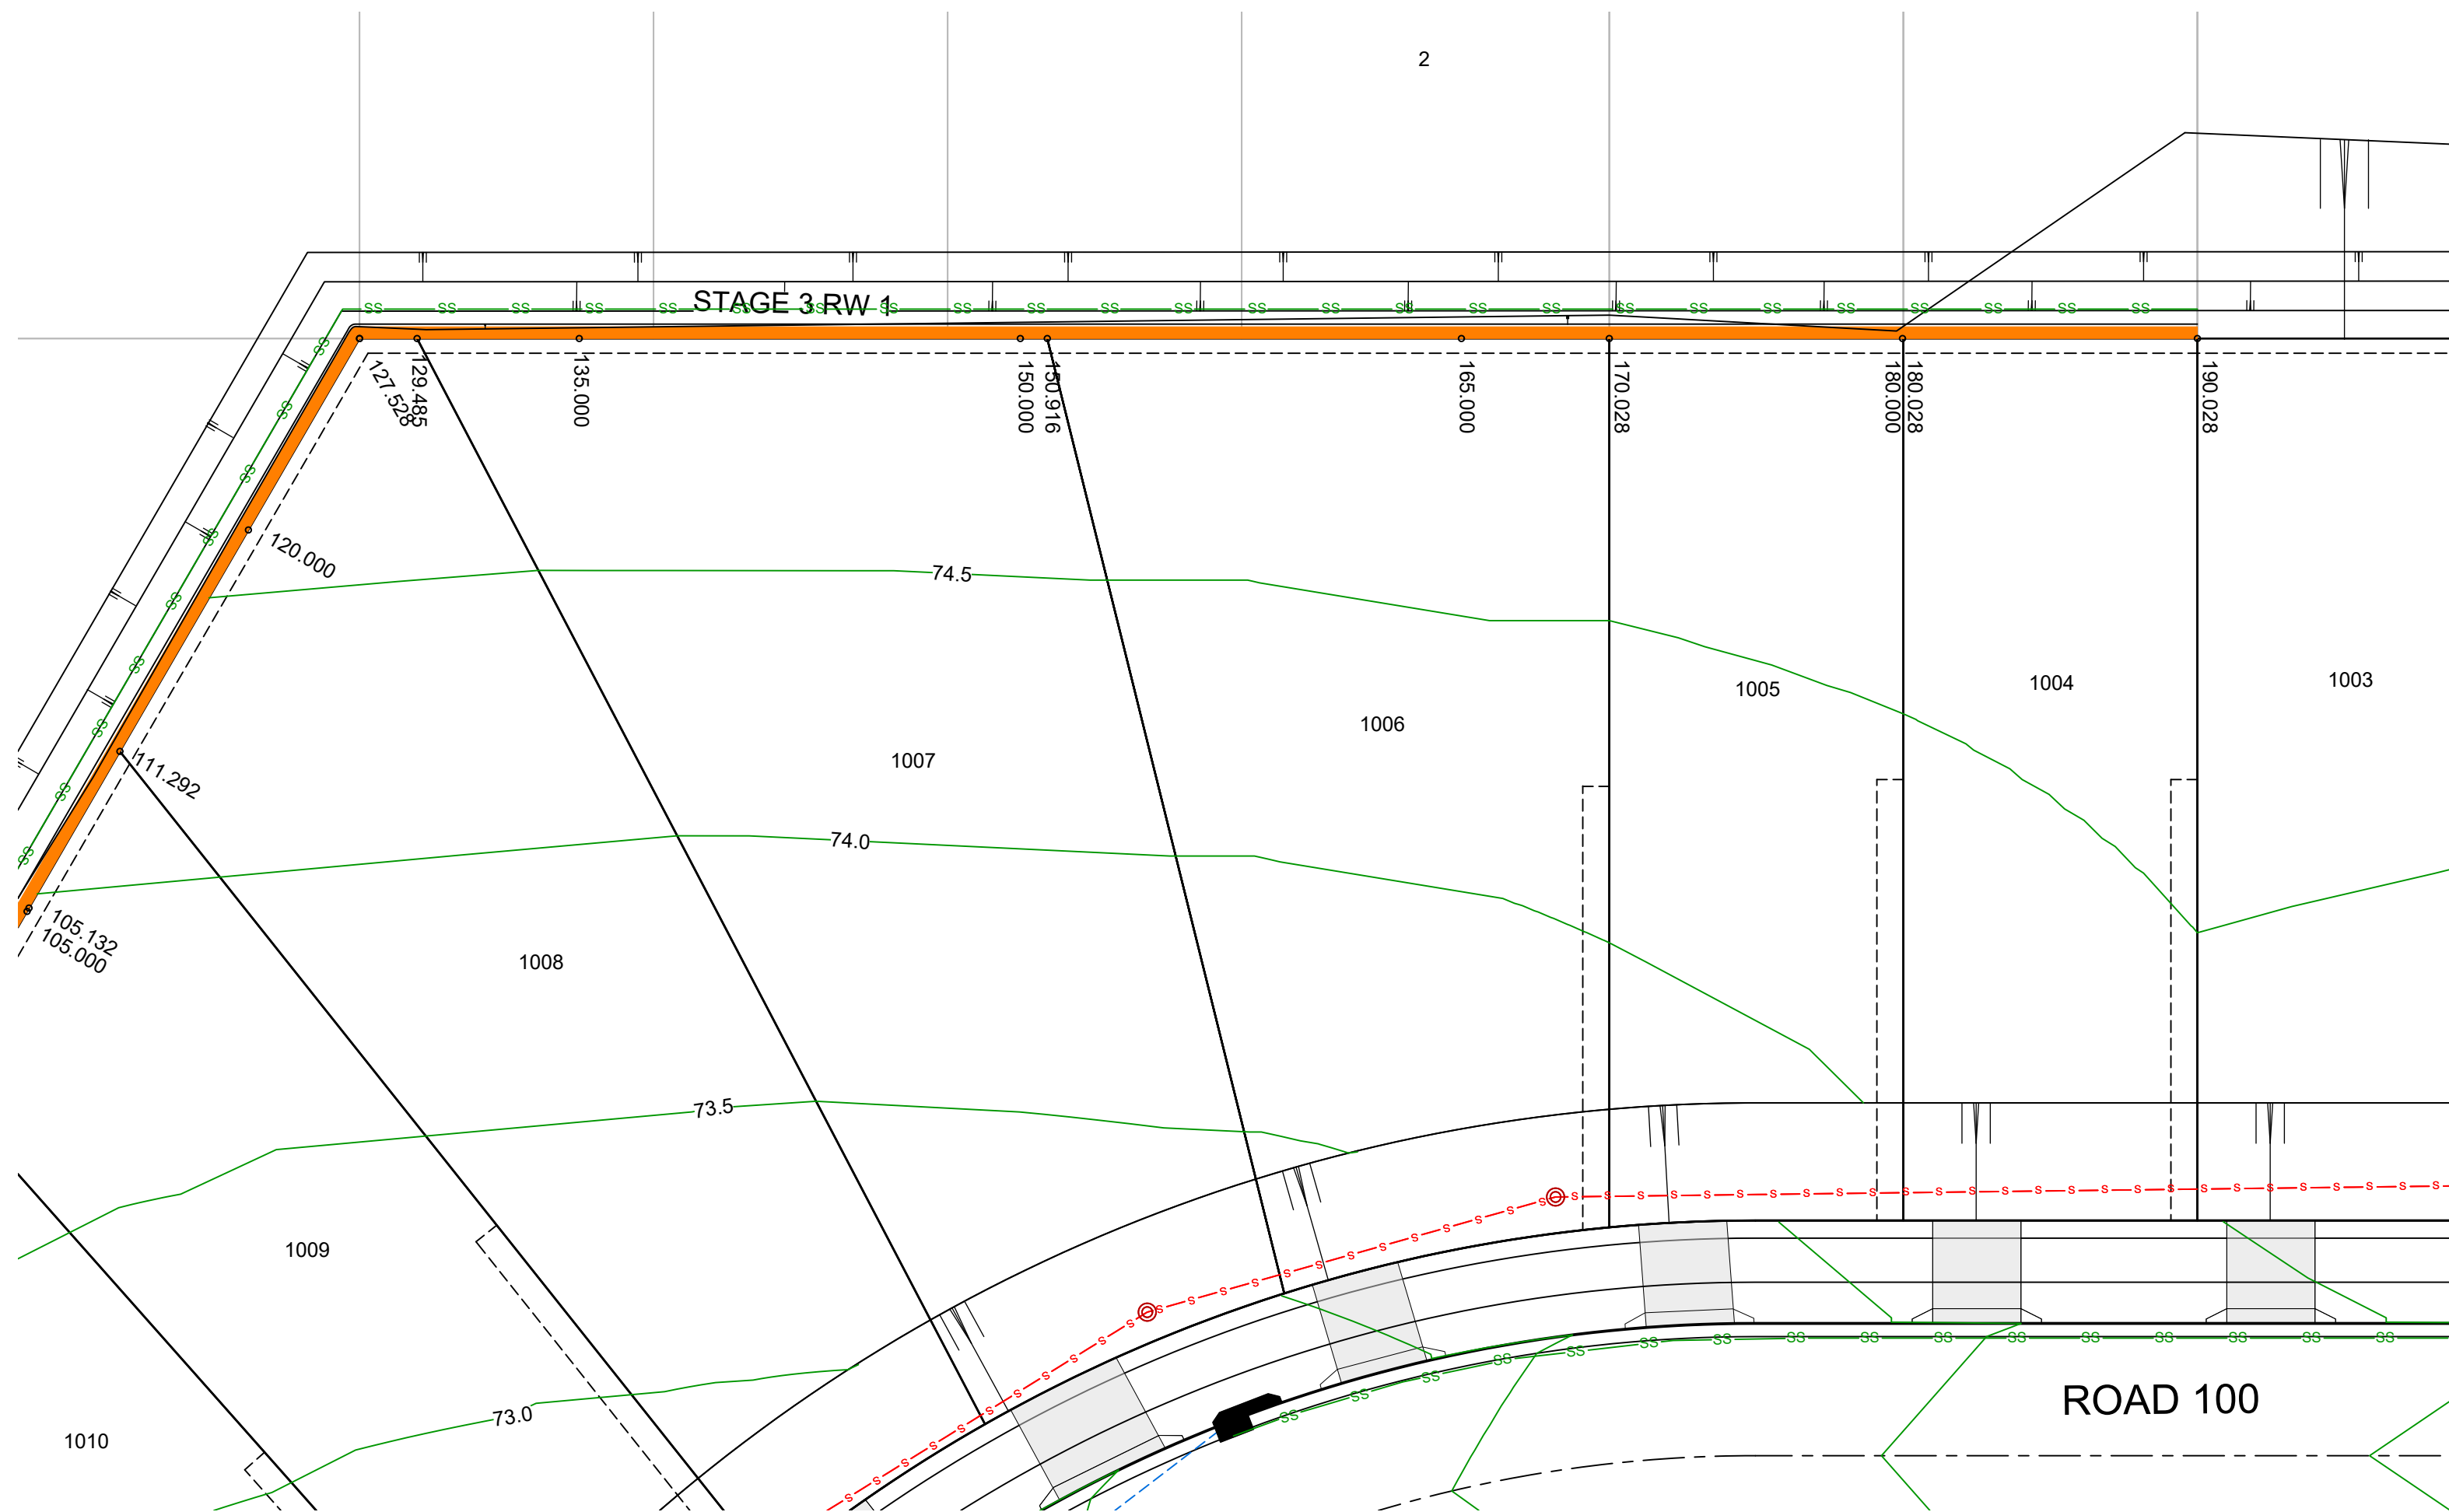

STAGE 3 RW 1			
CHAINAGE	EASTING	NORTHING	BEARING
0	289613.14	6260189.13	328°15'22.39"
15	289605.25	6260201.89	328°15'22.39"
30	289597.35	6260214.64	328°15'22.39"
45	289589.46	6260227.4	328°15'22.39"
55	289584.2	6260235.9	
60	289581.53	6260240.13	327°40'38.71"
65	289578.85	6260244.35	
75	289572.54	6260252.11	320°49'31.94"
75.09	289572.48	6260252.17	
87.98	289563.23	6260261.14	
90	289561.68	6260262.44	309°56'23.88"
105	289550.18	6260272.07	309°56'23.88"
120	289538.68	6260281.7	309°56'23.88"
127.53	289532.9	6260286.54	
135	289534.18	6260293.9	9°49'01.32"
150	289536.74	6260308.68	9°49'01.32"
165	289539.29	6260323.46	9°49'01.32"
180	289541.85	6260338.24	9°49'01.32"
190.03	289543.56	6260348.12	9°49'01.32"

PLAN STAGE 3 RW 1
SCALE 1:200

TOW LEVELS ADDED 29.05.2025

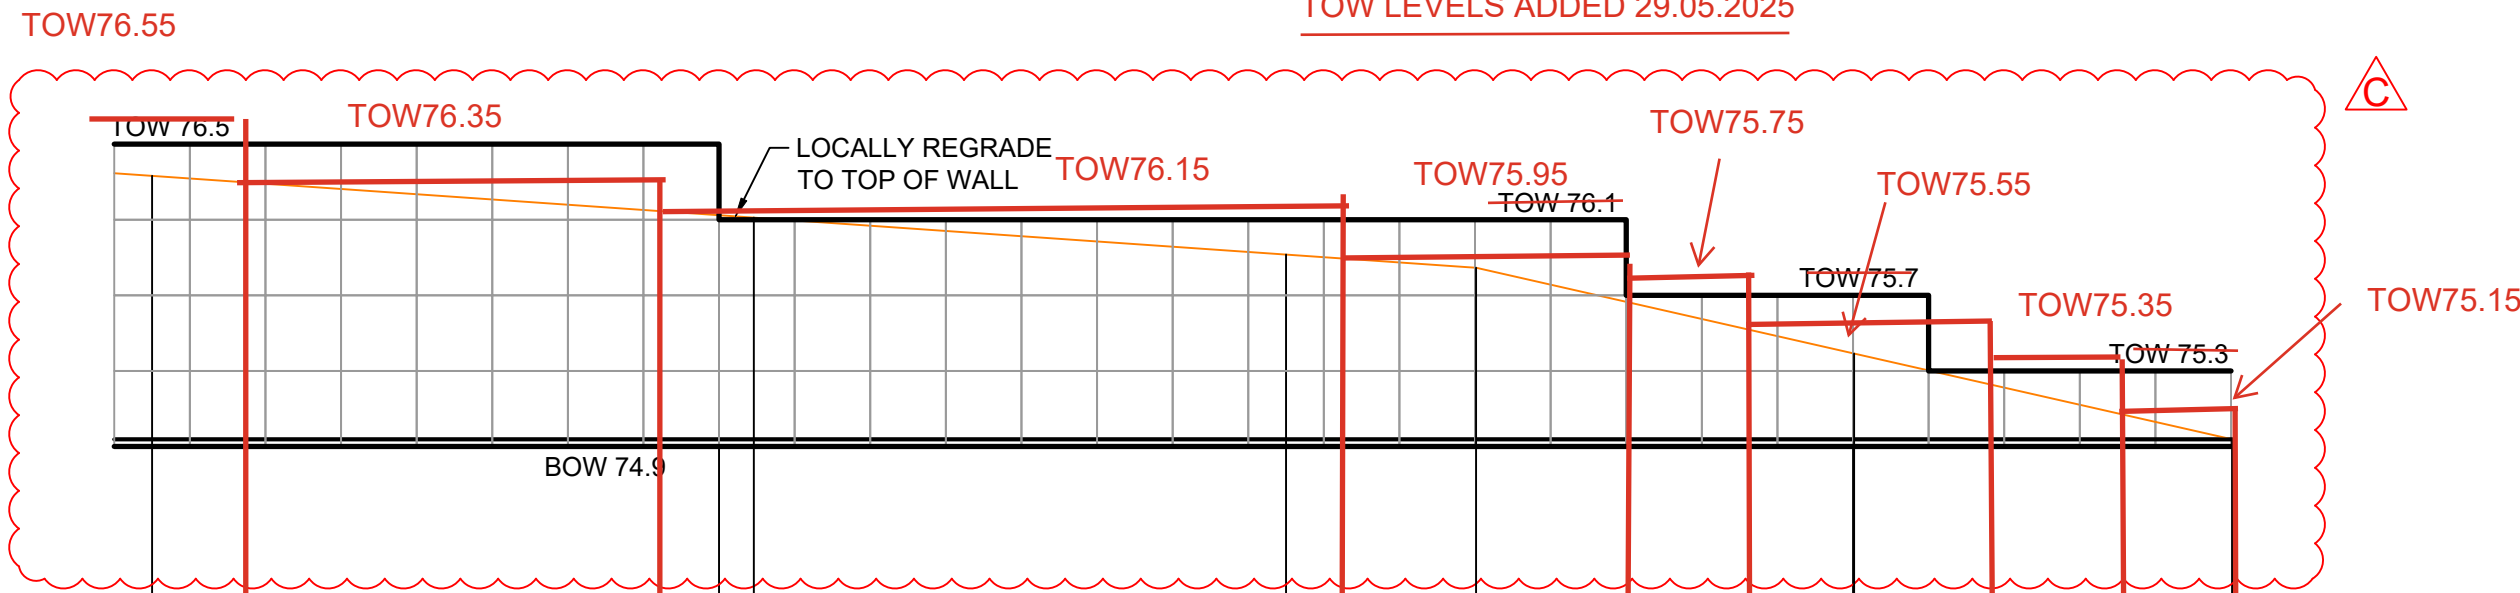

DATUM 72.0

TOE OF WALL GROUND LEVELS	74.938	74.96	74.87	74.938	74.938	74.92	74.82	74.77	74.938	74.81	74.88	74.938	74.81
TOP OF WALL GROUND LEVELS	76.332	76.5	76.3	76.124	76.124	76.04	75.85	75.7	75.393	75.3	75.3	75.393	75.3
CHAINAGE	135.000	137.5	149.6	150.000	150.916	165.000	173.7	177.8	180.000	180.028	183.8	187.8	190.028

LONGITUDINAL SECTION STAGE 3 RW 1



HORIZONTAL SCALE 1:200
VERTICAL SCALE 1:40

LEGEND

- RETAINING WALL (SLEEPER WALL)
- INTERALLOTMENT DRAINAGE LINE & PIT
- DRAINAGE LINE & PIT
- SUBSOIL

NOTES:

- LOCALLY GRADE THE TOP & BOTTOM OF RETAINING WALL GROUND LEVELS TO MAINTAIN 1.5m MAX. VISIBLE HEIGHT
- RETAINING WALL PROFILES SHOWN ARE INDICATIVE ONLY. SUBJECT TO STRUCTURAL CERTIFICATION
- THE SUPPORTS/POSTS SHALL BE PAINTED TO MATCH THE SANDSTONE COLOURED PANELS FOR ALL THE RETAINING WALLS THAT FRONTS A PUBLIC ROAD. THIS INCLUDES THE FIRST 6m FROM THE STREET OF THE SIDE LOT RETAINING WALLS

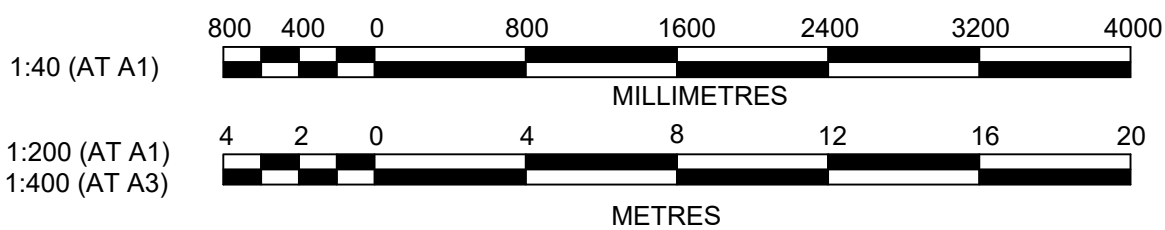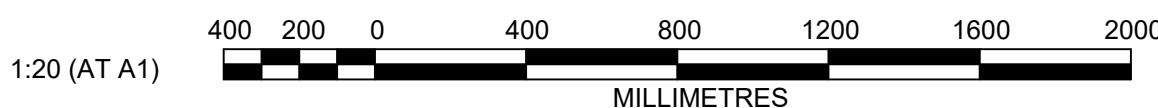

WORKS AS EXECUTED AS SHOWN IN RED
NAME: - CRAIG S LONARD
SIGNATURE: *Craig S Lonard*
CAPACITY: - REGISTERED SURVEYOR #8800
DATE: 17.04.2025 & 09.05.2025 & 29.05.2025
CONTACT: ADMIN@HOGANCO.COM.AU
RHCO RICHARD HOGAN & CO.
SURVEYING & DEVELOPMENT CONSULTANTS

AMENDMENT	DES	DRN	CKD	APR	DATE
C	AMEND RETAINING WALL PROFILE TO SLEEPER WALL	MMC	EJ	MS	07/11/24
B	FOR CONSTRUCTION	MMC	GA	MS	27/09/24
A	RETAINING WALL ADDED; LONG SECTIONS, SETOUT & TYPICAL ADDED	MMC	GA	DG	12/09/24

J. WYNDHAM PRINCE
CONSULTING CIVIL INFRASTRUCTURE ENGINEERS & PROJECT MANAGERS

PO Box 4366 PENRITH WESTFIELD NSW 2750
P 02 4720 3300 W www.jwprince.com.au E jwp@jwprince.com.au

CLIENT:



STATUS:

**ISSUE FOR
CONSTRUCTION**

THIS DRAWING MUST NOT BE USED FOR CONSTRUCTION UNLESS
SIGNED AS PART OF AN APPROVED CONSTRUCTION CERTIFICATE.

ORCHARD HILLS NORTH
STAGE 1 CADDENS ROAD
RETAINING WALL PLAN & LONGITUDINAL SECTIONS
SHEET 13

PROJECT No:


110265-09

SHEET No:

DD1612


AZIMUTH: M.G.A. 2020 DATUM: A.H.D. ORIGIN: SSM 1112 PLAN No: 110265-09-DD1612

C

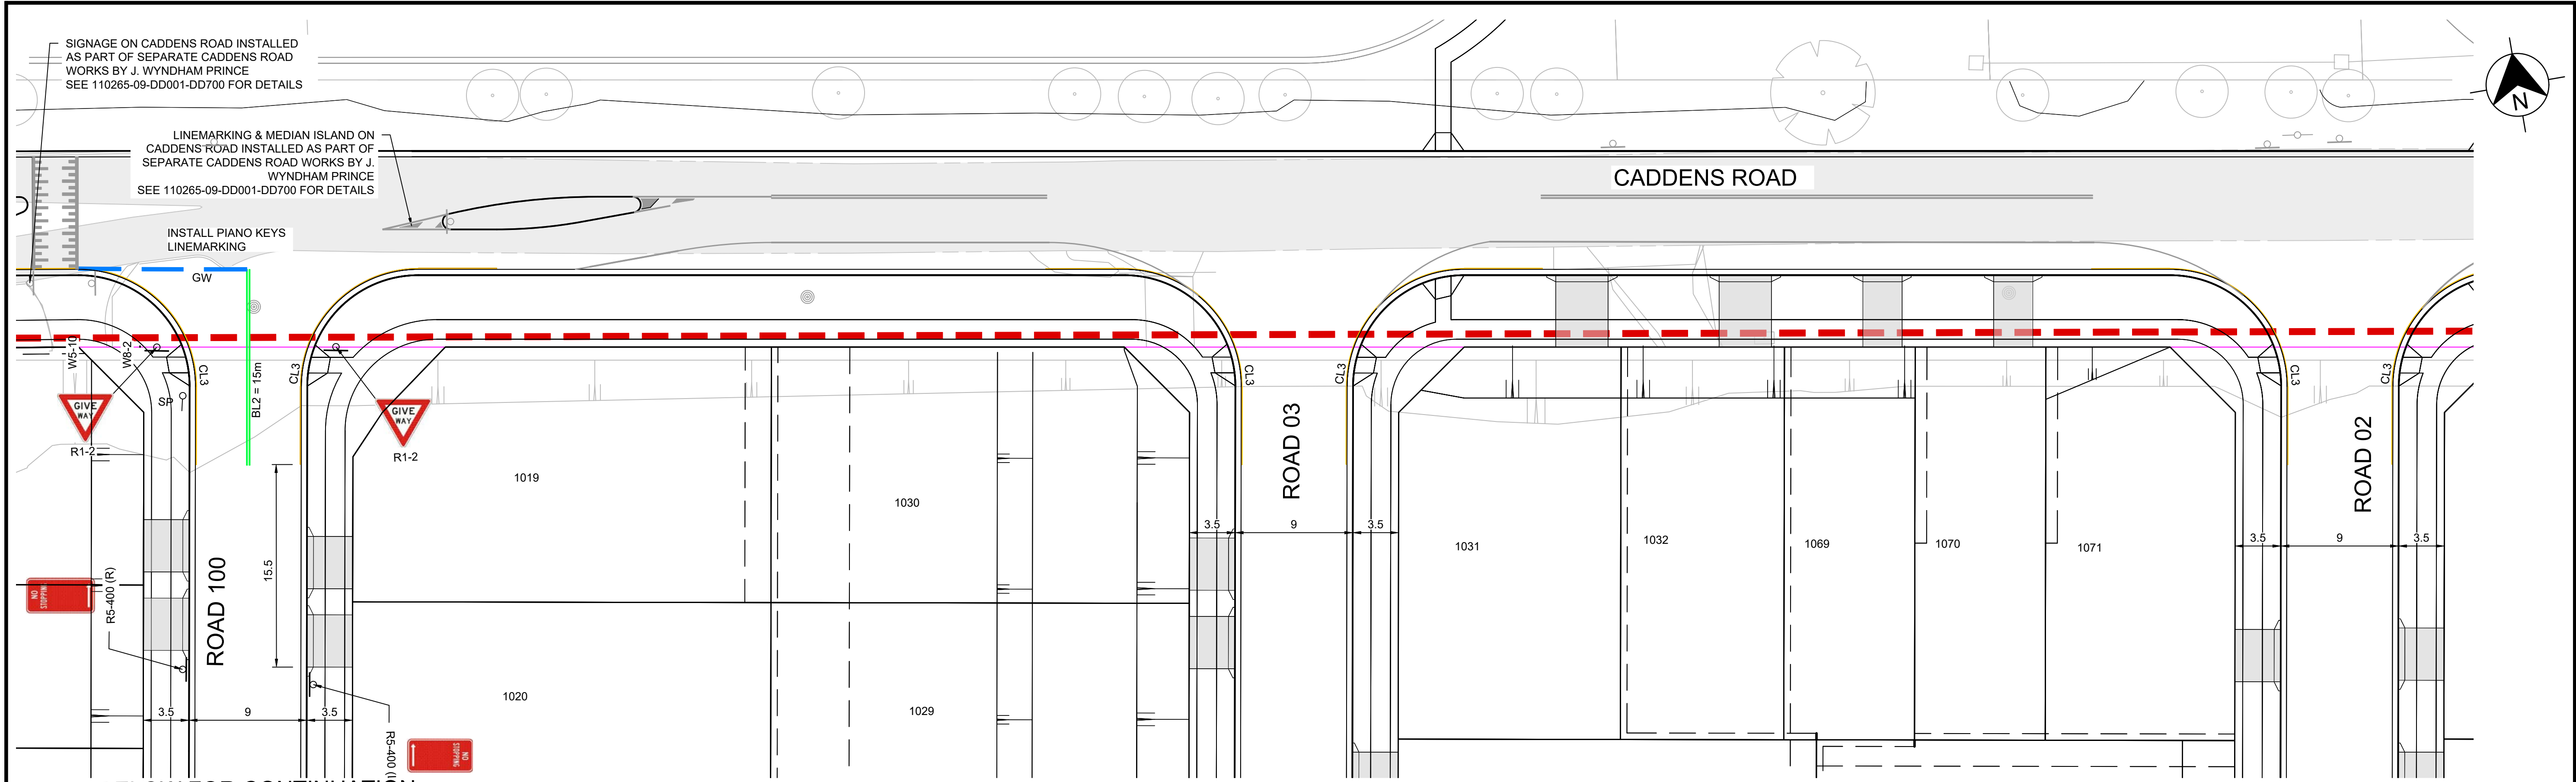

SEE BELOW FOR CONTINUATION

SEE ABOVE FOR CONTINUATION

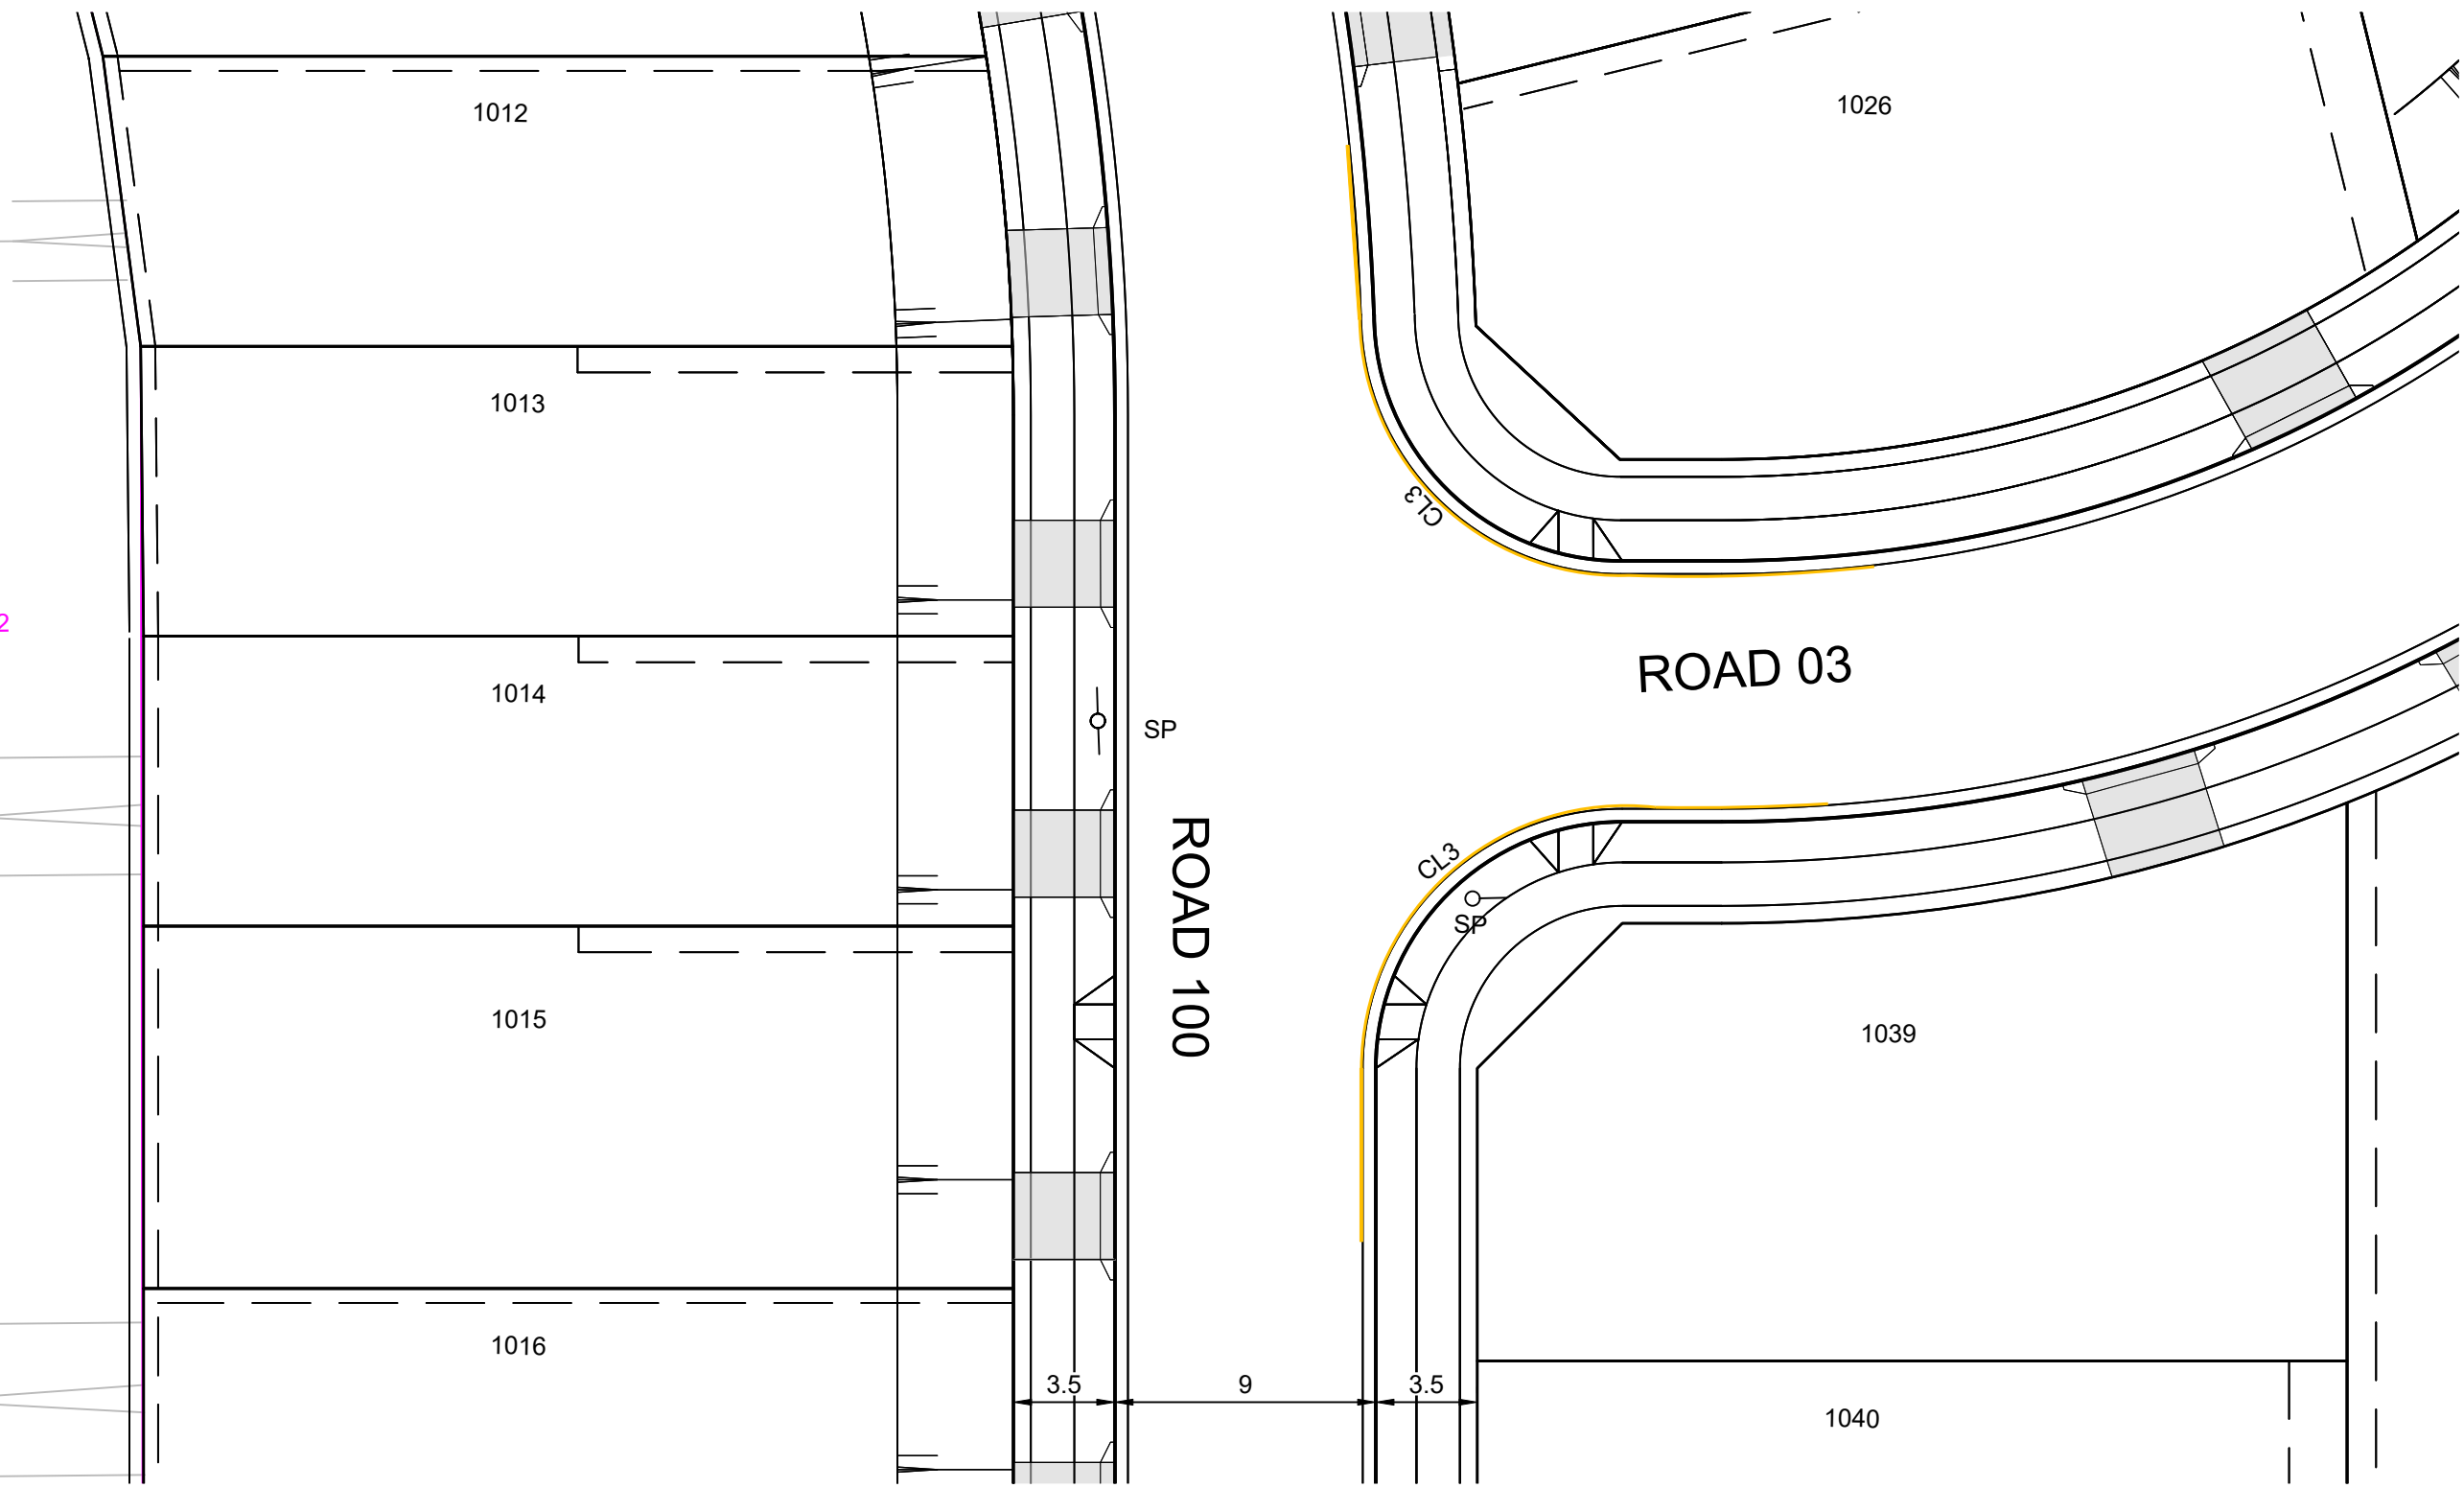

SEE DD1651 FOR CONTINUATION

PLAN
SCALE 1:250

PLAN
SCALE 1:250

PAVEMENT MARKING SCHEDULE

CODE	USE	STYLE	COLOUR & TYPE
BL2	Replaces dividing line if there is restricted sight distance for both directions, at approaches to a median island or at approaches to a pedestrian crossing.		white
GW	Give way line		white
C3	Kerbside linemarkings for No Stopping Restriction		Yellow

PAVEMENT MARKING & SIGNPOSTING NOTES

- ALL SIGNS TO BE IN ACCORDANCE WITH CURRENT AUSTRALIAN STANDARD AS 1743 - ROAD SIGNS, RMS SUPPLEMENTS AND COUNCIL'S SPECIFICATIONS UNLESS STATED OTHERWISE.
- ROAD SIGNS ARE SIZE 'A', UNLESS OTHERWISE SHOWN. LOCATE OUTSIDE OF CLEAR ZONES.
- ALL NEW PAVEMENT MARKINGS ARE TO BE INSTALLED IN WHITE REFLECTIVE, THERMOPLASTIC PAINT.
- RETRO-REFLECTIVE RAISED PAVEMENT MARKERS (RRPMs) ARE TO BE USED TO SUPPLEMENT PAVEMENT MARKINGS FOR INCREASED EFFECTIVENESS.
- ALL MEASUREMENTS ARE IN METRES UNLESS SHOWN OTHERWISE. NO INFORMATION IS TO BE SCALED FROM THESE DRAWINGS.
- EXISTING SPEED LIMIT TO BE MAINTAINED, NEW SIGNS TO BE ERECTED.
- STREET NAME SIGN LOCATION AS PER PENRITH CITY COUNCIL DRAWING No. SD1006/1

RHCO RICHARD HOGAN & CO.
SURVEYING & DEVELOPMENT CONSULTANTS


LEGEND	
	NEW SIGN POST
	STREET SIGN

WORKS AS EXECUTED AS SHOWN IN RED
NAME: - CRAIG S LONARD
SIGNATURE: *Craig S Lonard*
CAPACITY: - REGISTERED SURVEYOR #8800
DATE: 17.04.2025
CONTACT: ADMIN@HOGANCO.COM.AU

SIGNAGE AND LINE MARKING
SUBJECT TO SEPARATE
APPROVAL BY COUNCIL'S
LOCAL TRAFFIC COMMITTEE

THESE SIGNAGE AND LINEMARKING
PLANS ARE SUBJECT TO APPROVAL
BY PENRITH CITY COUNCIL TRAFFIC
COMMITTEE

1:250 (AT A1)
1:500 (AT A3)

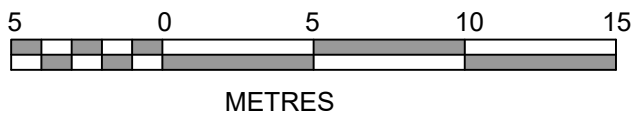

C	FOR CONSTRUCTION	MMC	GA	MS	MS	27/09/24
B	ROAD LAYOUT, LEGEND, SIGNAGE & LINEMARKING UPDATED	MMC	GA	DG	CR	12/09/24
A	ISSUE FOR TENDER	MMC	GA	MS		10/04/24
	AMENDMENT	DES	DRN	CKD	APR	DATE

J. WYNDHAM PRINCE
CONSULTING CIVIL INFRASTRUCTURE ENGINEERS & PROJECT MANAGERS

PO Box 4366 PENRITH WESTFIELD NSW 2750
P 02 4720 3300 W www.jwprince.com.au E jwp@jwprince.com.au

CLIENT:

LEGACYPROPERTY

STATUS:
**ISSUE FOR
CONSTRUCTION**

THIS DRAWING MUST NOT BE USED FOR CONSTRUCTION UNLESS
SIGNED AS PART OF AN APPROVED CONSTRUCTION CERTIFICATE.

ORCHARD HILLS NORTH
STAGE 1 CADDENS ROAD
SIGNAGE & LINEMARKING PLAN
SHEET 1



AZIMUTH: M.G.A. 2020 DATUM: A.H.D. ORIGIN: SSM 1112 PLAN No: 110265-09-DD1650

PROJECT No:
110265-09
SHEET No:
DD1650

C

Plotted: 11 November, 2024 10:47:45 AM File Name: C:\Synergy\WS\data\AS\WP07110265-09_Precinct 1 Development_135333\Design\DD\Stage 1 SWC\110265-09-DD1650.dwg

SEE DD1650 FOR CONTINUATION

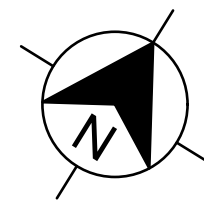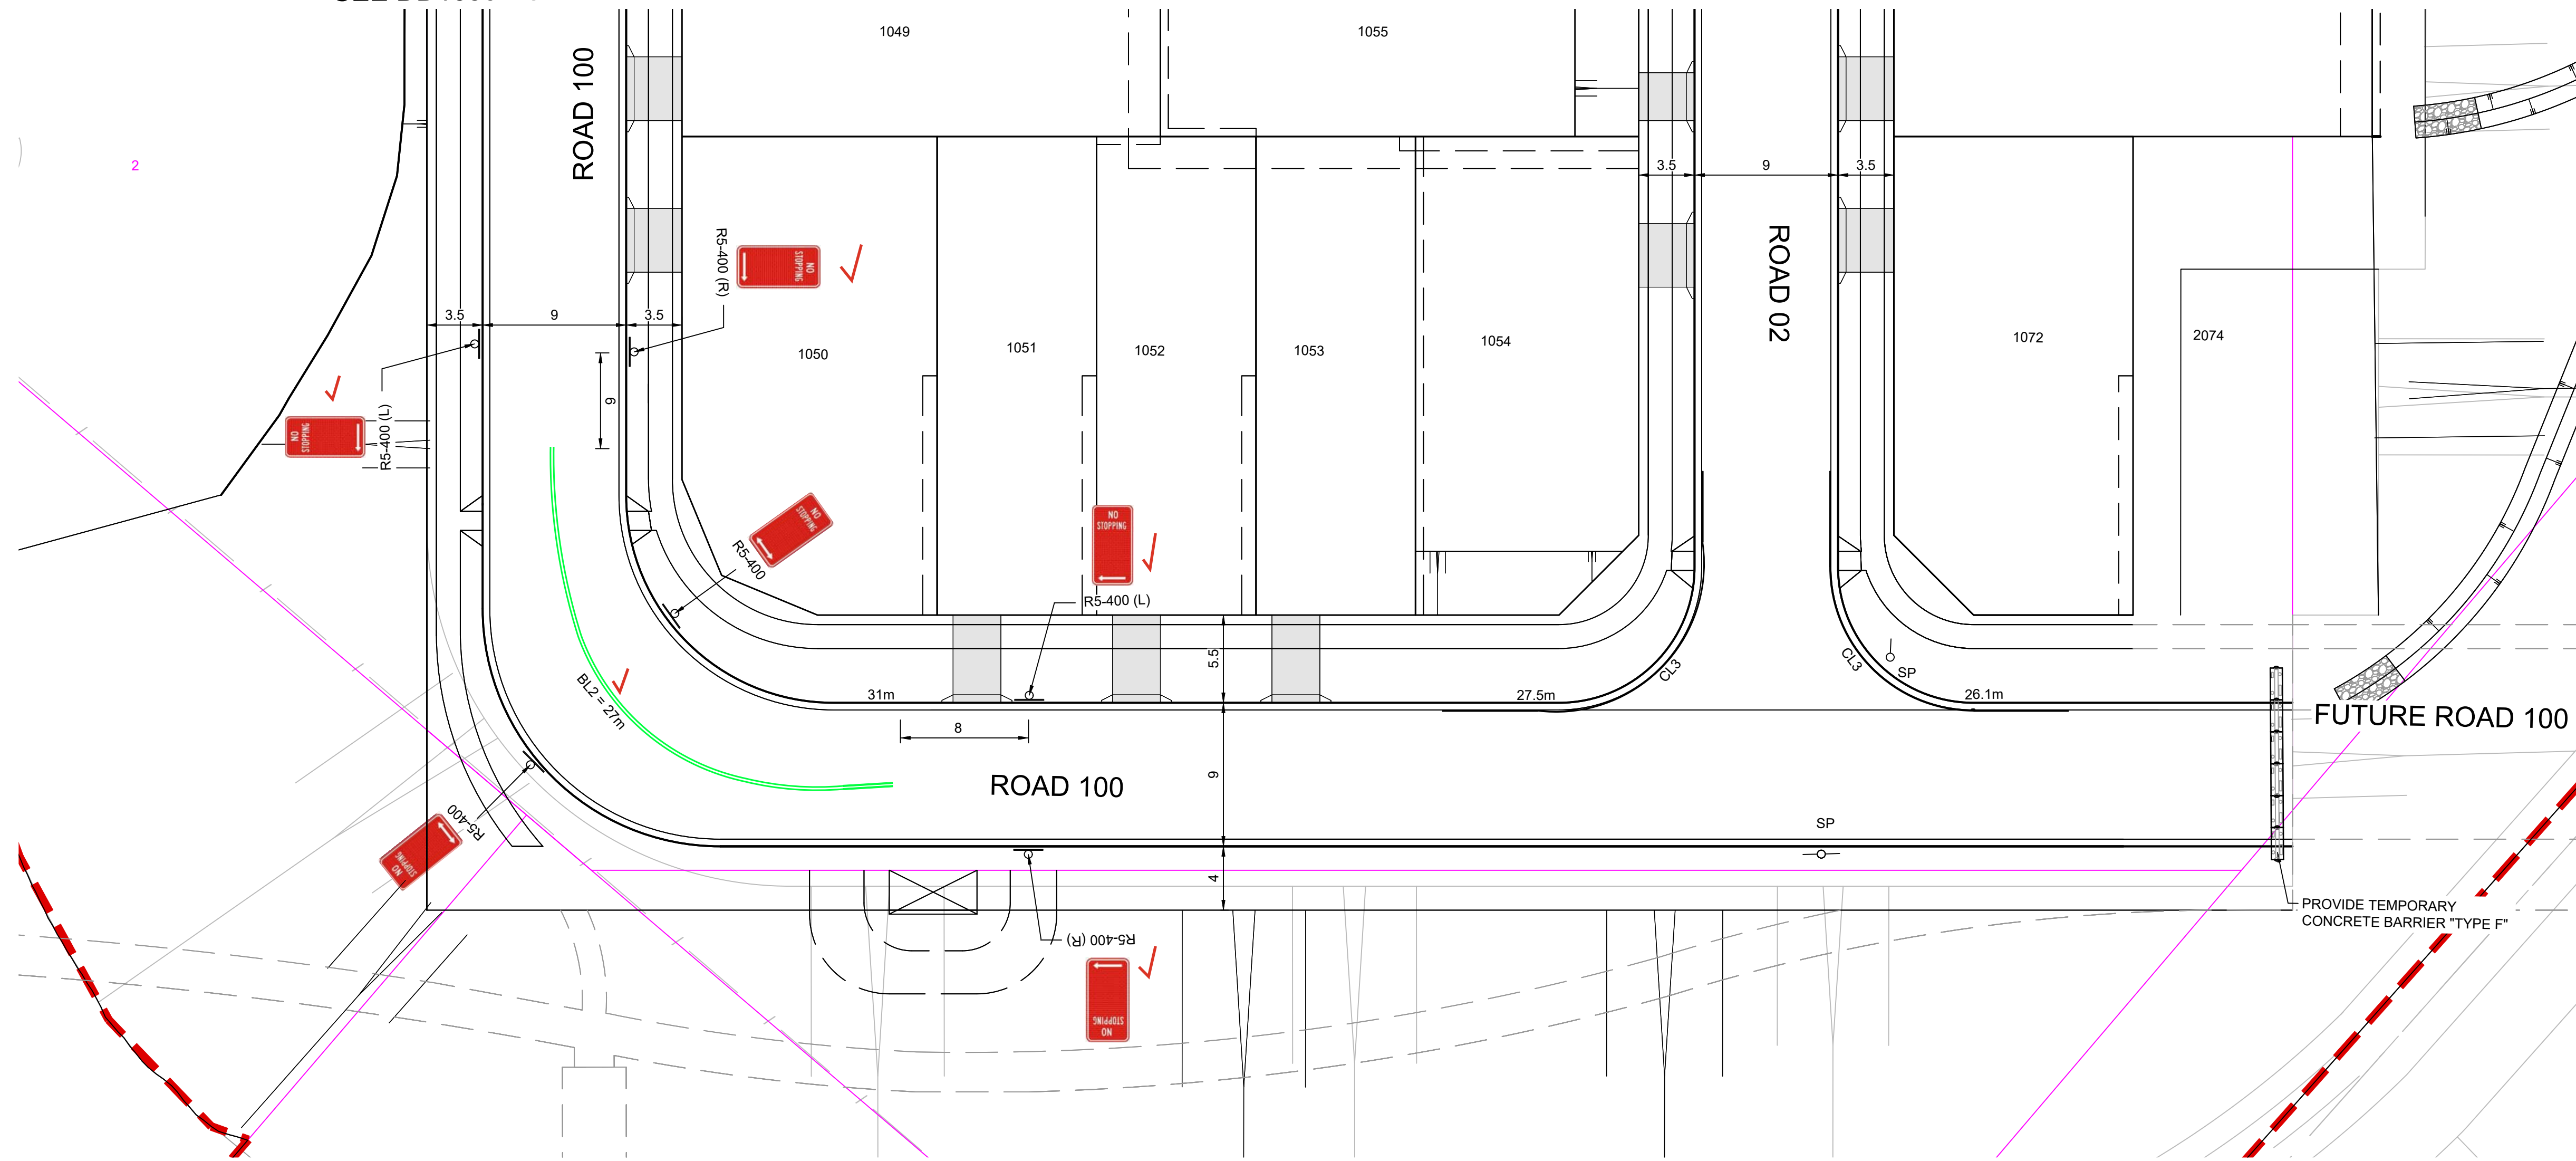

PLAN
SCALE 1:250

PAVEMENT MARKING & SIGNPOSTING NOTES

- ALL SIGNS TO BE IN ACCORDANCE WITH CURRENT AUSTRALIAN STANDARD AS 1743 - ROAD SIGNS, RMS SUPPLEMENTS AND COUNCIL'S SPECIFICATIONS UNLESS STATED OTHERWISE.
- ROAD SIGNS ARE SIZE 'A', UNLESS OTHERWISE SHOWN. LOCATE OUTSIDE OF CLEAR ZONES.
- ALL NEW PAVEMENT MARKINGS ARE TO BE INSTALLED IN WHITE REFLECTIVE, THERMOPLASTIC PAINT.
- RETRO-REFLECTIVE RAISED PAVEMENT MARKERS (RRPMs) ARE TO BE USED TO SUPPLEMENT PAVEMENT MARKINGS FOR INCREASED EFFECTIVENESS.
- ALL MEASUREMENTS ARE IN METRES UNLESS SHOWN OTHERWISE. NO INFORMATION IS TO BE SCALED FROM THESE DRAWINGS.
- EXISTING SPEED LIMIT TO BE MAINTAINED, NEW SIGNS TO BE ERECTED.
- STREET NAME SIGN LOCATION AS PER PENRITH CITY COUNCIL DRAWING No. SD1006/1

PAVEMENT MARKING SCHEDULE

CODE	USE	STYLE	COLOUR & TYPE
BL2	Replaces dividing line if there is restricted sight distance for both directions, at approaches to a median island or at approaches to a pedestrian crossing.		white
GW	Give way line		white
C3	Kerbside linemarkings for No Stopping Restriction		Yellow

LEGEND

	NEW SIGN POST
	STREET SIGN

THESE SIGNAGE AND LINEMARKING PLANS ARE SUBJECT TO APPROVAL BY PENRITH CITY COUNCIL TRAFFIC COMMITTEE

WORKS AS EXECUTED AS SHOWN IN RED
NAME: - CRAIG S LONARD
SIGNATURE:
CAPACITY: - REGISTERED SURVEYOR #8800
DATE: 17.04.2025
CONTACT: ADMIN@HOGANCO.COM.AU

SIGNAGE AND LINE MARKING
SUBJECT TO SEPARATE
APPROVAL BY COUNCIL'S
LOCAL TRAFFIC COMMITTEE

RHCO RICHARD HOGAN & CO.
SURVEYING & DEVELOPMENT CONSULTANTS

1:250 (AT A1)
1:500 (AT A3)

5 0 5 10 15
METRES

C	FOR CONSTRUCTION	MMC	GA	MS	MS	27/09/24
B	ROAD LAYOUT, LEGEND, SIGNAGE & LINEMARKING UPDATED	MMC	GA	DG	CR	12/09/24
A	ISSUE FOR TENDER	MMC	GA	MS		10/04/24
	AMENDMENT	DES	DRN	CKD	APR	DATE

J. WYNDHAM PRINCE
CONSULTING CIVIL INFRASTRUCTURE ENGINEERS & PROJECT MANAGERS

PO Box 4366 PENRITH WESTFIELD NSW 2750
P 02 4720 3300 W www.jwprince.com.au E jwp@jwprince.com.au

CLIENT:



STATUS:

**ISSUE FOR
CONSTRUCTION**

THIS DRAWING MUST NOT BE USED FOR CONSTRUCTION UNLESS
SIGNED AS PART OF AN APPROVED CONSTRUCTION CERTIFICATE.

ORCHARD HILLS NORTH
STAGE 1 CADDENS ROAD
SIGNAGE & LINEMARKING PLAN
SHEET 2

PROJECT No:

110265-09

SHEET No:

DD1651

AZIMUTH:

M.G.A.
2020

DATUM: A.H.D.

ORIGIN: SSM 1112

PLAN No:

110265-09-DD1651

C